



*** Hot Lab Hood**

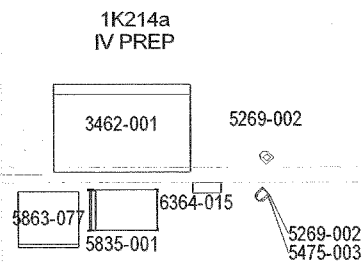

1KC02
CORRIDOR

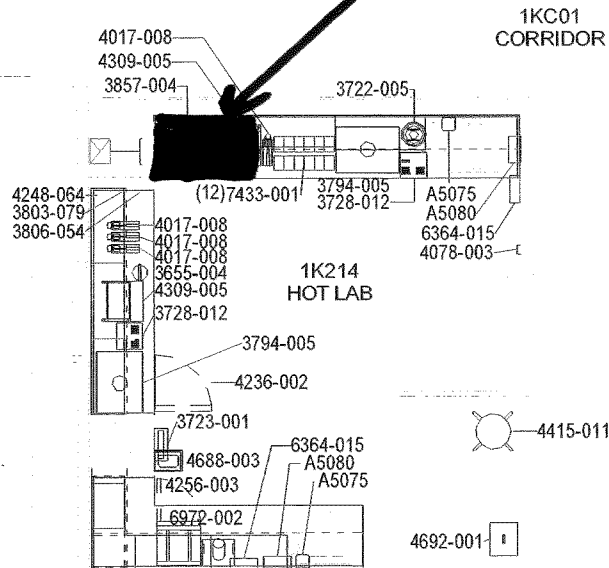