

GENERAL NOTES:

SECURITY – BOSCH WIRELESS SECURITY DUESS SYSTEM: TRANSPONDER TO BE FIELD LOCATED THROUGH OUT THE BUILDING.  
A. SYSTEM WILL CONSIST OF A LOCAL TRANSPONDERS WITH BATTERY BACK-UP; WIRED ANTENNA RECEIVERS LOCATED THROUGHOUT THE BUILDING TO PROVIDE COMPLETE COVERAGE; (20) NECK LANYARD TYPE WIRELESS TRANSMITTERS; INSTALLATION DRAWINGS, PROGRAMMING AND CHECK-OUT; DISPLAY AND MONITORING OF BLDG 102 AT THE POLICE DISPATCH IN BUILDING 111 TO EXISTING DISPLAY EQUIPMENT THROUGH PHONE LINE CONNECTION.  
B. THIS WILL REQUIRE (2) PAIR OF DEDICATED PHONE WIRES. PROVIDE 120-VOLT POWER TO EACH TRANSPONDER LOCATION.

SHEET NOTES:

- PROVIDE NEW FA CONTROL MODULES AND MONITOR MODULES TO INTERFERE NEW ELEVATOR DISCONNECT (BUSS MAIN POWER MODULE) WITH FIRE ALARM SYSTEM. MODULES SHALL BE PROVIDED AS FOLLOWS:
- CM: MAIN FLOOR RECALL
  - CM: ALTERNATE FLOOR RECALL
  - CM: ELEVATOR FIREMANS HAT SIGNAL
  - MM: ELEVATOR SHUNT TRIP POWER SIGNAL
  - MM: ELEVATOR SHUNT TRIP VOLTAGE
- ② TELECOMMUNICATIONS GROUND BAR PANDUIT GB2B0306TPI-1 OR APPROVED EQUAL. REFER TO DETAIL 8/E503 FOR FURTHER INFORMATION.
- ③ ETR FIBER-OPTIC CONDUIT PATHWAY FROM MANHOLE 20. GROUND AND BOND ALL CONDUCTIVE CABLING TO GROUND BAR WITHIN 50' OF ENTERING THE BUILDING PER NEC.
- ④ PROPOSED FIBER-OPTIC ROUTE FROM MANHOLE 20 TO TR B100FC.
- ⑤ PROVIDE (2) 4" CONDUITS INTENDED TO BE USED FOR TELECOMMUNICATIONS OUTSIDE PLANT CABLING. REFER TO SHEET E002 FOR CONTINUATION.
- ⑥ CONTROL MODULE PROVIDE FOR INTERFACE OF FIRE ALARM SYSTEM WITH TEMPERATURE CONTROL PANEL (TCP). CONTROL MODULE SHALL BE MOUNTED DIRECTLY ADJACENT TO RESPECTIVE TCP.
- ⑦ PENCCELL PULLBOX PE-36HD OR APPROVED EQUAL IN-LINE WITH (2) 4" CONDUITS. REPLACE ASPHALT TO ACCOMMODATE NEW PULLBOX.


ELECTRICAL SYMBOLS -SYSTEMS PLAN

- ◇ DETECTOR, FLOW SWITCH
- ◇ ALARM, TAMPER SWITCH
- ◇ ALARM, FIRE, MANUAL PULL STATION: MOUNTED 48" AFF
- MM FIRE ALARM MONITOR MODULE
- CM FIRE ALARM MONITOR MODULE
- PAGING SPEAKER – REFER TO SHEET E705 FOR FURTHER INFORMATION.
- ◇ ALARM, SPEAKER/STROBE, ONE ASSEMBLY
- ◇ DETECTOR; LETTER INDICATES AS FOLLOWS:  
BLANK = SMOKE DETECTOR  
H = HEAT SMOKE  
ER = ELEVATOR RECALL

ALL CHANGES ARE PART OF AMENDMENT 2 DATED 5/28/2013.

FULLY SPRINKLED  
FINAL CONSTRUCTION DOCUMENTS

Amendment No. 1	05/24/13
Revisions:	Date

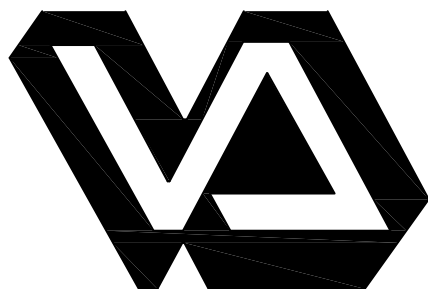

Dept. of Veterans Affairs  
Medical Center  
5000 W. National Avenue  
Milwaukee, WI




CONSULTANTS:

ARNOLD AND  
O'SHERIDAN INC  
CONSULTING ENGINEERS  
MADISON, WISCONSIN  
(608) 837-4800  
BROOKFIELD, WISCONSIN  
(262) 763-8130  
WWW.ARNOLDANDOSHERIDAN.COM

PROJECT  
NUMBER  
111201

PROJECT LEADER/STRUCTURAL ENGINEER:

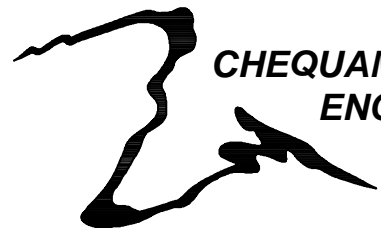

ASHLAND, WI  
211 6TH STREET WEST  
ASHLAND, WI 54806  
PHONE: (715) 682-6004  
FAX: (715) 682-6025  
MILWAUKEE, WI  
933 N. MAYFAIR RD.  
SUITE 100  
MILWAUKEE, WI 53208  
PHONE: (414) 238-6004  
FAX: (414) 238-6104

Drawing Title  
**BUILDING 102 - LOWER  
LEVEL FLOOR PLAN -  
SYSTEMS**

Approved: Project Director

Project Title  
**102 111 Expand SPS**

Location  
**VA Medical Center, Milwaukee, WI**

Date  
29 March 2013

Checked By:  
A+O

Drawn By:  
A+O

Project Number  
**695-13-131**  
Building Number  
**102**

Drawing Number  
**EY100**

Office of  
Facilities  
Management

