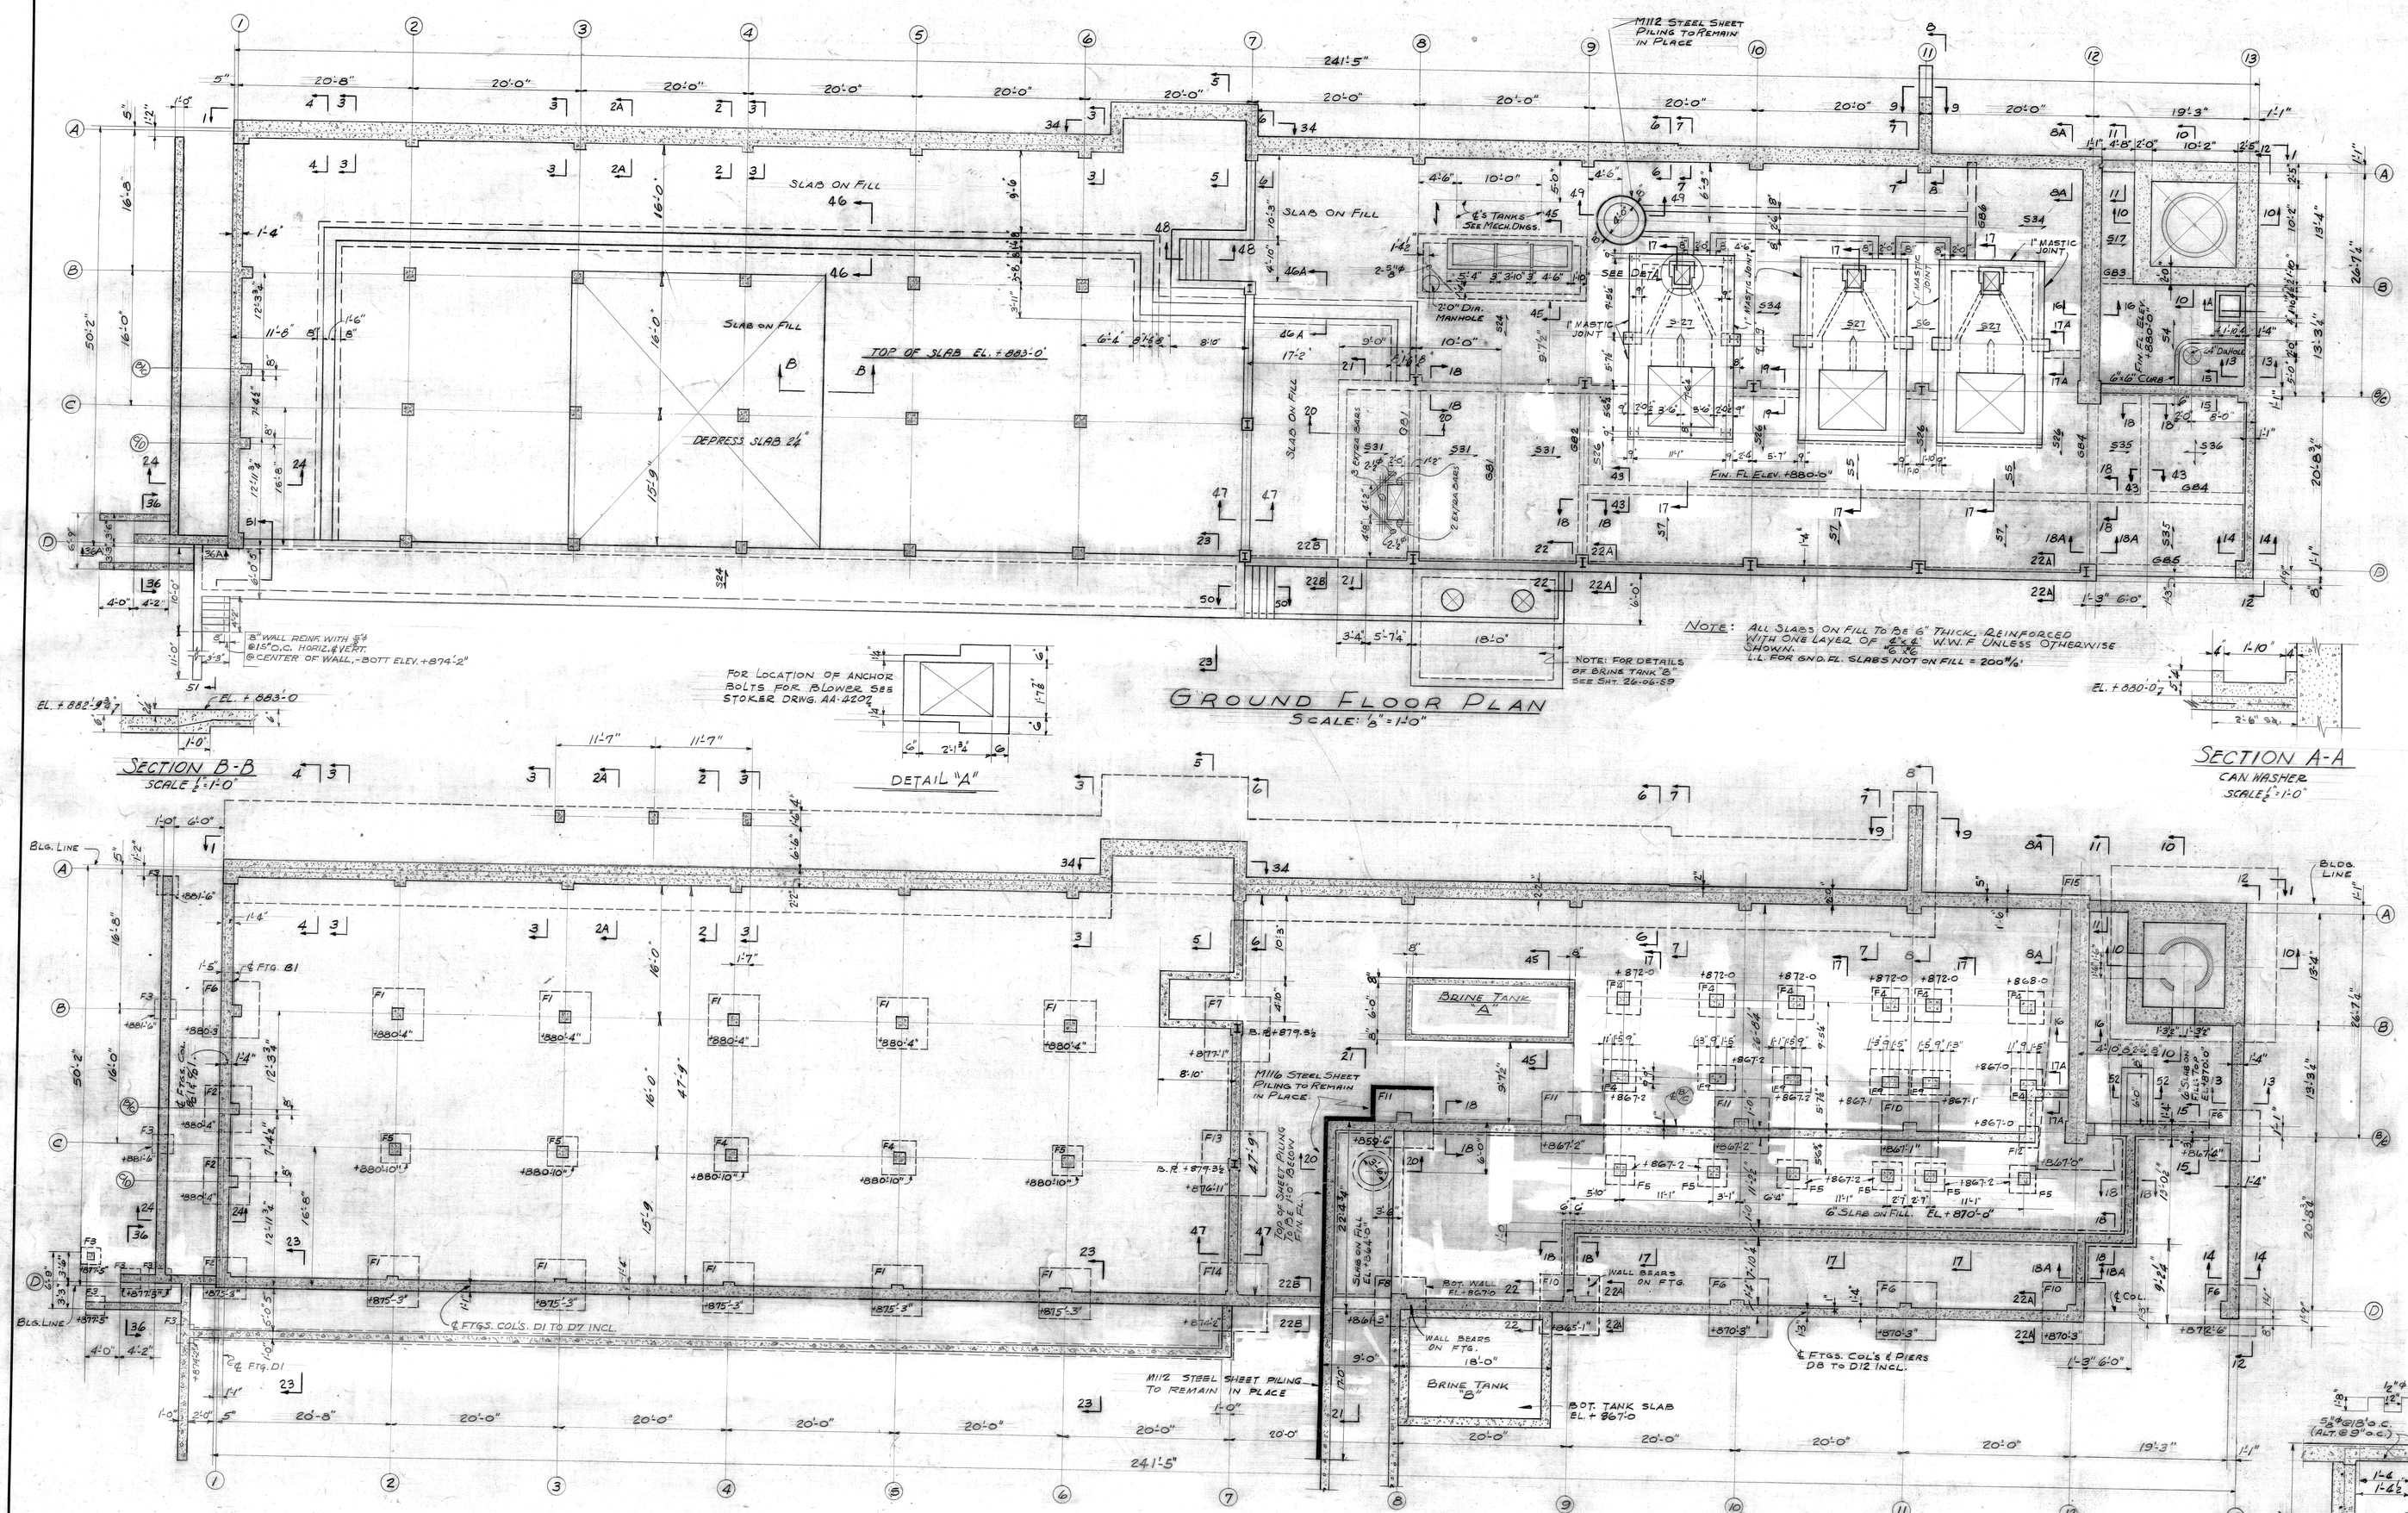

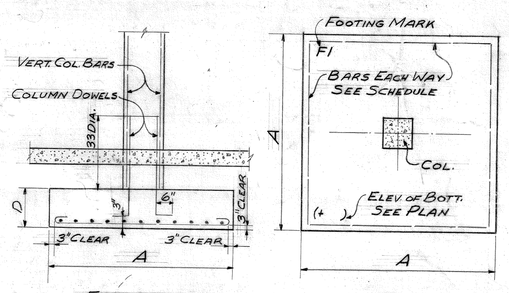

TYPICAL FOOTING DETAIL

FOOTING SCHEDULE

FOOTING MARK	SIZE A	SIZE D	BARS EACH WAY IN BOTTOM	REMARKS
F1	6'-0"x6'-0"	1'-8"	20-5/8"ϕ	
F2	5'-6"x5'-6"	1'-8"	17-5/8"ϕ	
F3	2'-3"x2'-3"	1'-1"	7-1/2"ϕ	
F4	4'-0"x4'-0"	1'-2"	17-1/2"ϕ	
F5	3'-6"x3'-6"	1'-2"	13-1/2"ϕ	
F6	6'-8"x6'-8"	1'-9"	25-5/8"ϕ	
F7	7'-8"x7'-8"	1'-11"	23-3/4"ϕ	
F8	6'-9"x6'-9"	1'-9"	22-5/8"ϕ	
F9	4'-6"x3'-6"	1'-2"	9-1/2"ϕ	
F10	7'-6"x7'-6"	1'-11"	23-3/4"ϕ	
F11	7'-0"x7'-0"	1'-10"	21-3/4"ϕ	
F12	2'-9"x2'-9"	1'-1"	8-1/2"ϕ	
F13	8'-4"x8'-4"	2'-1"	25-3/4"ϕ	
F14	8'-6"x8'-6"	2'-1"	26-3/4"ϕ	
F15	SEE DETAIL ON THIS SHEET.			

PIER SCHEDULE

COL. NO.	PIER SIZE	REINF.	TIES	DOWELS
BC8	26"x 26"	4-1 5/8□	3/8"ϕ @ 18" o.c.	4-1 5/8□
BC9	26"x 26"	4-1 5/8□	3/8"ϕ @ 18" o.c.	4-1 5/8□
BC10	26"x 26"	4-1 5/8□	3/8"ϕ @ 18" o.c.	4-1 5/8□
BC11	26"x 26"	4-1 5/8□	3/8"ϕ @ 18" o.c.	4-1 5/8□
BC13	26"x 26"	4-1 5/8□	3/8"ϕ @ 18" o.c.	4-1 5/8□
D7 D8	24"x 24"	4-1□	3/8"ϕ @ 16" o.c.	4-1□
D9	24"x 24"	4-1 5/8□	3/8"ϕ @ 18" o.c.	4-1 5/8□
D10	24"x 24"	4-1 5/8□	3/8"ϕ @ 18" o.c.	4-1 5/8□
D11	24"x 24"	4-1 5/8□	3/8"ϕ @ 18" o.c.	4-1 5/8□
D12	26"x 26"	4-1 1/4□	3/8"ϕ @ 18" o.c.	4-1 1/4□
D13	26"x 26"	4-1 5/8□	3/8"ϕ @ 18" o.c.	4-1 5/8□

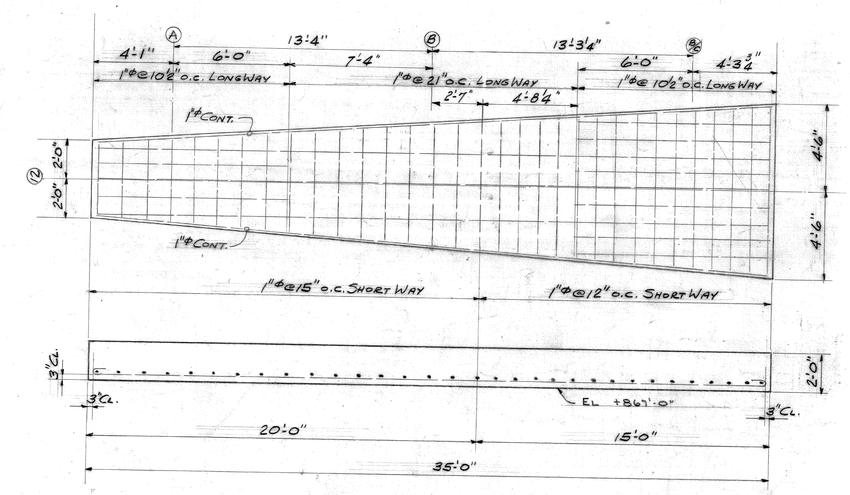

DETAIL OF COMBINED FOOTING F15
SCALE: 1/4" = 1'-0"
FOR SIZE AND LOCATION OF DOWELS SEE SEC. 16-16, SH. S-4

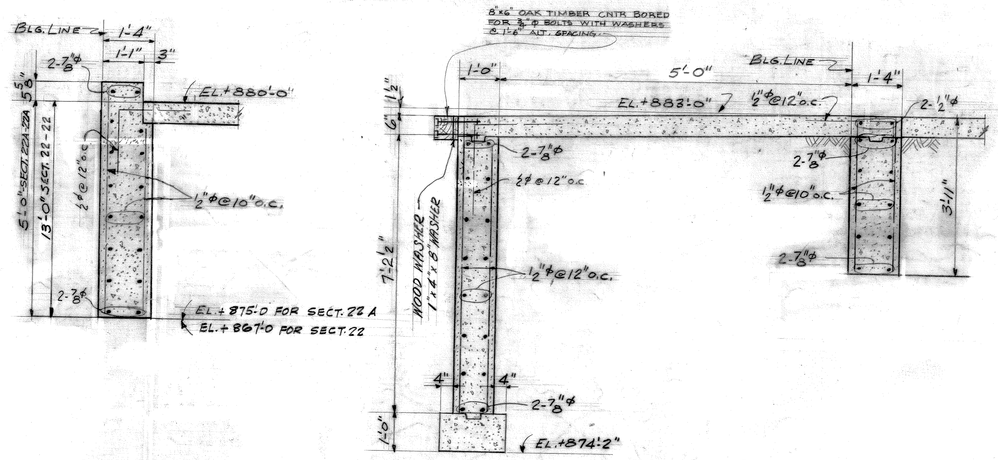

SECTION 22A-22A
SECTION 22-22 SIMILAR
SCALE: 1/4" = 1'-0"

SECTION 23-23
SCALE: 1/4" = 1'-0"

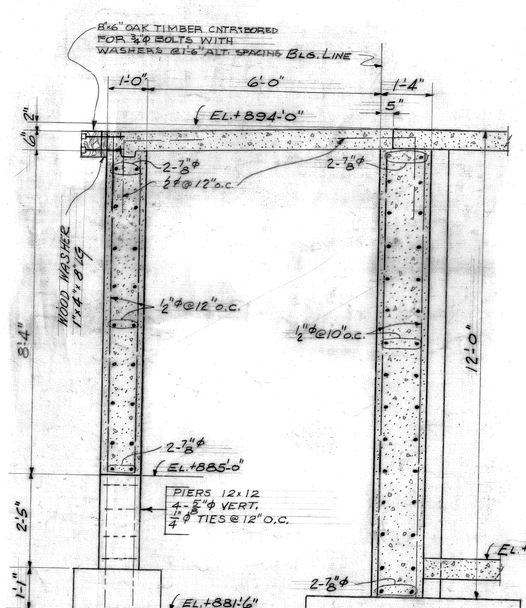

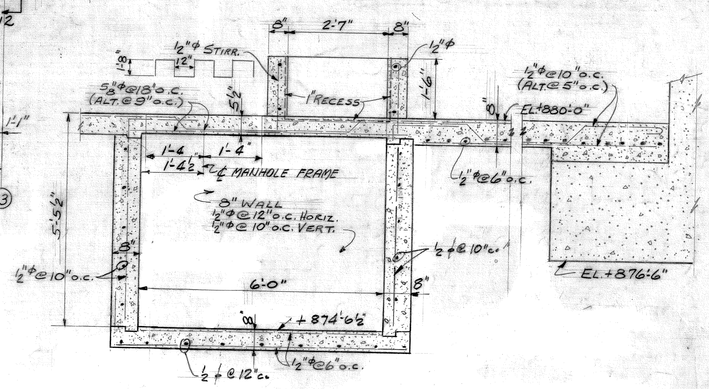

SECTION 45-45
SCALE: 1/2" = 1'-0"

NOTE: FOR SECT'S. 1 TO 7 INCL. -20-21, 34 SEE SHT. 26-06-53
FOR SECT'S. 8 TO 19 INCL. -36-46 TO 49 INCL. SEE SHT. 26-06-54
FOR SECT'S. 50-51-52 SEE SHT. 26-06-56
FOR SECT. 48 SEE SHT. 26-06-57

Bldg # 2

AS BUILT 11-23-51

REVISION	DATE	DESCRIPTION	BY
No. 7	31-OCT-49	FRAMING & FOOTINGS FOR BOILERS CHANGED	MPA
No. 4	6-SEP-49	DIM. CHANGED & ADDED BSMT., GR. FL. & SECT. 22A-22B	MPA
No. 3	3-JUNE-49	DIMENSIONS CHANGED - FDTN. & GND. FLOOR.	R.P.
No. 2	3-JUNE-49	SIDEWALK-CURBS-MH. OPENINGS OVER BRINE TANK "B" ADDED	R.P.

HOLABIRD & ROOT
ARCHITECTS ENGINEERS
CHICAGO, ILLINOIS

DEPARTMENT OF THE ARMY
CORPS OF ENGINEERS
ROCK ISLAND DISTRICT
ROCK ISLAND, ILL.

DRAWN BY: R. PADORR
TRACED BY: R. PADORR
CHECKED BY: G.W.S.
SUBMITTED: G.W.S.

VETERANS ADMINISTRATION HOSPITAL
MADISON, WISC.
500 BED T. B.
LAUNDRY, SHOPS & BOILER PLANT

3-2-1-1752