


1 Existing flooring to remain. Protect in place.

1 Existing flooring to remain. Protect in place.



Scale: 1/8" = 1'-0"

1	Addendum 2	05/29/2013
Revisions		Date

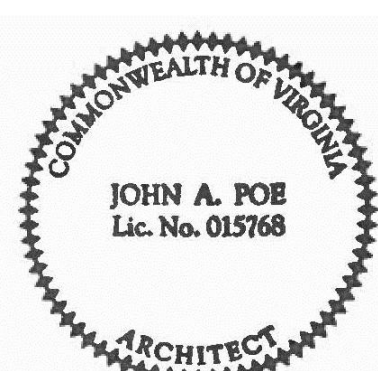

ARCHITECT/ENGINEERS:


937 461 3280 PHONE
937 461 0260 FAX
1-800-362-1523
jsa@johnpoe.com

FLOOR FINISH PLAN - AREA A

Building Number	Checked	Drawn
137	TH	KG

Location	Hampton, Va
----------	-------------

Date
05/03/2013

Project No.
590-911

RDC/JPA Project No. 11004.00

Drawing Number
137-A703

Dwg. 48 of 135

