

GENERAL FINISH PLAN NOTES

- A. See Sheet 137-A702 for Finish Materials Legend.
B. See Sheet 137-A701 for Room Finish Schedule.
C. See Interior Elevations on Sheet 137-A404, 137-A405, 137-A406 for further information.
D. See Sheet 137-A707 for floor transition details.
E. Where new flooring meets existing, provide floor transitions as required.
F. All gypsum board ceilings to be painted GWS-1 unless noted otherwise.
G. All hollow metal door frames to be painted P-2 unless noted otherwise.
H. All solid surface window sills to be SS-2.
J. Install glass tile, GT-1, on all 3 walls of all drinking fountain alcoves.


FINISH PLAN NOTES



1 FLOOR FINISH PLAN - AREA B

Scale: 1/8" = 1'-0"

Revisions	Addendum 2	Date
1		05/29/2013

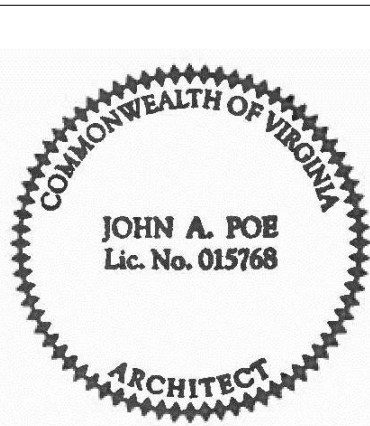

CONSULTANTS:

ARCHITECT/ENGINEERS:

RDC/JOHN POE ARCHITECTS

524 FERNWOOD DRIVE
ALTIMONTE SPRINGS, FLORIDA
32701
937 461 3290 PHONE
937 461 0260 FAX
1-800-362-1523
jpa@johnpoe.com

Drawing Title

FLOOR FINISH PLAN - AREA B

Approved: Project Director

Project Title
Hampton VA, VAMC
Renovate / Expand SCI, Phase II,
590-911

Building Number
137

Checked
TH

Drawn
KG

Location
Hampton, Va

Date
05/03/2013

Project No.
590-911

Drawing Number
137-A704

Dwg. 49 of 135

