ATTACHMENT - H
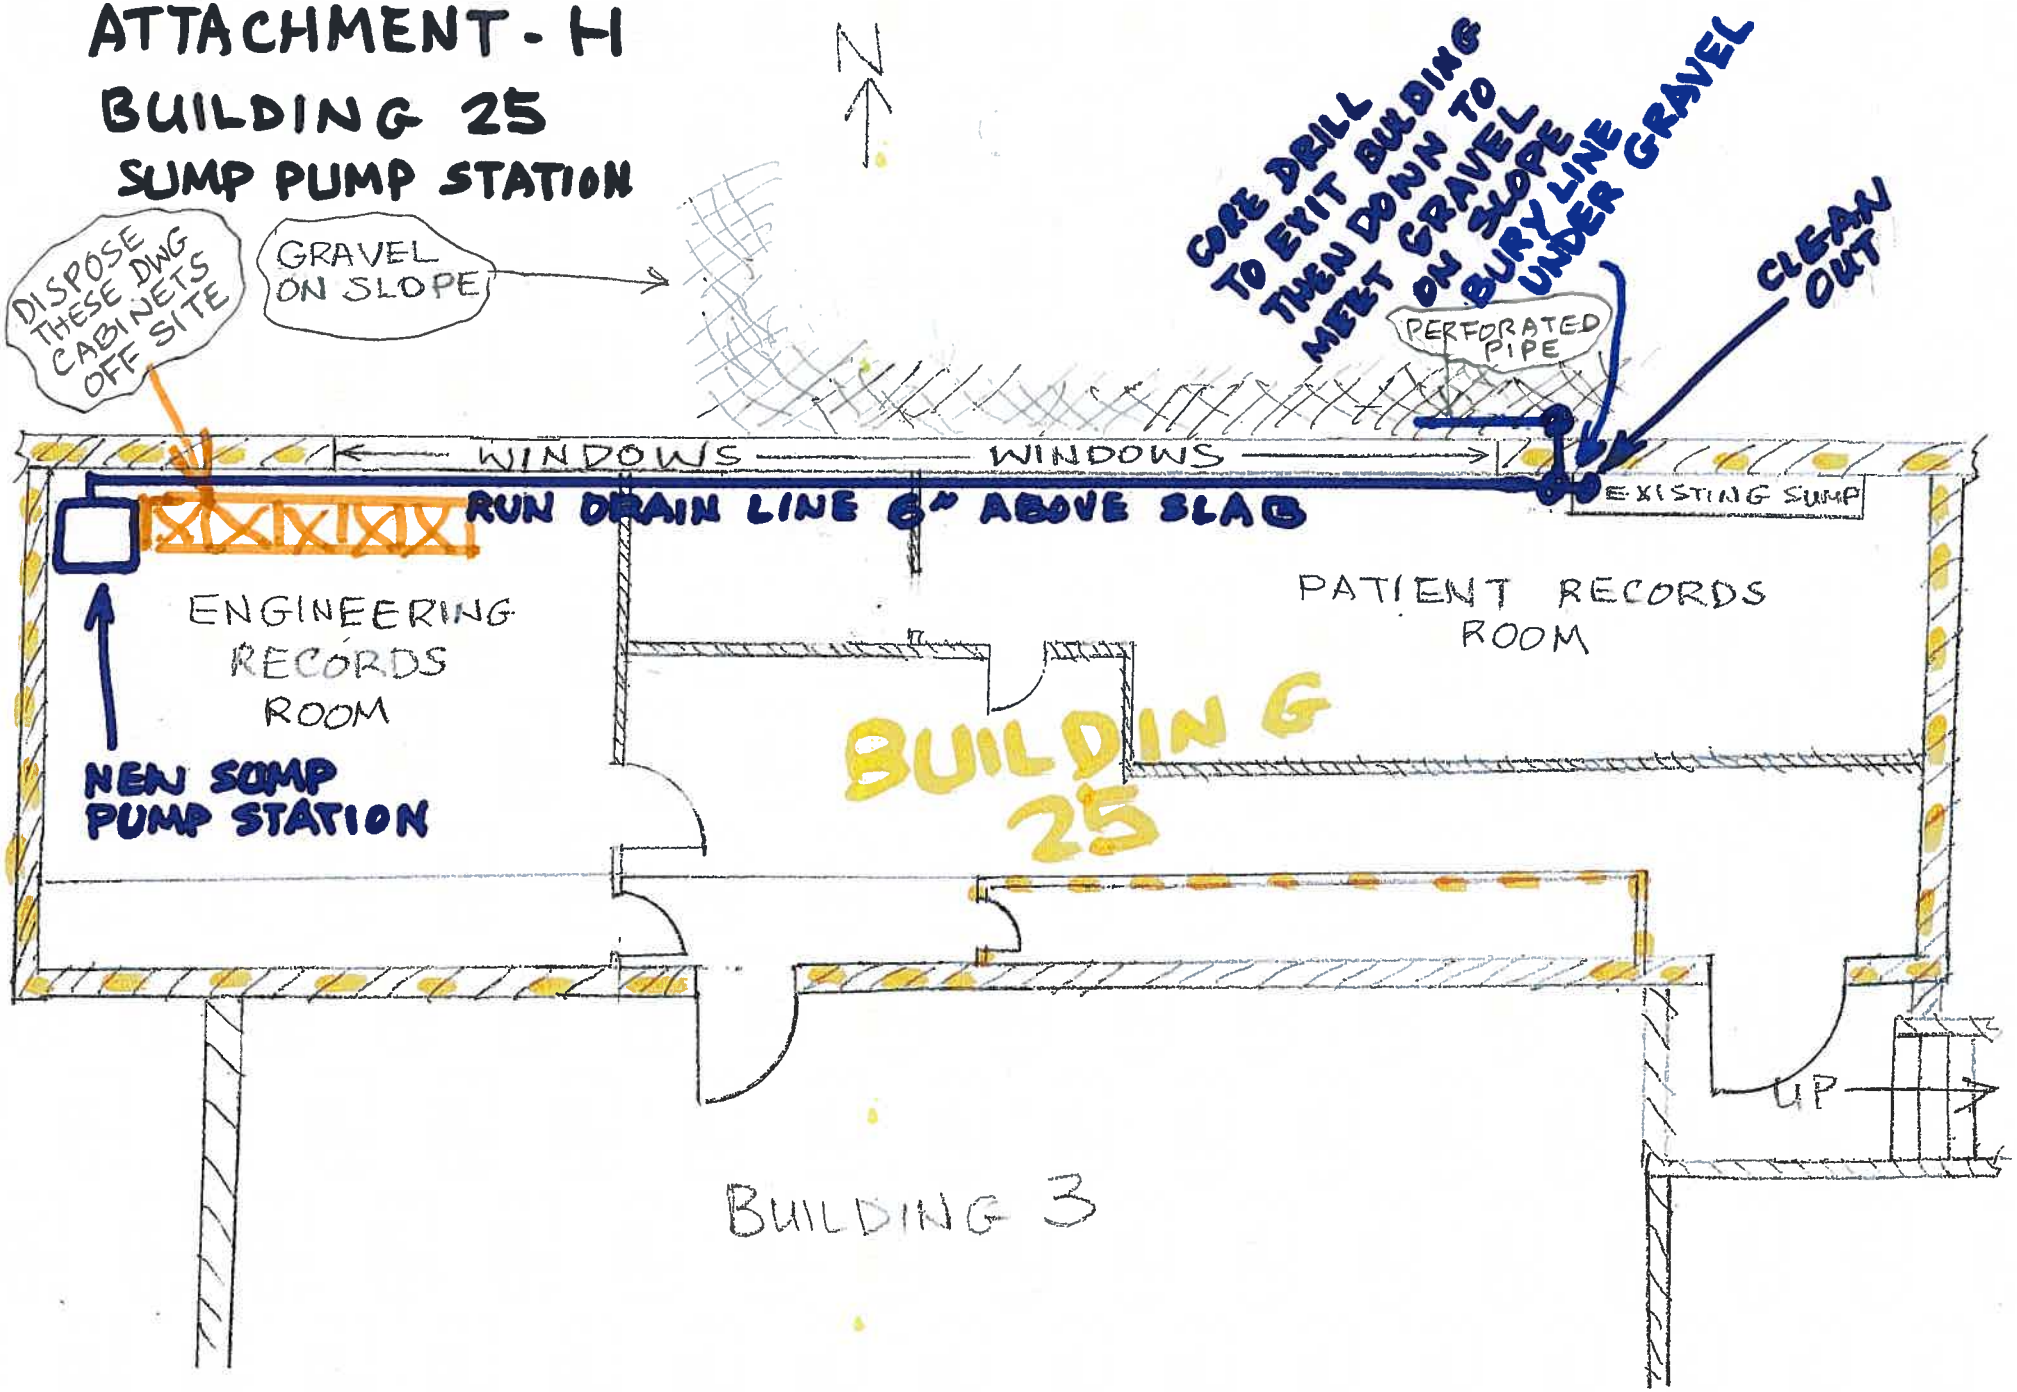
BUILDING 25
SUMP PUMP STATION