


ATTACHMENT - J
BUILDING 25 OVERFLOW DRAIN
PAGE 1

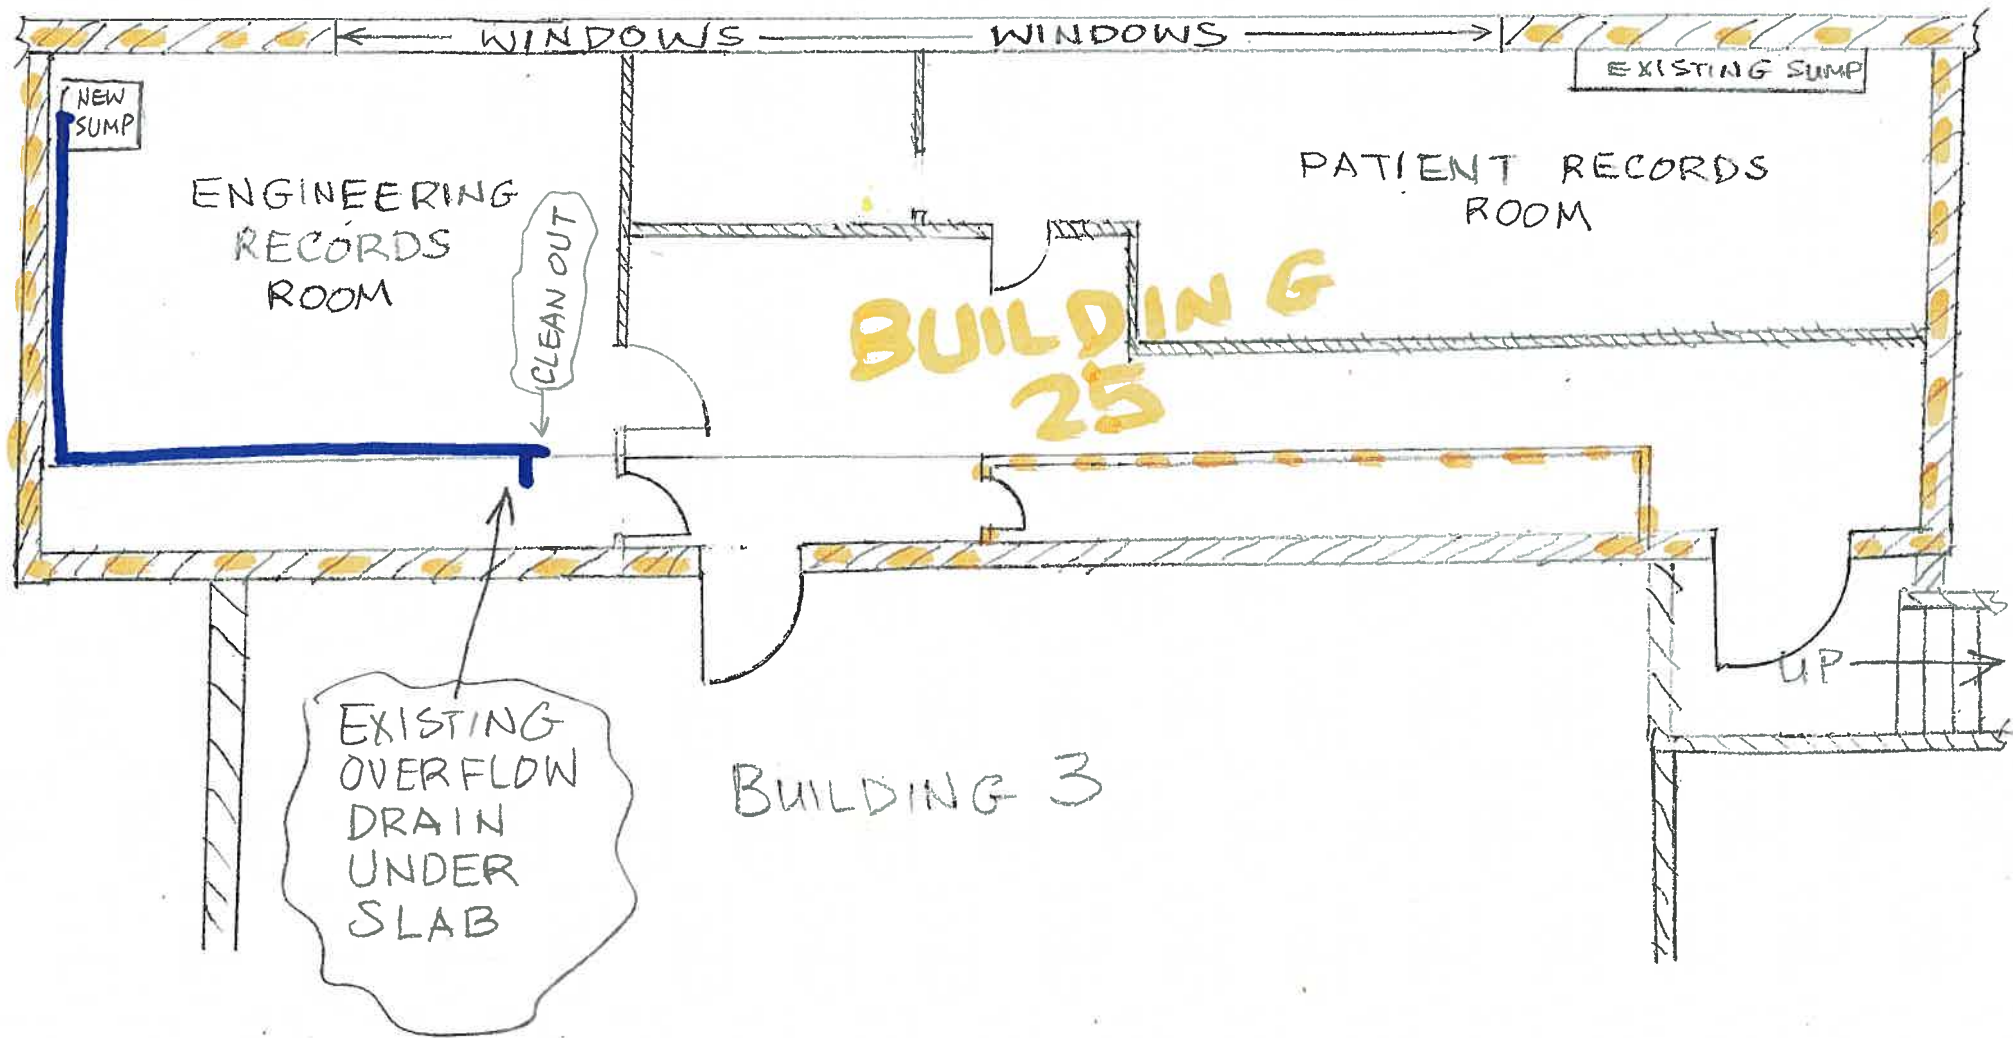

ATTACHMENT-J P.2
B-25 OVERFLOW DRAIN

EXPOSE
EXTEND
AND END
EXTEND
TO

