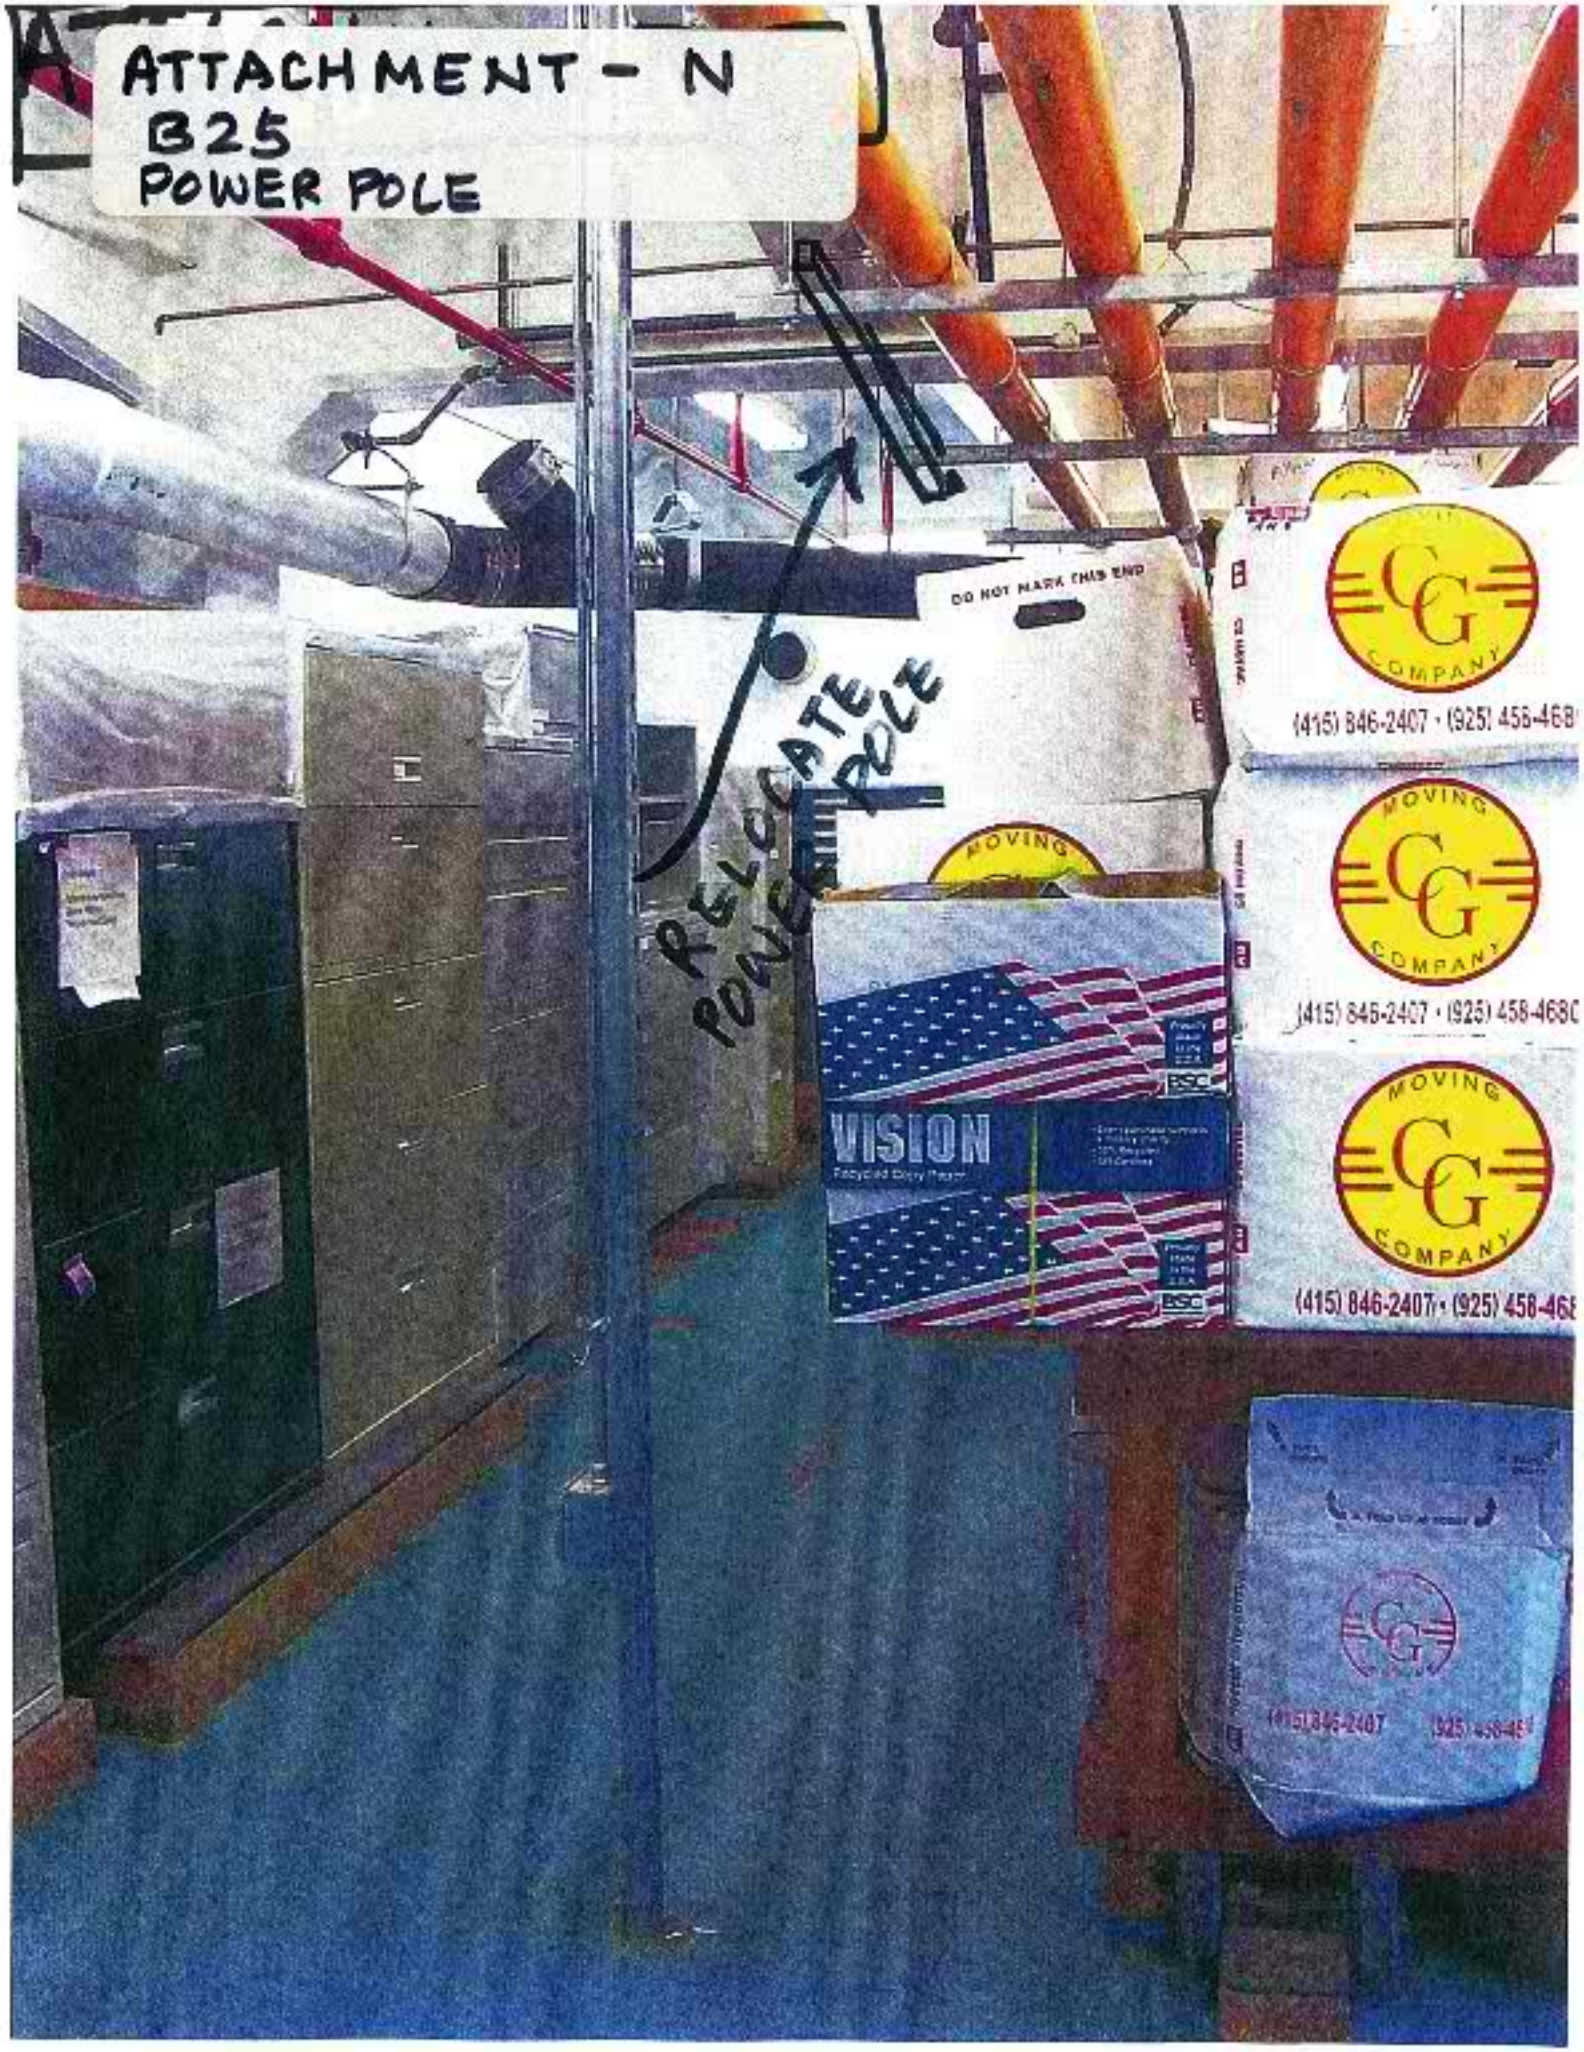
ATTACHMENT - N
B25
POWER POLE
RELOCATE POLE
DO NOT MARK THIS END
MOVING
CG
COMPANY
(415) 846-2407 · (925) 458-468
VISION