GENERAL NOTES:

A. SEE SHEET T101 GENERAL NOTES.

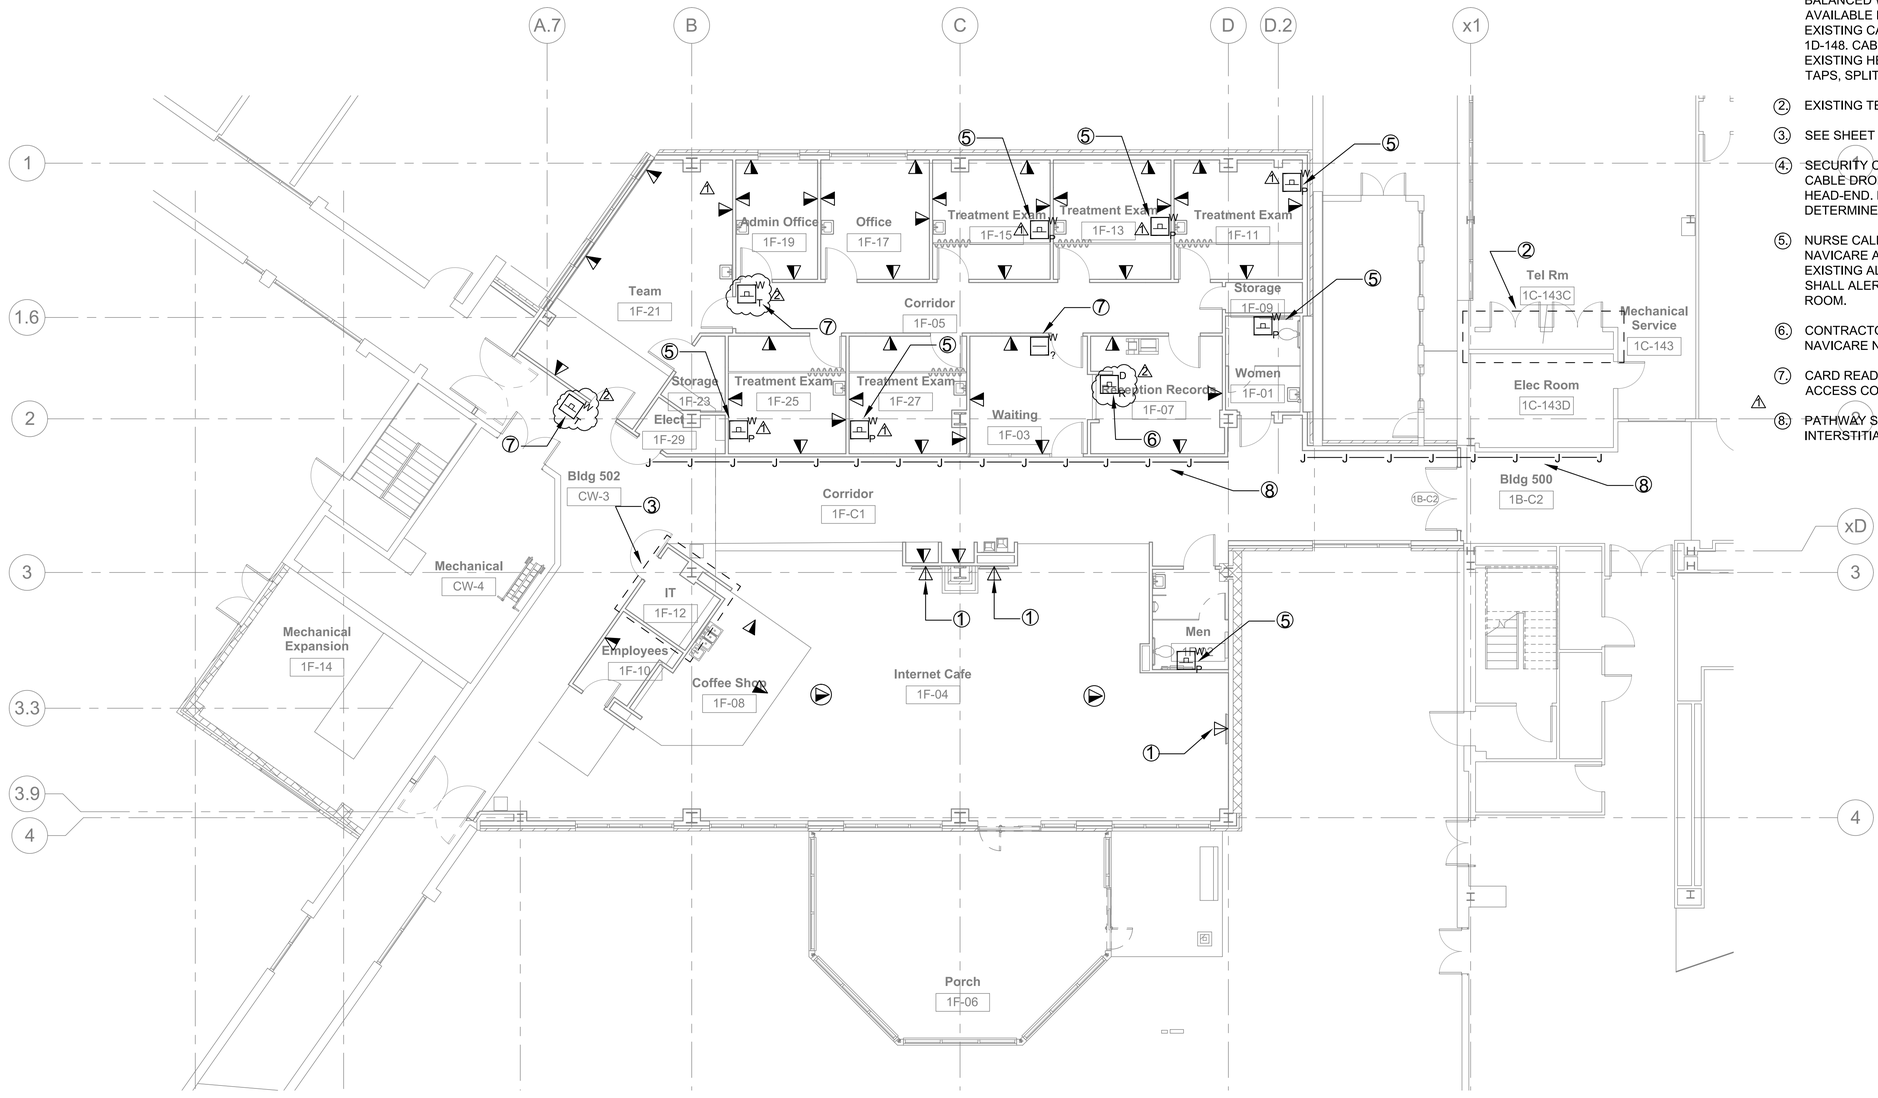

DRAWING NOTES:

1. CATV OUTLET SIGNAL DB LEVELS SHALL BE BALANCED WITH SUFFICIENT POWER FOR ALL AVAILABLE BROADCAST CHANNELS FROM THE EXISTING CATV HEAD-END IN BLDG 500 ROOM 1D-148. CABLING SHALL BE EXTENDED FROM EXISTING HEAD-END WITH ALL NECESSARY TAPS, SPLITTERS, AND LINE EXTENDERS.
2. EXISTING TELECOM ROOM
3. SEE SHEET T300 FOR LAYOUT.
4. SECURITY CAMERAS SHALL HAVE CAT 6 CABLE DROPS HOME RUN FROM SECURITY HEAD-END. DROP LOCATIONS TO BE DETERMINED.
5. NURSE CALL BUTTON SHALL BE HILLROM NAVICARE AND CONNECT VIA CONDUIT TO EXISTING ALERT SYSTEM. CALL BUTTON SHALL ALERT ADMIN DESK AND EMERGENCY ROOM.
6. CONTRACTOR SHALL PROVIDE AND INSTALL NAVICARE NURSE CONSOLE AT ADMIN DESK.
7. CARD READER SHALL CONNECT TO EXISTING ACCESS CONTROL SYSTEM.
8. PATHWAY SHALL BE INSTALLED IN INTERSTITIAL SPACE.

1 / T200 **1ST FLOOR PLAN - TELECOMM**
1/8" = 1'-0"

0' 4' 8' 16' 32' N

100% Bid Submission

Revisions	Date
1 ADDENDUM 1	04/26/13
2 ADDENDUM 2	06/03/13

CONSULTANTS

Geotechnical:
SCHNABEL ENGINEERING
1901 SOUTH MAIN ST
SUITE 11
BLACKSBURG, VA 24060

Civil and Structural:
ALPHA CORPORATION
150 S LOUDOUN ST
SUITE 200
WINCHESTER, VA 22601

Fire Protection:
KOFFEL ASSOCIATES, INC.
8815 CENTRE PARK DRIVE
SUITE 200
COLUMBIA, MD 21045-2107

Mechanical, Electrical, and Plumbing:
HENRY ADAMS
600 BALTIMORE AVENUE
BALTIMORE, MD 21204

Telecommunications:
USSI CONSULTING
10440 LITTLE PATUXENT PKWY
SUITE 300
COLUMBIA, MD 21044

Transportation:
ROBERT L SEYMOUR
182 THOMAS JOHNSON DR
FREDERICK, MD21702

ARCHITECTS

ERNEST BLAND ASSOCIATES, P.C.
TECHNICAL FACILITIES DESIGN
802 SLIGO AVENUE, SILVER SPRING, MARYLAND 20910
TELEPHONE (301) 589-4811 FAX (301) 589-3810

Drawing Title: 1st Floor Plan - Telecom

Approved: Project Director

Project Title: Construct Domiciliary Internet Cafe & Rehab Medicine Expansion

Location: Martinsburg, WV

Date: 16 April 2013

Checked: RS

Drawn: AWB

Project Number: 613-13-665

Building Number:

Drawing Number: T200

Department of Veterans Affairs