




D1 ENLARGED FLOOR PLAN - PEDIATRY
1/4" = 1'-0"

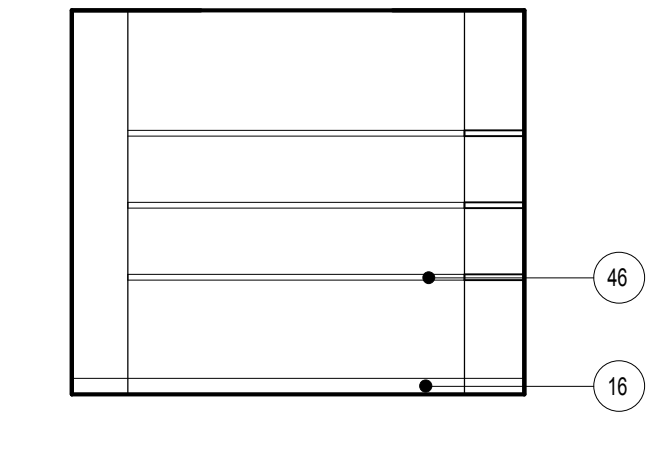


A6 PEDIATRY - PROSTHETICS # 2-415
1/4" = 1'-0"

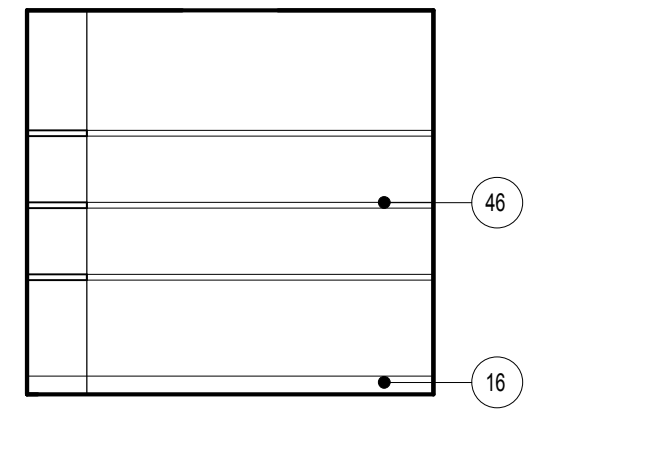


A7 PEDIATRY - PROSTHETICS B
1/4" = 1'-0"

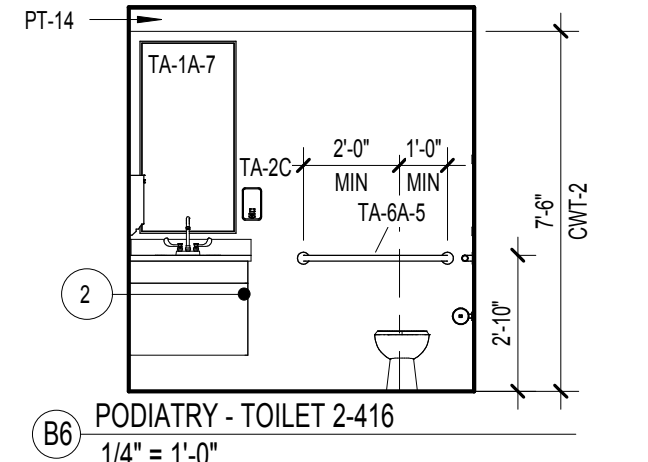


B6 PEDIATRY - TOILET # 2-416
1/4" = 1'-0"

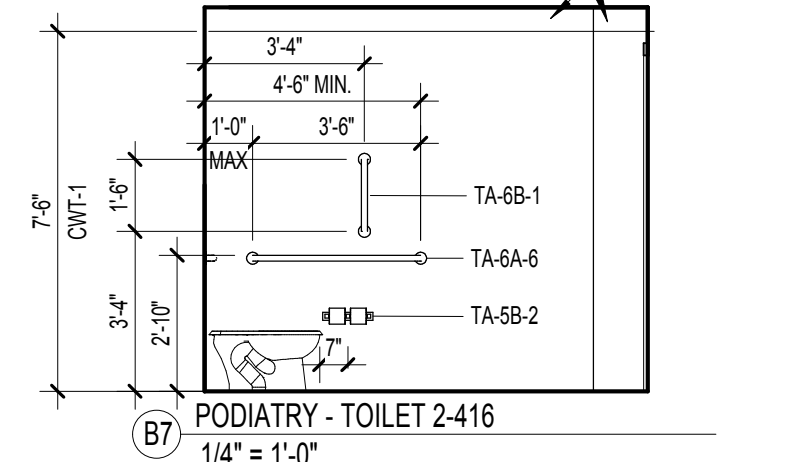


B7 PEDIATRY - TOILET # 2-416
1/4" = 1'-0"

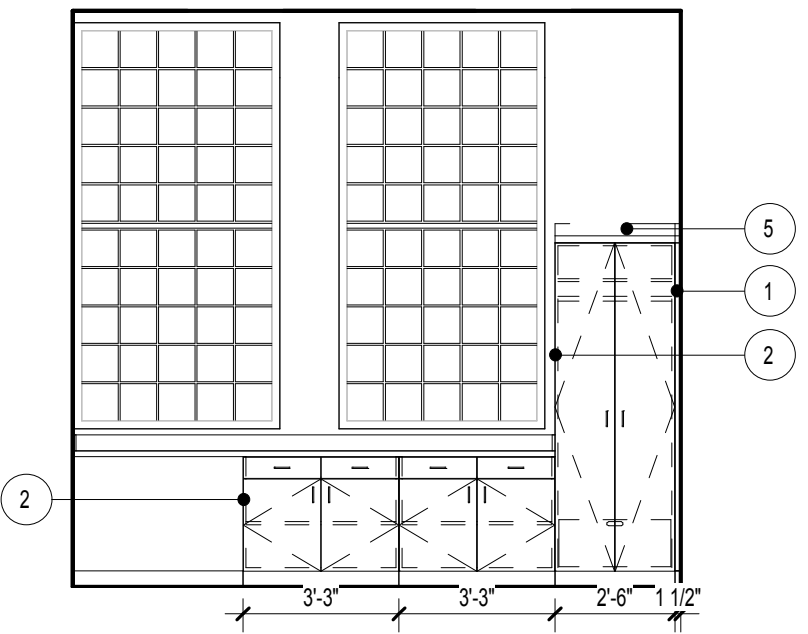


C6 PEDIATRY - WORK ROOM # 2-411
1/4" = 1'-0"

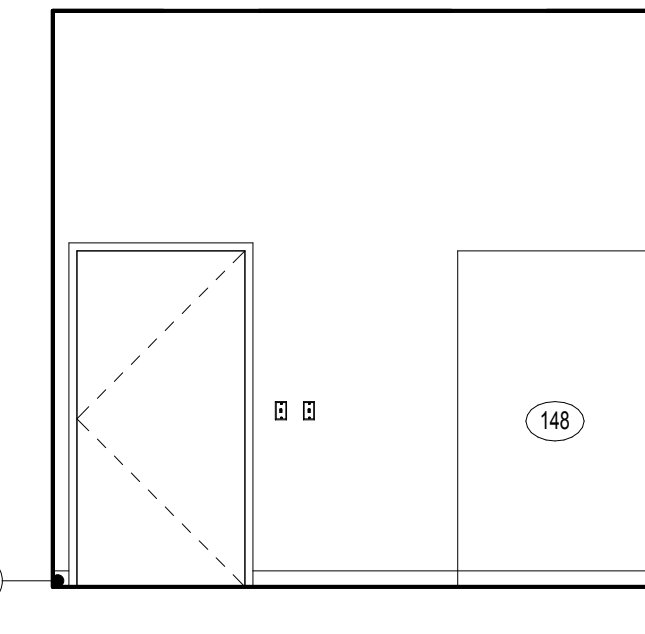


C7 PEDIATRY - WORK ROOM # 2-411
1/4" = 1'-0"

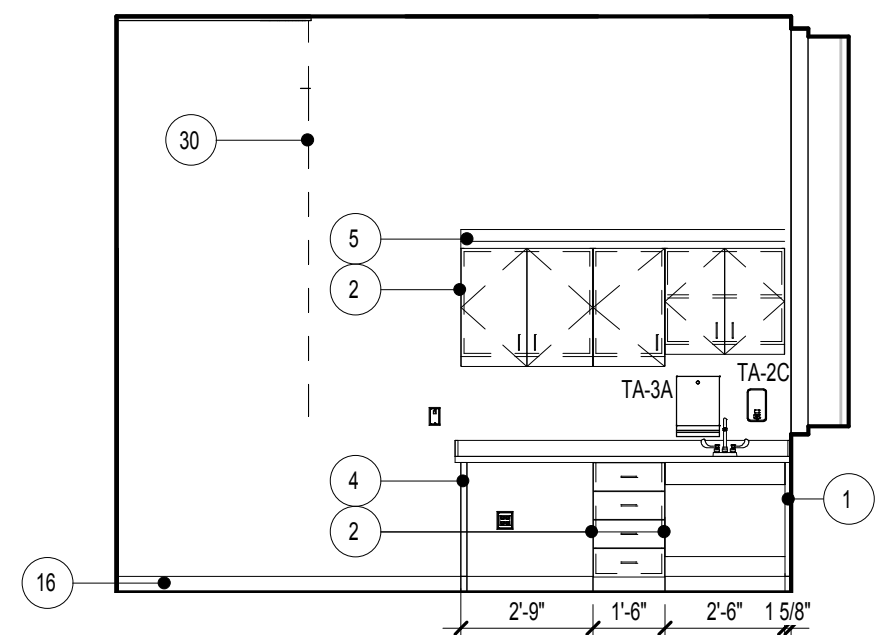

D3 PEDIATRY - TYPICAL PROCEDURE CASEWORK
1/4" = 1'-0"

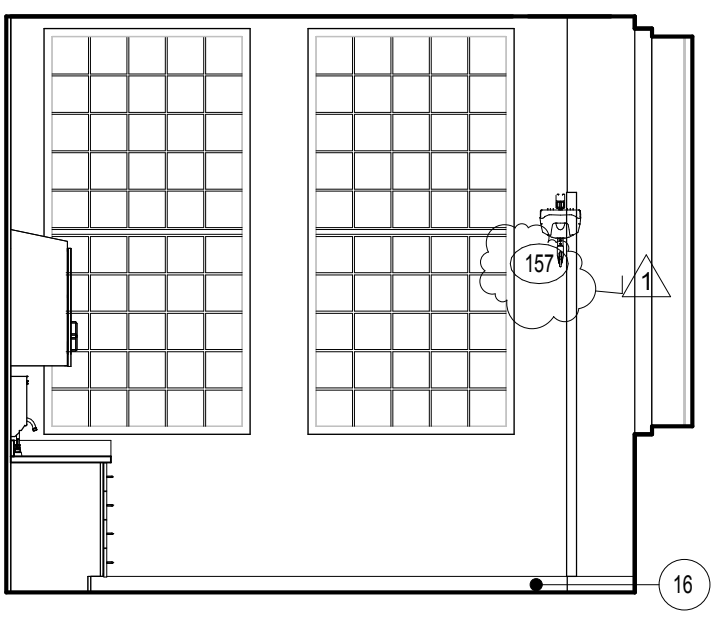

D4 PEDIATRY - PROCEDURE # 2-407
1/4" = 1'-0"

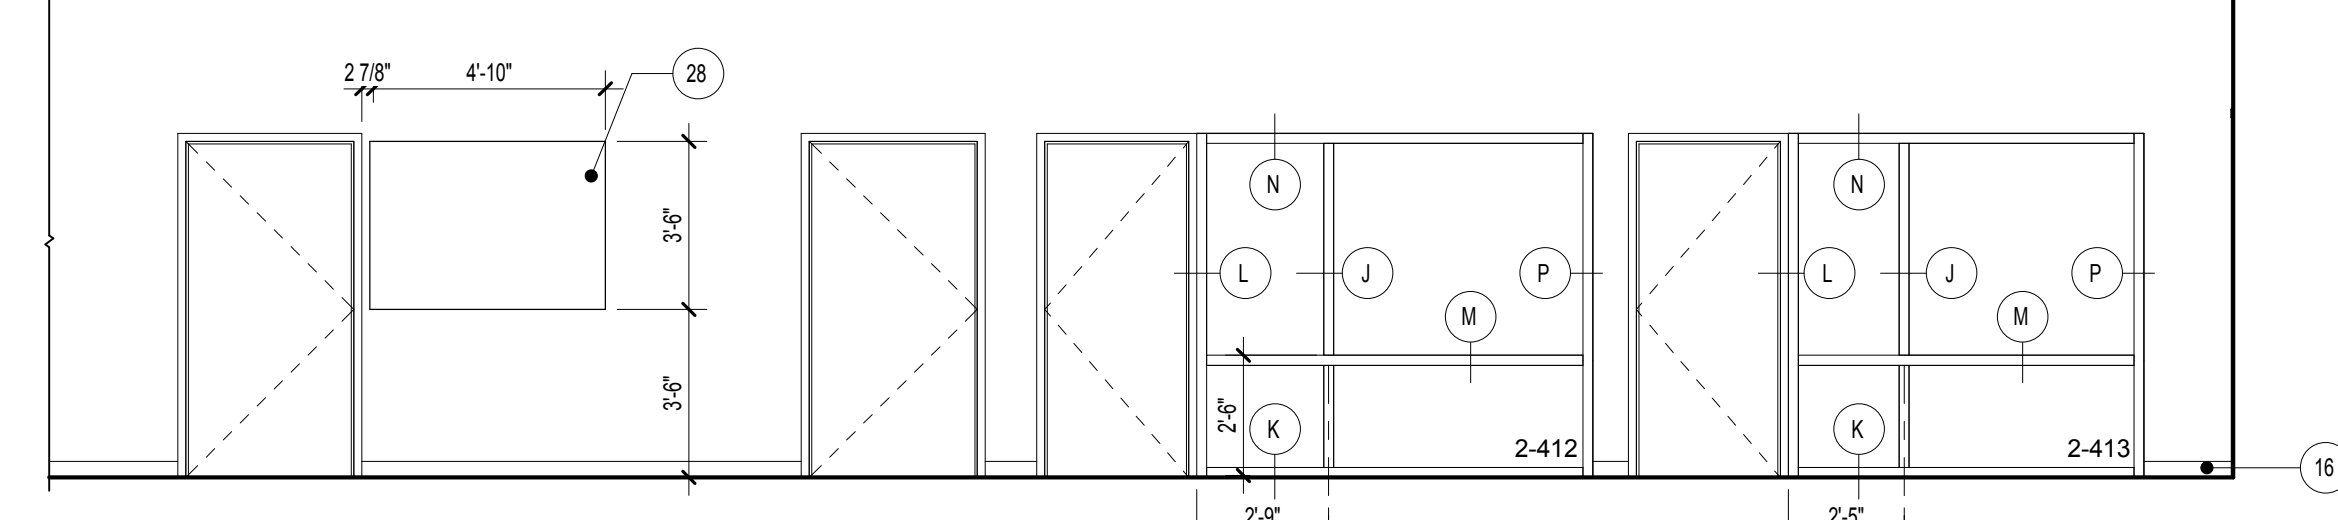

D5 PEDIATRY - CORRIDOR # 2-402
1/4" = 1'-0"

- ### INTERIOR ELEVATION KEYNOTES
- PLASTIC LAMINATE FILLER PANEL.
 - FINISH EXPOSED SIDE OF BASE CABINET WITH PLASTIC LAMINATE.
 - PLASTIC LAMINATE END PANEL.
 - 1" PLASTIC LAMINATE SUPPORT LEG.
 - SLOPED PLASTIC LAMINATE FASCIA PANEL ABOVE WALL CABINET, TYPICAL.
 - PLASTIC WALL PROTECTION.
 - CORNER GUARD.
 - HANDRAIL MOUNT TOP AT 2'-10" A.F.F., U.N.O.
 - BUMPER GUARD.
 - ARCHITECTURAL CONCRETE BENCH BELOW STAIRS. REFER TO DETAIL BS#E42.
 - FABRIC WRAP TACK BOARD.
 - 4" HIGH SOLID SURFACE BACK AND SIDE SPLASHES.
 - SOLID SURFACE WINDOW SILL.
 - WALL OPENING TO BE SCORED TO REFRIGERATOR BOX.
 - SCHEDULED BASE AT RECESSED TOE KICK.
 - SCHEDULED BASE.
 - GYPSUM WALL BOARD SOFFIT.
 - CONTINUOUS WIRE MOLD, REFER TO ELECTRICAL DRAWINGS.
 - CONTINUOUS 'J' HANGER.
 - SEGMENTED REMOVABLE ACCESS PANEL.
 - WALL SCOFF.
 - FLOATING CEILING, REFER TO FINISH PLAN FOR MORE INFORMATION.
 - PROVIDE LOCKS ON CABINETS AND DRAWERS AS NECESSARY.
 - SOLID SURFACE POLYMER END PANEL.
 - GRID MESH RAILING WITH CHESTNUT HANDRAIL, OR APPROVED EQUAL. REFER TO SHEET AE#2 FOR DETAILS.
 - 1/4" NON-VENTED METAL REVEAL.
 - 1" REVEAL IN CONCRETE WALL.
 - LAMINATE AND TEMPERED GLASS.
 - METAL SHELVES ON ADJUSTABLE BRACKETS WITH SLOPED TOP.
 - CUBICLE CURTAIN AND TRACK.
 - METAL SUPPORT BRACKET.
 - CORK BOARD, THERMO SCIENTIFIC HAMILTON MAX LAB SYSTEM, OR APPROVED EQUAL.
 - EPOXY RESIN WORK SURFACE, THERMO SCIENTIFIC HAMILTON MAX LAB SYSTEM, OR APPROVED EQUAL.
 - 12" METAL SHELVING ON ADJUSTABLE BRACKETS, THERMO SCIENTIFIC HAMILTON MAX LAB SYSTEM, OR APPROVED EQUAL.
 - METAL BASE CABINET WITH 4 INCH TOE KICK, THERMO SCIENTIFIC HAMILTON MAX LAB SYSTEM, OR APPROVED EQUAL.
 - SUSPENDED METAL WALL CABINET WITH SLIDING GLASS DOORS, THERMO SCIENTIFIC HAMILTON MAX LAB SYSTEM, OR APPROVED EQUAL.
 - METAL BASE CABINET.
 - SINK PROVIDED BY CASEWORK MANUFACTURER. FAUCET WITH EMERGENCY EYEWASH FIXTURE. REFER TO PLUMBING FIXTURE SCHEDULE.
 - OPENING IN EXISTING BRICK WALL FOR PENETRATION OF HVAC. REFER TO MECHANICAL DRAWINGS FOR DUCT SIZES AND LOCATIONS.
 - TERRA COTTA SILL.
 - TERRA COTTA PORTAL.
 - TASK LIGHTING.
 - SUSPENDED METAL WALL CABINET WITH SLIDING DOORS, THERMO SCIENTIFIC HAMILTON MAX LAB SYSTEM, OR APPROVED EQUAL.
 - METAL MOBILE HEIGHT-ADJUSTABLE TABLE WITH LOWER SHELF, THERMO SCIENTIFIC HAMILTON MAX MOBILE SYSTEM, OR APPROVED EQUAL. 300 LBS LOAD CAPACITY.
 - ISOLATED TABLE PER USE OF MICROSCOPE. REFER TO ENLARGED PLAN LAB DIA#E211.1 FOR LOCATIONS.
 - ADJUSTABLE PLASTIC LAMINATE SHELVES. ALL (6) SIX FACES TO BE LAMINATED PL-1, U.N.O.
 - RECESSED LIGHT FIXTURES, REFER TO REFLECTED CEILING PLAN FOR INFORMATION.
 - PLEXIGLASS SHEET ACRYLIC MIRROR.
 - CONTINUOUS METAL BASE BY LOCKER MANUFACTURER.
 - METAL FILLER PANEL BY LOCKER MANUFACTURER.
 - CONTINUOUS METAL SLOPED TOP BY LOCKER MANUFACTURER.

GENERAL NOTES

- REFER TO OVERALL ARCHITECTURAL PLAN FOR ARCHITECTURAL KEYNOTES.

FULLY SPRINKLERED BID DOCUMENT

CONSULTANTS: Architects-Interiors: ARRAY Structural Engineer: WZG MEP Engineer: APOGEE Fire Protection: Harrington Group, Inc.		PROJECT MANAGER: Bray Mooney Consulting 410 East 21st Street Chester, PA 19013 Tel (215) 518-0864 Fax (484) 428-1547		Project Number 3545	Scale As indicated	Drawing Title ENLARGED PLANS AND INTERIOR ELEVATIONS - PEDIATRY	Project Title BUILDING 3 OUTPATIENT MEDICAL SUITES AND LAB	VA Project Number 542-09-121	Office of Facilities Management 	
Bid RFI Revisions-3545 05-23-13		Revisions		Approved: Project Director		Location 1400 Black Horse Hill, Coatesville, PA	Drawing Number AE205	Dwg. 21 of 79		
2520 Renaissance Blvd Suite 110 King of Prussia, PA 19406 Tel (610) 270-5599 Fax (610) 270-5995		180 W. Ridge Pike Limerick, PA 19468 Tel (214) 329-5559		6325 Woodside Court Columbia, MD 21046 Tel (919) 858-7420		7508 E. Independence Blvd Suite 116 Charlotte, NC 28227 Tel (704) 531-9077 Fax (704) 567-7087		Date 04-23-2012		Checked WC