




three inches = one foot
 one and one-half inches = one foot
 one inch = one foot
 three-quarters inch = one foot
 one-half inch = one foot
 one-quarter inch = one foot
 three-eighths inch = one foot
 one-eighth inch = one foot

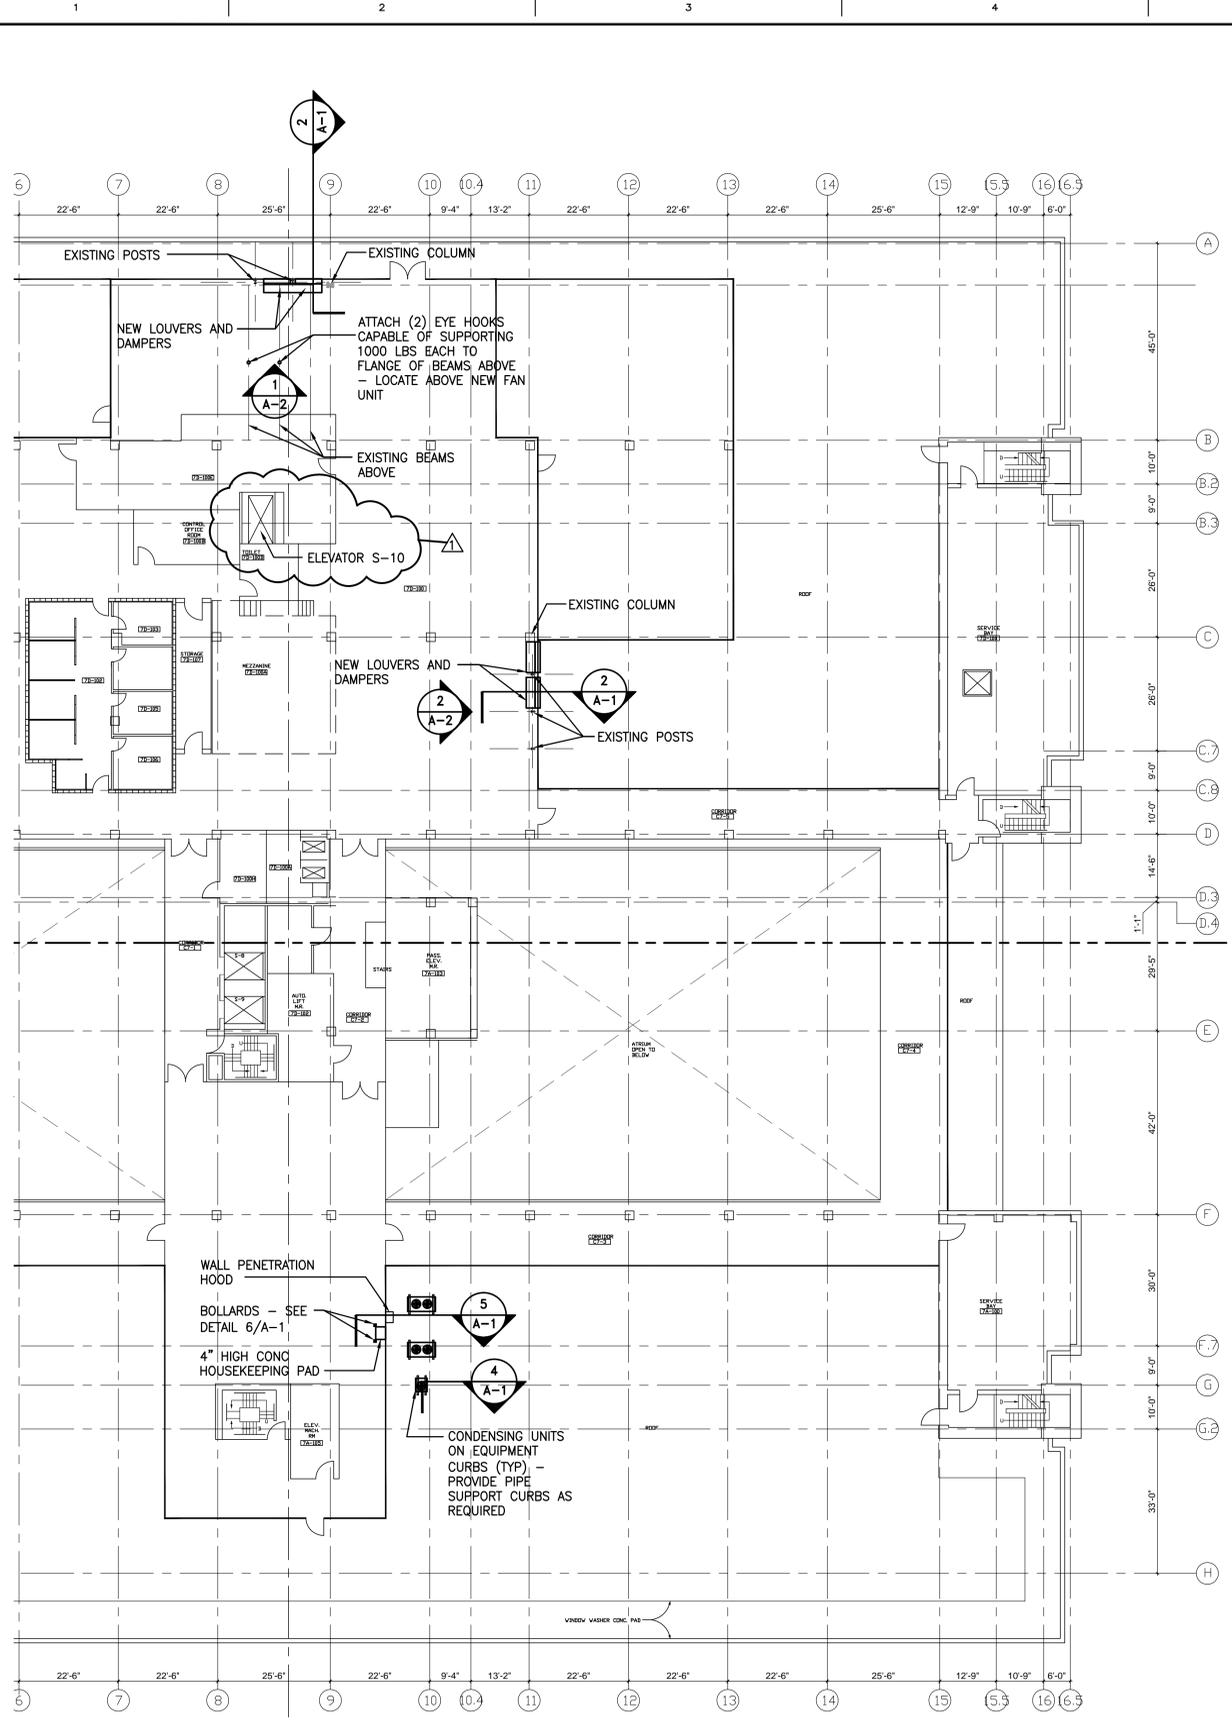


1 PARTIAL 7TH FLOOR PLAN
 SCALE: 1/16" = 1'-0"

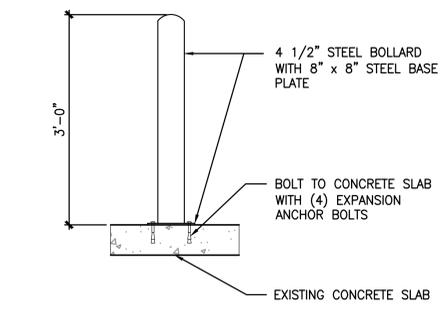


 SCALE: 1" = 1'-0"

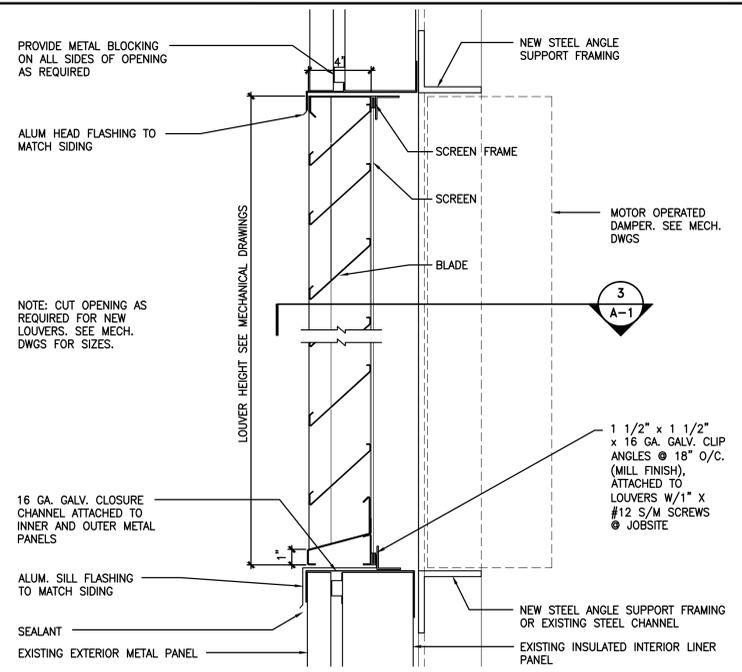


2 LOUVER SILL AND HEAD DETAIL
 SCALE: 3" = 1'-0"

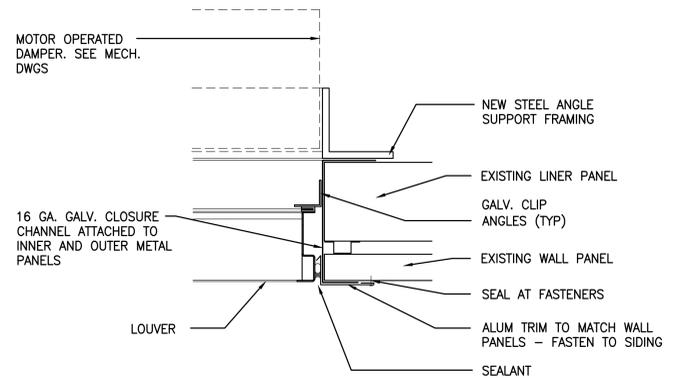

3 LOUVER JAMB DETAIL
 SCALE: 3" = 1'-0"

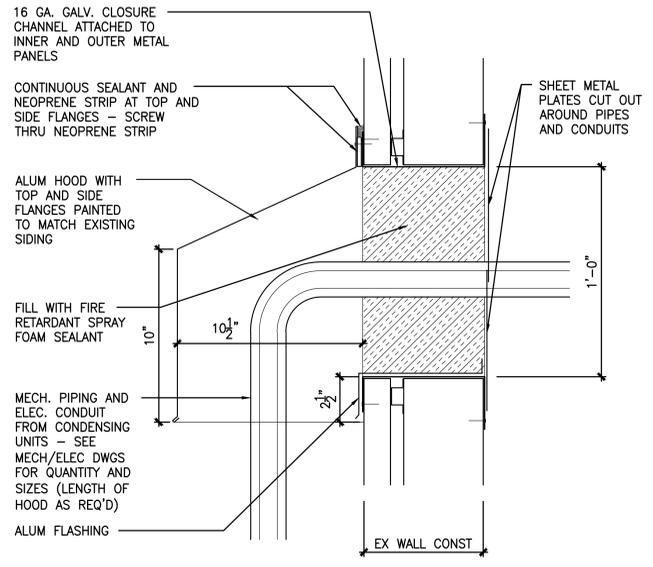

5 PIPE WALL PENETRATION DETAIL
 SCALE: 3" = 1'-0"

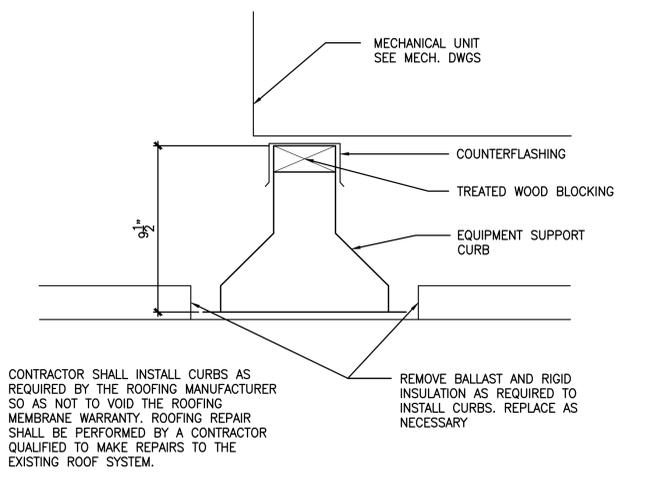

4 EQUIPMENT SUPORT CURB DETAIL
 SCALE: 3" = 1'-0"

ADDENDUM 1 Revisions	Date 06/03/13	Consultants BURDETTE KOEHLER MURPHY & ASSOCIATES, INC. MECHANICAL / ELECTRICAL / FIRE PROTECTION / TELECOMMUNICATIONS VILLAGE OF CROSS KEYS, EAST QUADRANGLE - 2 HAMILL RD, SUITE 300 BALTIMORE, MARYLAND 21210 410.323.0600 - FAX 410.377.2543	KEY PLAN	Seal	DERBY ENTERPRISES ARCHITECTURE PLANNING ENGINEERING 2215 Conowingood Road, Suite 100 Bel Air, Maryland 21015-1436 410.803.0009 fax 410.836.6611	Drawing Title SEVENTH FLOOR PLAN	Project Title HVAC IMPROVEMENTS 7TH FLOOR	Date 3/29/13	Project No. 512-12-103	DEPARTMENT OF VETERANS AFFAIRS
						Approved: Associate Director of Operations	Building Number 1	Checked CAJ	Drawn DEK	