


4 BASEMENT FLOOR PLAN -
 MATERIALS DELIVERY AND ELEVATOR ACCESS
 A-3 SCALE: 3" = 1'-0"


	ADDENDUM 1	06/03/13
	Revisions	Date

Consultants

BURDETTE KOEHLER MURPHY & ASSOCIATES, INC.
 MECHANICAL / ELECTRICAL / FIRE PROTECTION / TELECOMMUNICATIONS
 VILLAGE OF CROSS KEYS, EAST QUADRANGLE - 2 HAMILL RD, SUITE 300
 BALTIMORE, MARYLAND 21210
 410.323.0600 - FAX 410.377.2543

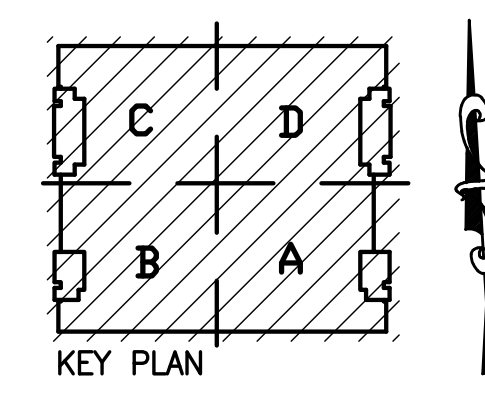

Seal

DERBY ENTERPRISES
 ARCHITECTURE
 PLANNING
 ENGINEERING
 2215 Conowingo Road, Suite 100
 Bel Air, Maryland 21015-1436
 410.803.0009
 fax 410.836.6611

Drawing Title BASEMENT FLOOR PLAN MATERIALS DELIVERY AND ELEVATOR ACCESS	Project Title HVAC IMPROVEMENTS 7TH FLOOR
Approved: Associate Director of Operations	Building Number 1
Approved: Medical Center Director	Checked CAJ
	Drawn DEK

Location BALTIMORE, MARYLAND

DELLC
 JOB NO. 121101D
 Date
 3/29/13
 Project No.
 512-12-103
 DRAWING NO.
 A-3
 Dwg. 4 Of 11