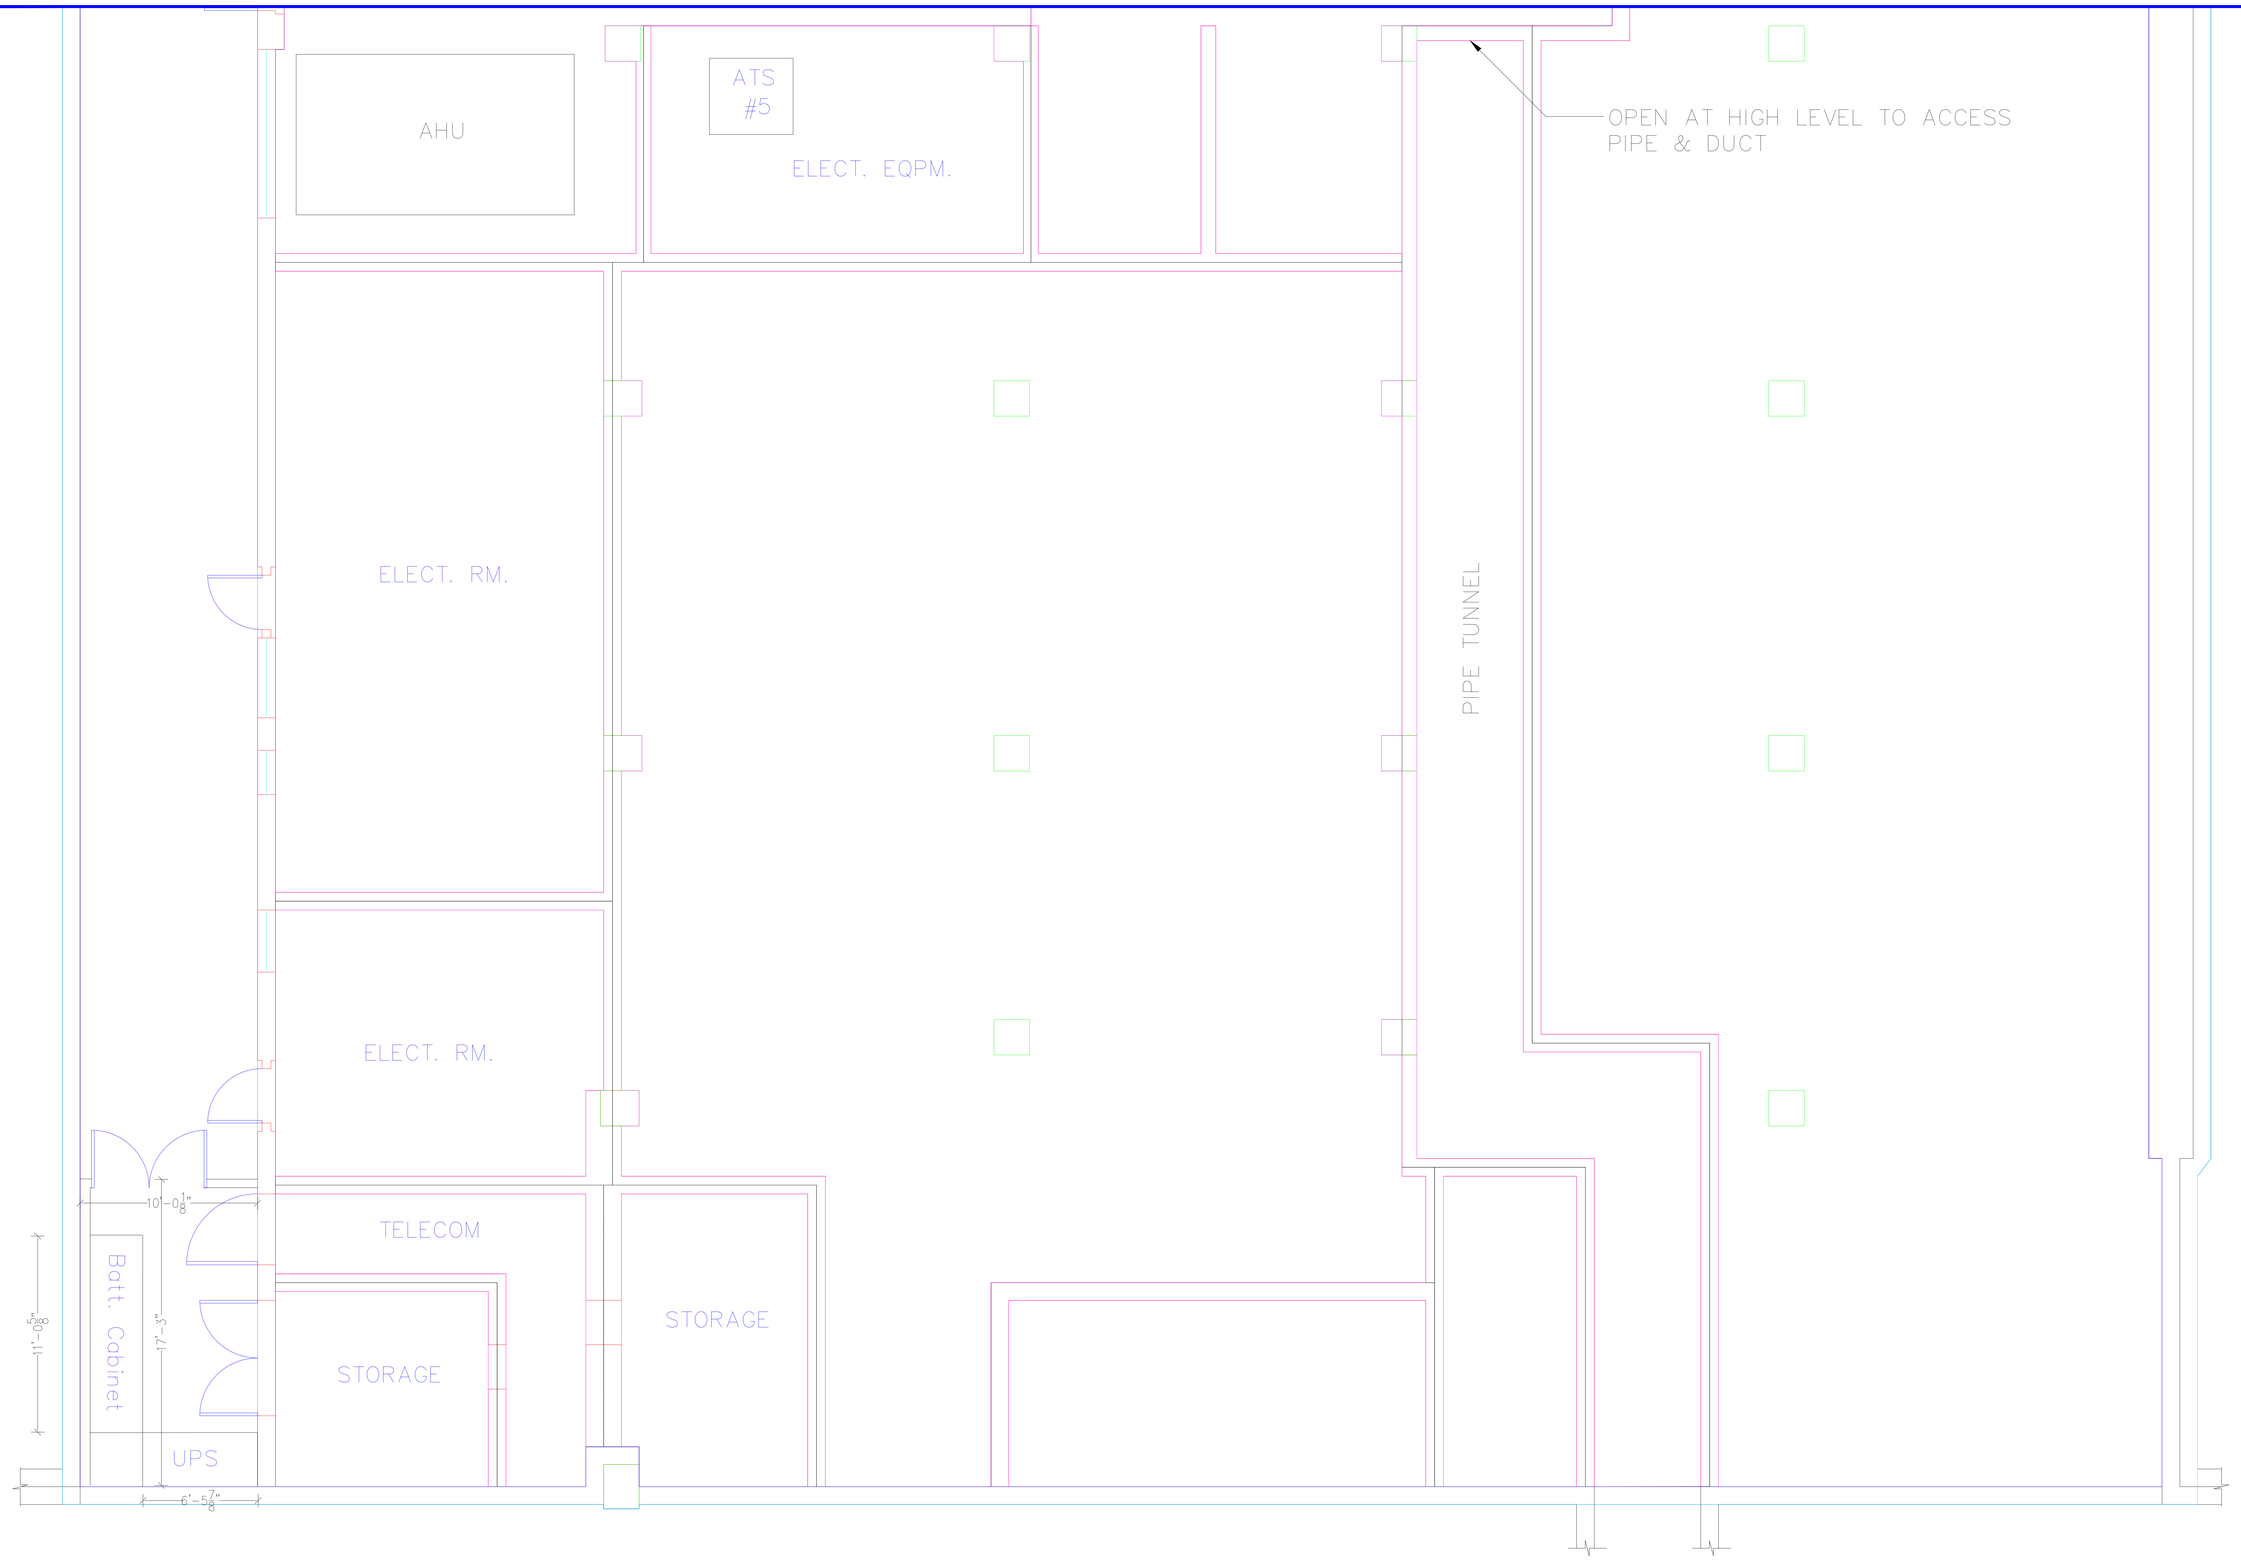

Revisions | Date

Professional Seal

Indus Systems, Inc.
2352, Main Street, Concord MA 01742
Tel: 978-461-0555
www.indus-systems.com

Drawing Title: BASEMENT FLOOR PLAN ARCHITECTURAL	Project Title: AS-BUILT Drawings	Date: 04-17-2008	
		Project No.	
Approved:	Building Number: 200	Checked	Drawn
Approved:	Location: VA SAN FRANCISCO	Drawing No.	

VA SAN FRANCISCO

Department of Veterans Affairs

VA FORM 08-6231, OCT 1978