



N:\2012\2031\2024\07\VA_MU_BLDG_58\623.12.104-53.58-FA-100_623.12.104.dwg, 53-58-FA-100_623.12.104.dwg, 6/6/2013 2:18:38 PM, Layer: 1:1

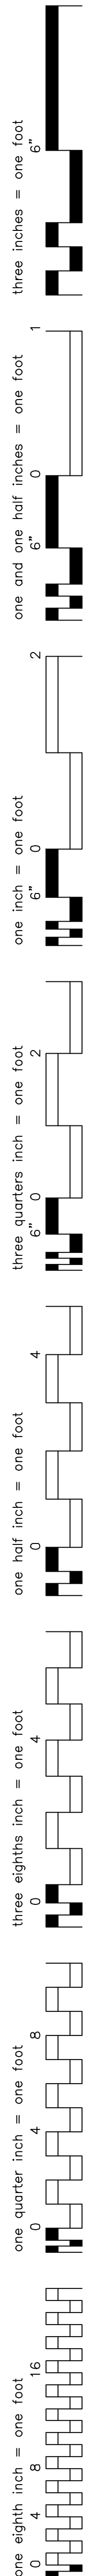


SEE SHEET FA001 FOR SYMBOL KEY, KEYED NOTES, ETC.

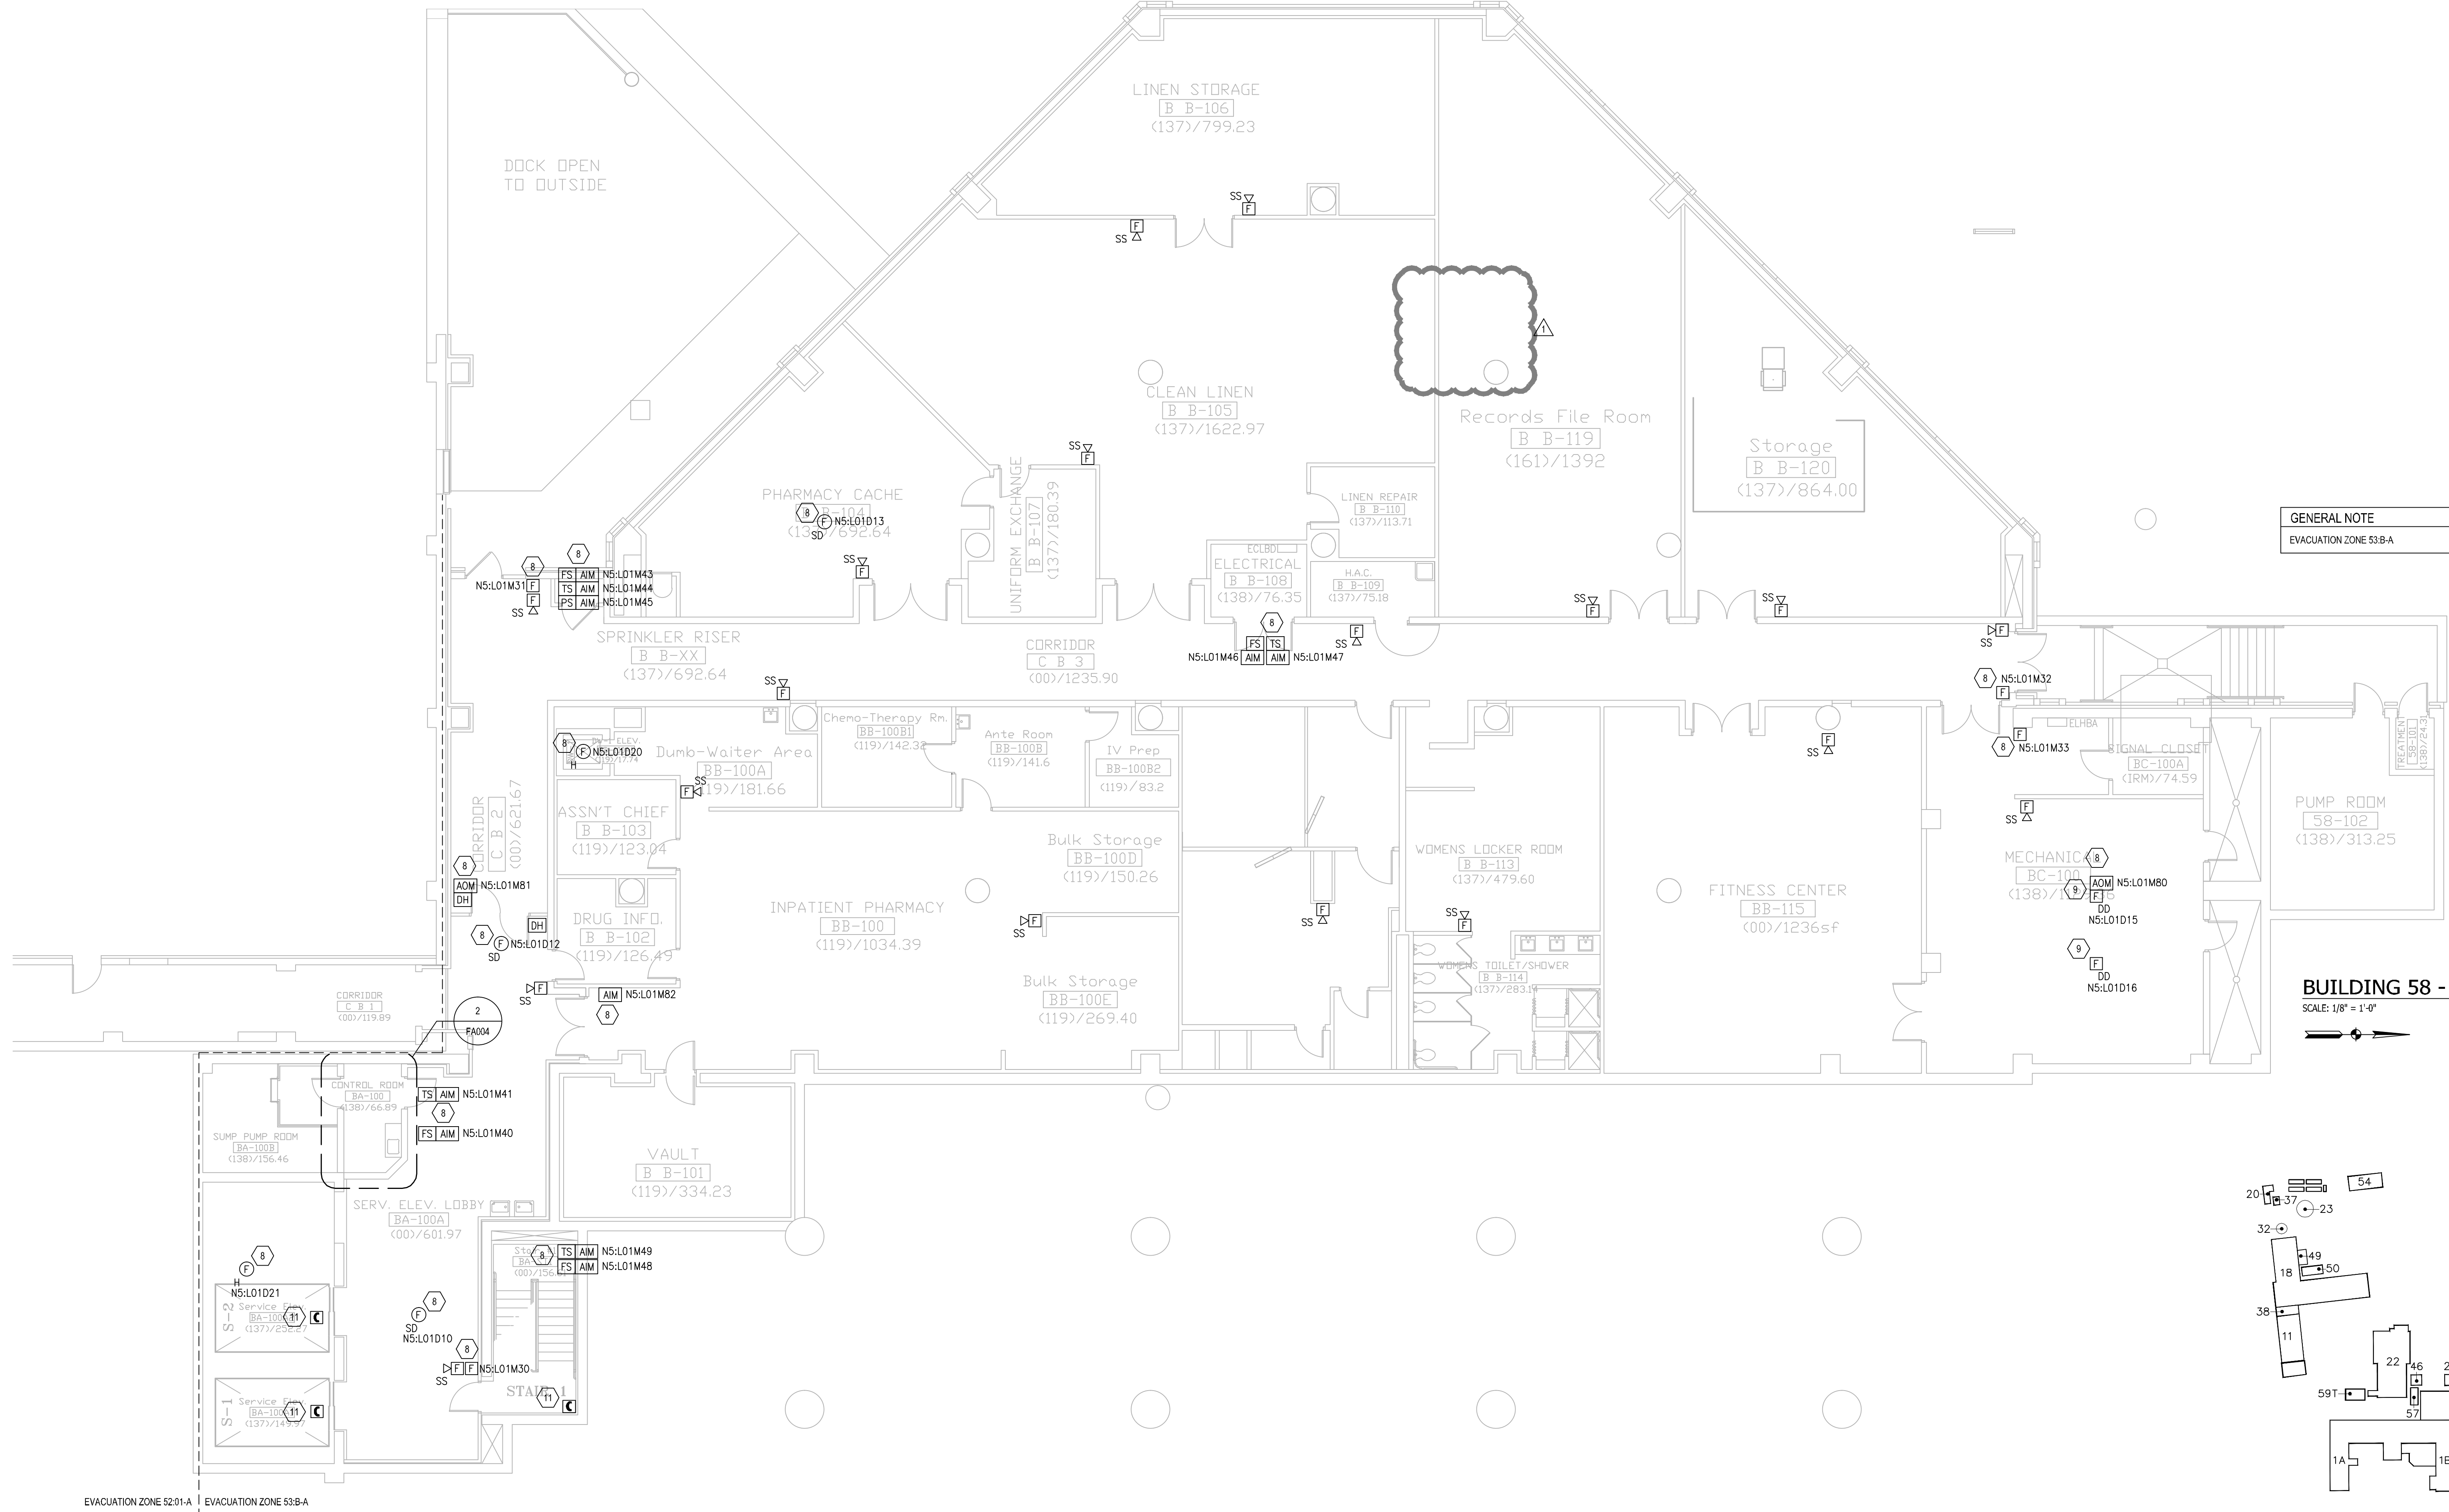

GENERAL NOTE
EVACUATION ZONE 53-B-A

BUILDING 58 - BASEMENT - FIRE ALARM
SCALE: 1/8" = 1'-0"
➔

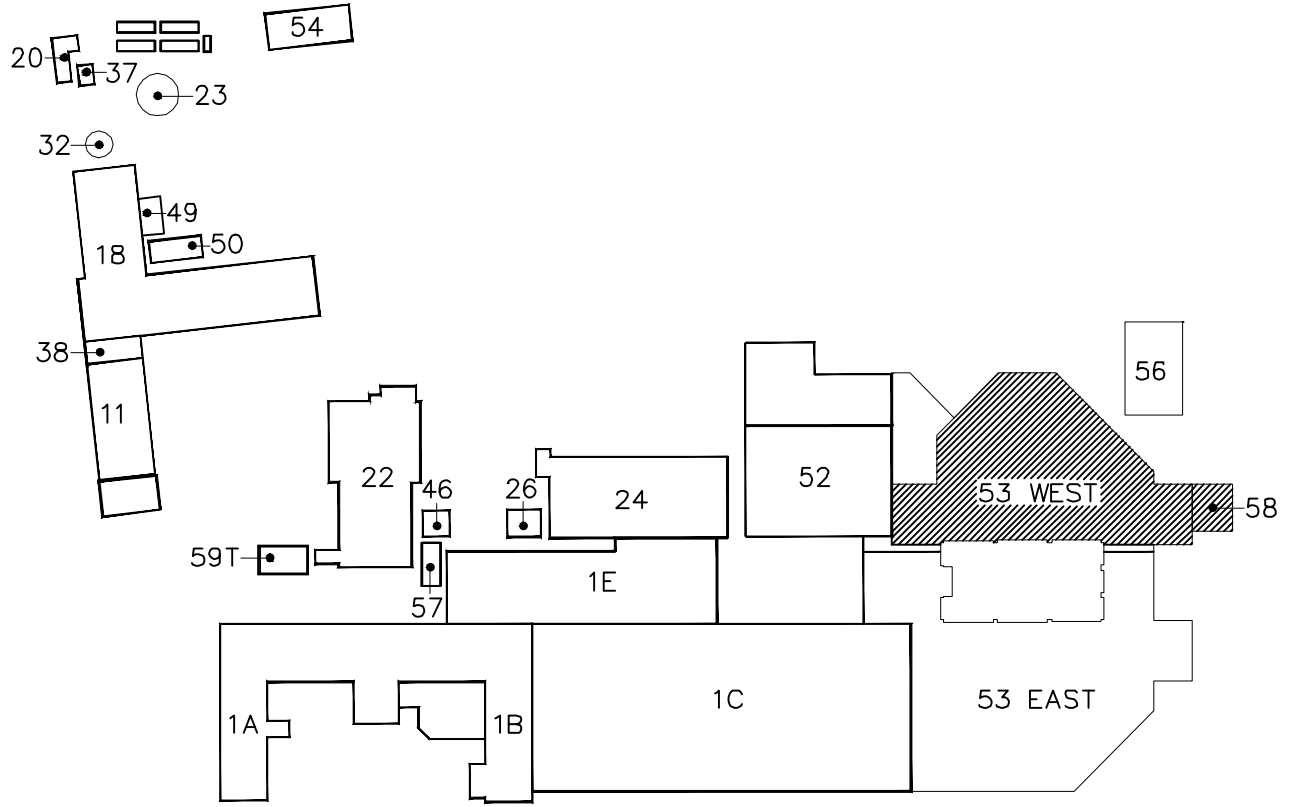

KEY PLAN ➔

BUILDING 53 - BASEMENT - FIRE ALARM
SCALE: 1/8" = 1'-0"
➔

DATE: 06/06/13
**FIRE PROTECTION
ENGINEER OF RECORD:**
JACOB P. HEDRICK, P.E.
LICENSE NO. PE 2014001791
CODE CONSULTANTS, INC.
2843 WOODLAND PKWY, SUITE 300
ST. LOUIS, MO 63146-4235
PHONE: 314.991-2633
WWW.CODECONSULTANTS.COM

No.	Description	Date
1	AMENDMENT	6/6/13

VA FORM 08-6231 PRINTED ON:

CONSULTANTS:

CCI

CODE CONSULTANTS, INC.
2843 WOODLAND PKWY, SUITE 300
ST. LOUIS, MISSOURI 63146-4235
314-991-2633
www.codeconsultants.com

ARCHITECTS/ENGINEERS:

303rd Engineering Group, LLC
A Service-Disabled Veteran-Owned Small Business
1935 ARDENAL STREET
ST. LOUIS, MO 63114
PHONE: (314) 644-3339
WWW.303RDENGRUP.COM

**Dept. of Veterans Affairs
Jack C. Montgomery
Medical Center
1011 Honor Height Drive
Muskogee, Oklahoma 74401**

APPROVED:	APPROVED:President AF.G.E. 2250	APPROVED:Energy Engineer	APPROVED:Medical Center Director
APPROVED:	APPROVED:	APPROVED:Safety Manager	APPROVED:Associate Director
APPROVED:	APPROVED:	APPROVED:Infection Control Nurse	APPROVED:Chief of Staff
APPROVED:	APPROVED:	APPROVED:Industrial Hygienist	APPROVED:Chief of Engineering Service

Drawing Title:
BASEMENT

Scale:
AS SHOWN

Building Number:
53 / 58

Project Title:
**REPLACE FACILITIES
FIRE ALARM SYSTEM**

Approved: TWC - JCMVAMC
Checked By: JPH
Drawn By: CRO

Location: Jack C. Montgomery
VA Medical Center - Muskogee, OK

Date:
February 14, 2013

Project No.
623.12.104

Drawing No.
53-58-FA100

Dwg. 28 of 62



FULLY SPRINKLERED