


F:\projects\1393 VA Central Valley\001 Bld 24 Seismic Corrections & Addition\18-CAD\ACA\Sheets\CLARIFICATION DRAWINGS\AD-A03 PARTIAL ELEVATION.dwg 6/7/2013 8:51 AM Cheng Lo

PROJECT NUMBER 570-215

BUILDING NO. 24

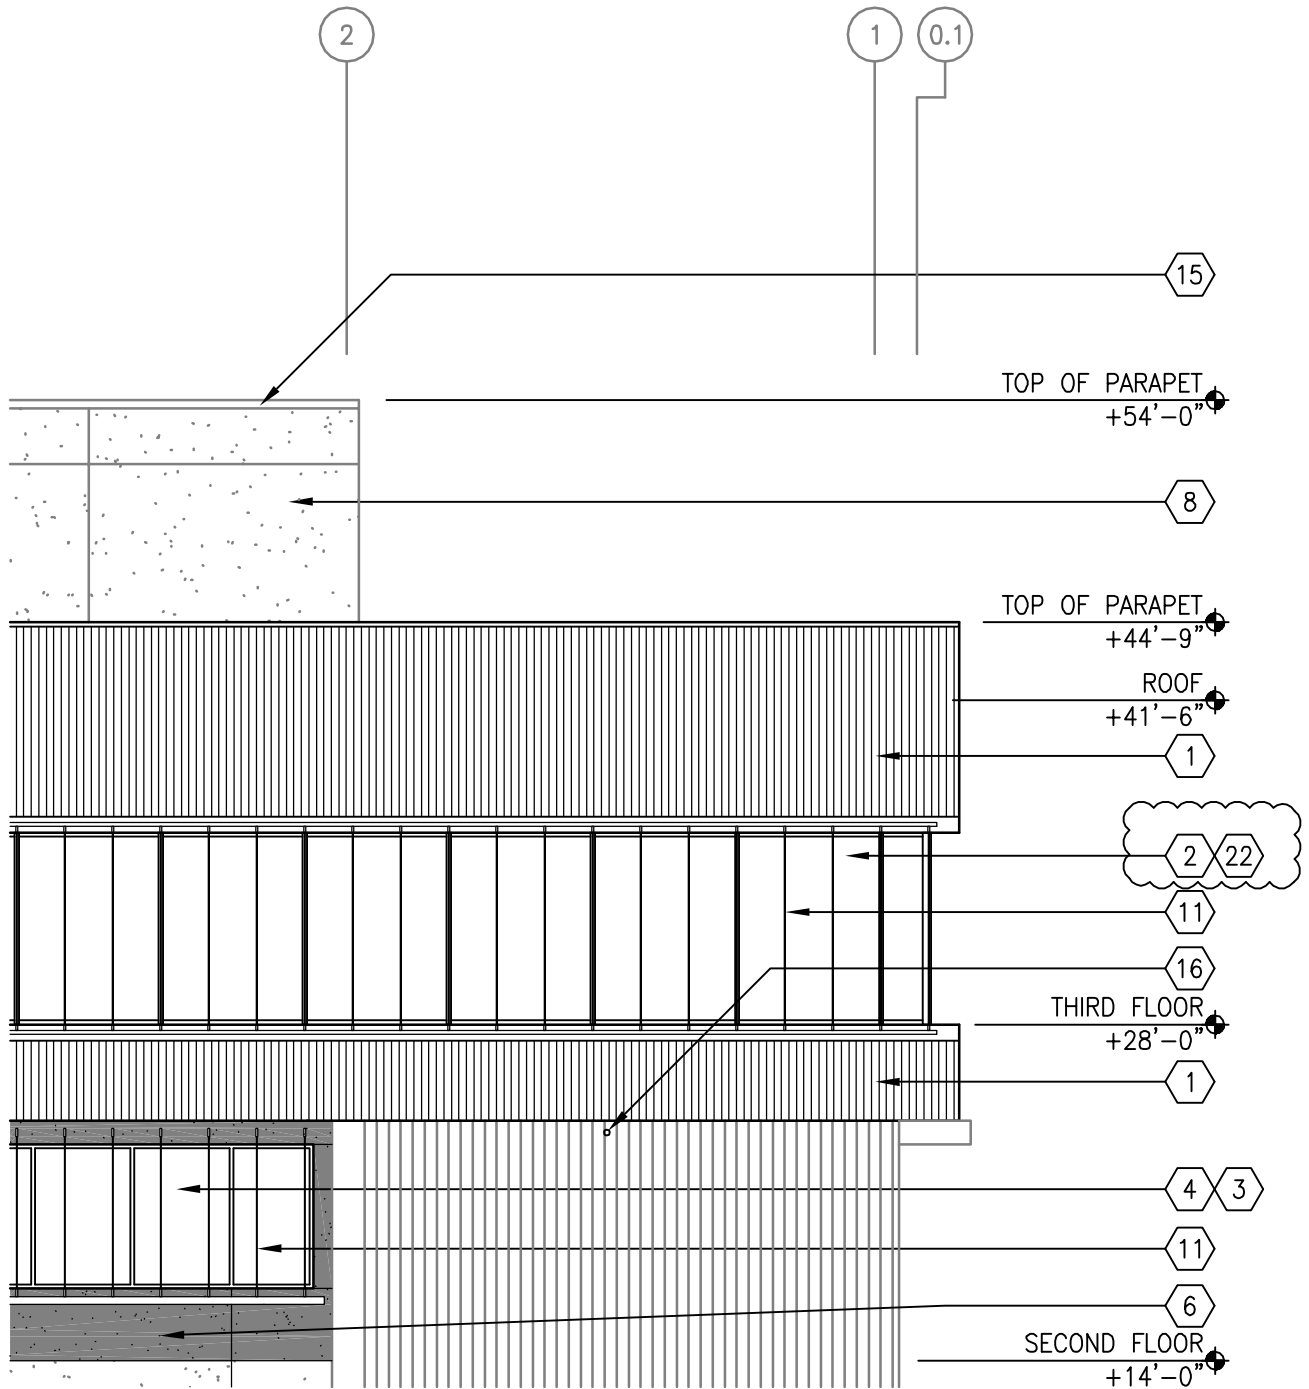

Drawing Title: PARTIAL ELEVATION

Reference Drawing: AS502

Scale:
1/8" = 1'-0"

Project No.
1393001

Date:
06/05/2013

HMCArchitects

1827 E. Fir Avenue, Studio 103 / Fresno, CA 93720
T 559 322 2444 / www.hmcarchitects.com

**BUILDING 24
SEISMIC
CORRECTION
AND ADDITION**

**Office of
Construction
and Facilities
Management**



Department of
Veterans Affairs

AD-A03