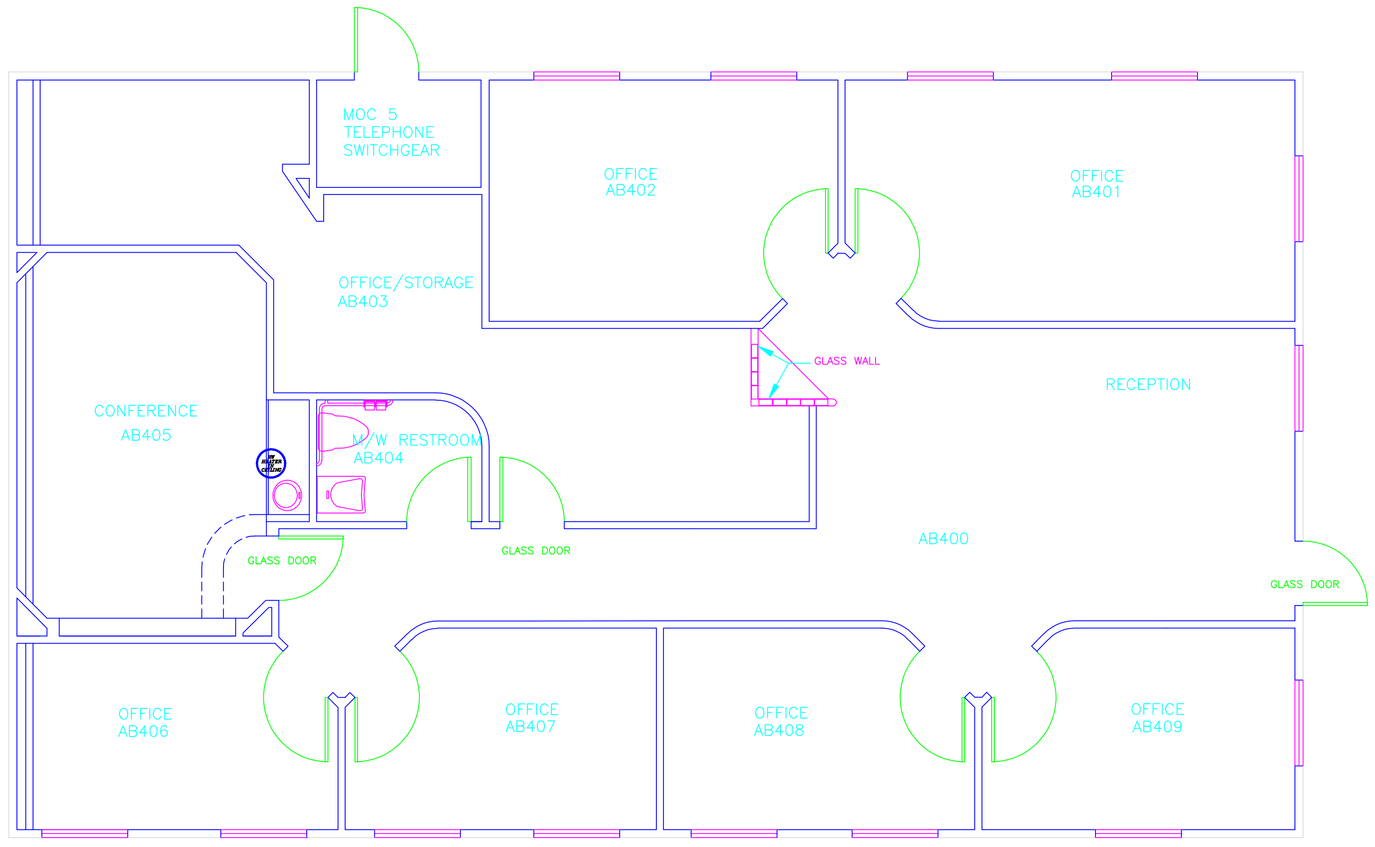

VA NORTHERN CALIFORNIA HEALTH CARE SYSTEM
MARTINEZ CAMPUS, AB-4

AS-BUILT DRAWING-2006

Revisions:	Date	CONSULTANTS:	
ARCHITECT/ENGINEERS: 1/4"=1'-0"	eCIFM SOLUTIONS inc. 3130 CROW CANYON ROAD, SUITE F SAN RAMON, CA 94583 TEL : (925) 830 1925 FAX : (925) 830 2750	Drawing Title: FLOOR PLAN	Approved Project Director
Project Title: DOCUMENTATION OF AS-BUILT CONDITIONS	Location: MARTINEZ, CA	Date: APRIL 2006	Checked / Drawn
Project Number: 612-05-105	Building Number: MTZ- AB-4	Drawing Number: Dwg. of --	Office of Facilities Management Department of Veterans Affairs

VA FORM 08-6231, OCT 1978