


# BLDG AB4

Replace ramp, curb ramp, etc...to meet  
VA ADA requirements



Replace door, reconfigure  
deck to tie in into the new  
ramp, etc...to meet  
VA ADA requirements

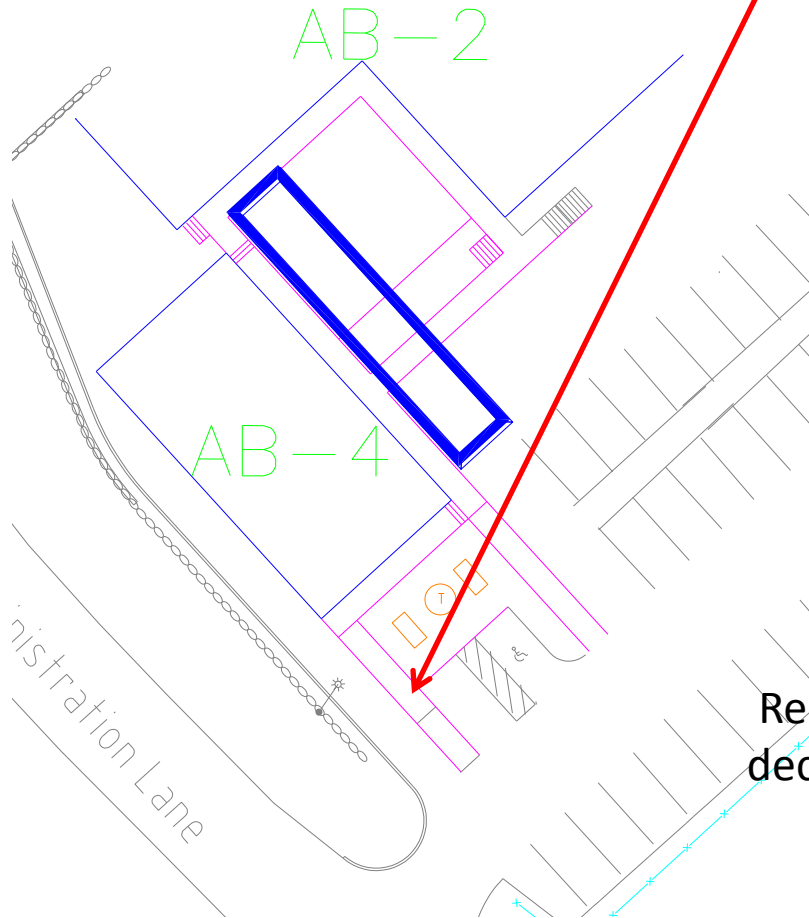

# BLDG AB6

Provide concrete sidewalk  
from stair 2 to tie into the  
sidewalk of stair 3




Stair 3




Stair 2

Stair 1

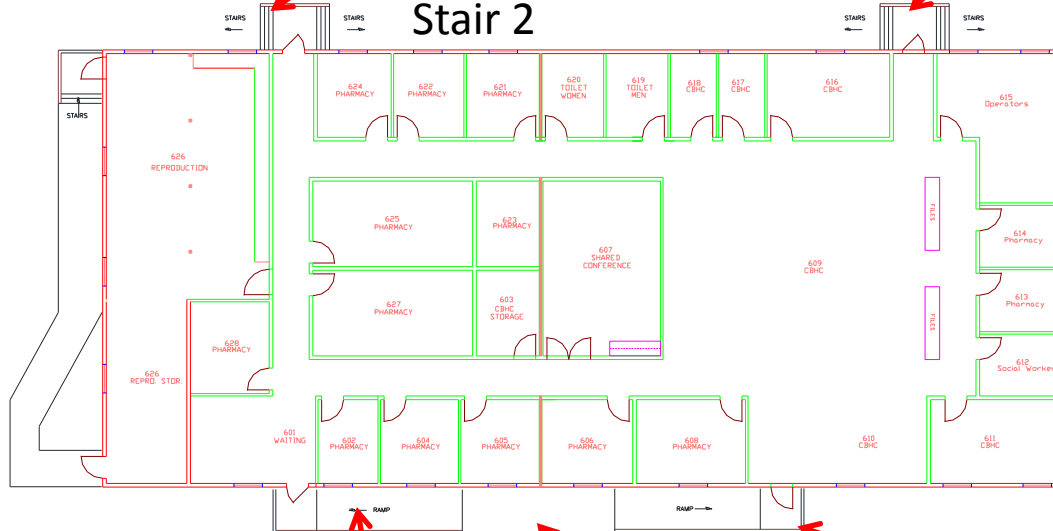


Replace ramp,  
etc...to meet  
VA ADA  
requirements

Replace ramp, curb ramp,  
etc...to meet  
VA ADA requirements

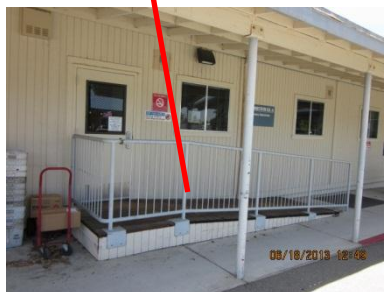

# BLDG AB7

Replace ramp, etc...to meet  
VA ADA requirements


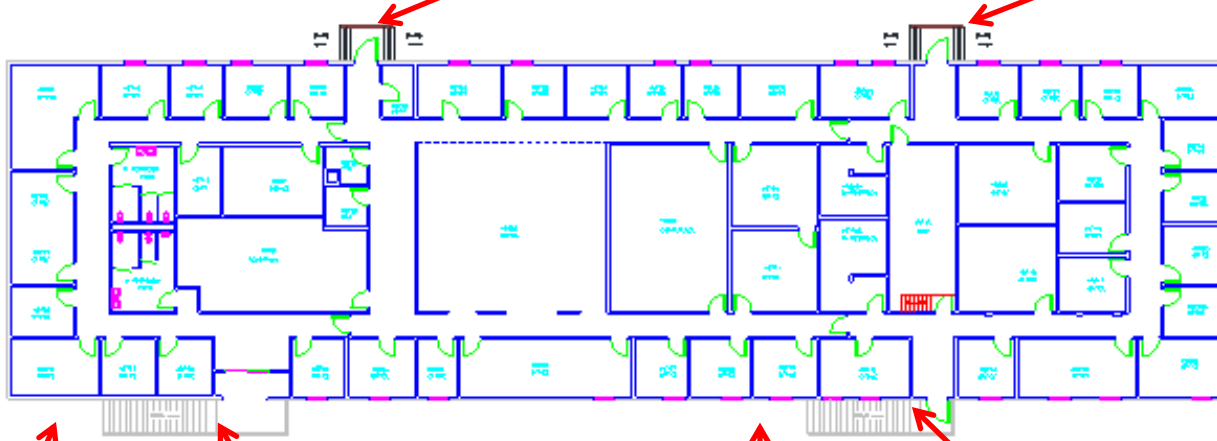


Replace ramp, curb ramp,  
etc...to meet  
VA ADA requirements




# BLDG AB7

Renovate women's and men's restrooms  
etc...to meet VA ADA requirements

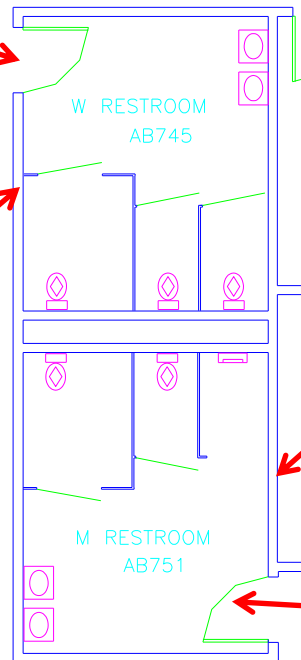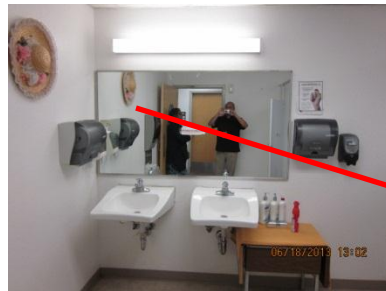

# BLDG AB7

Field verify dimensions

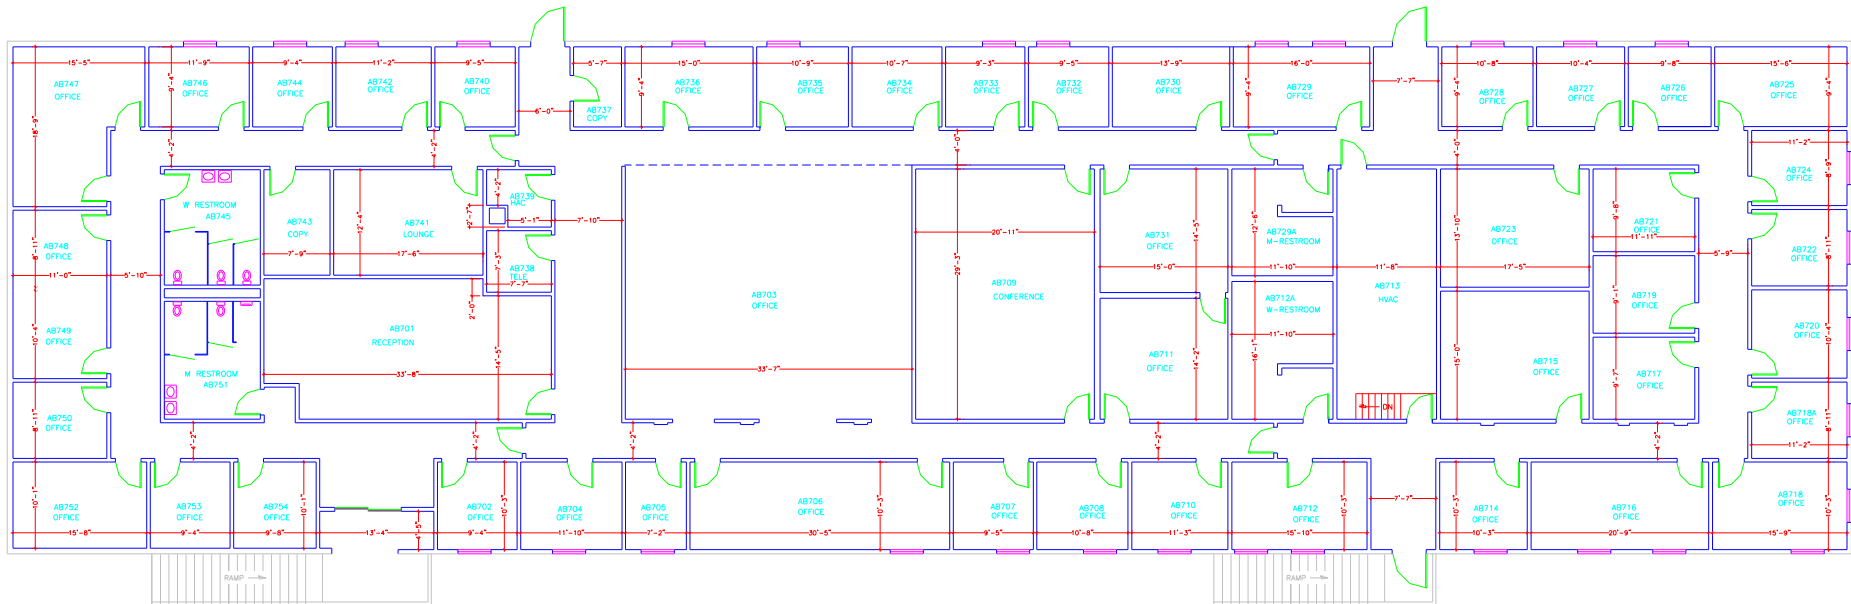

MARTINEZ BUILDING AB-7

# BLDG AB6

Field verify dimensions

