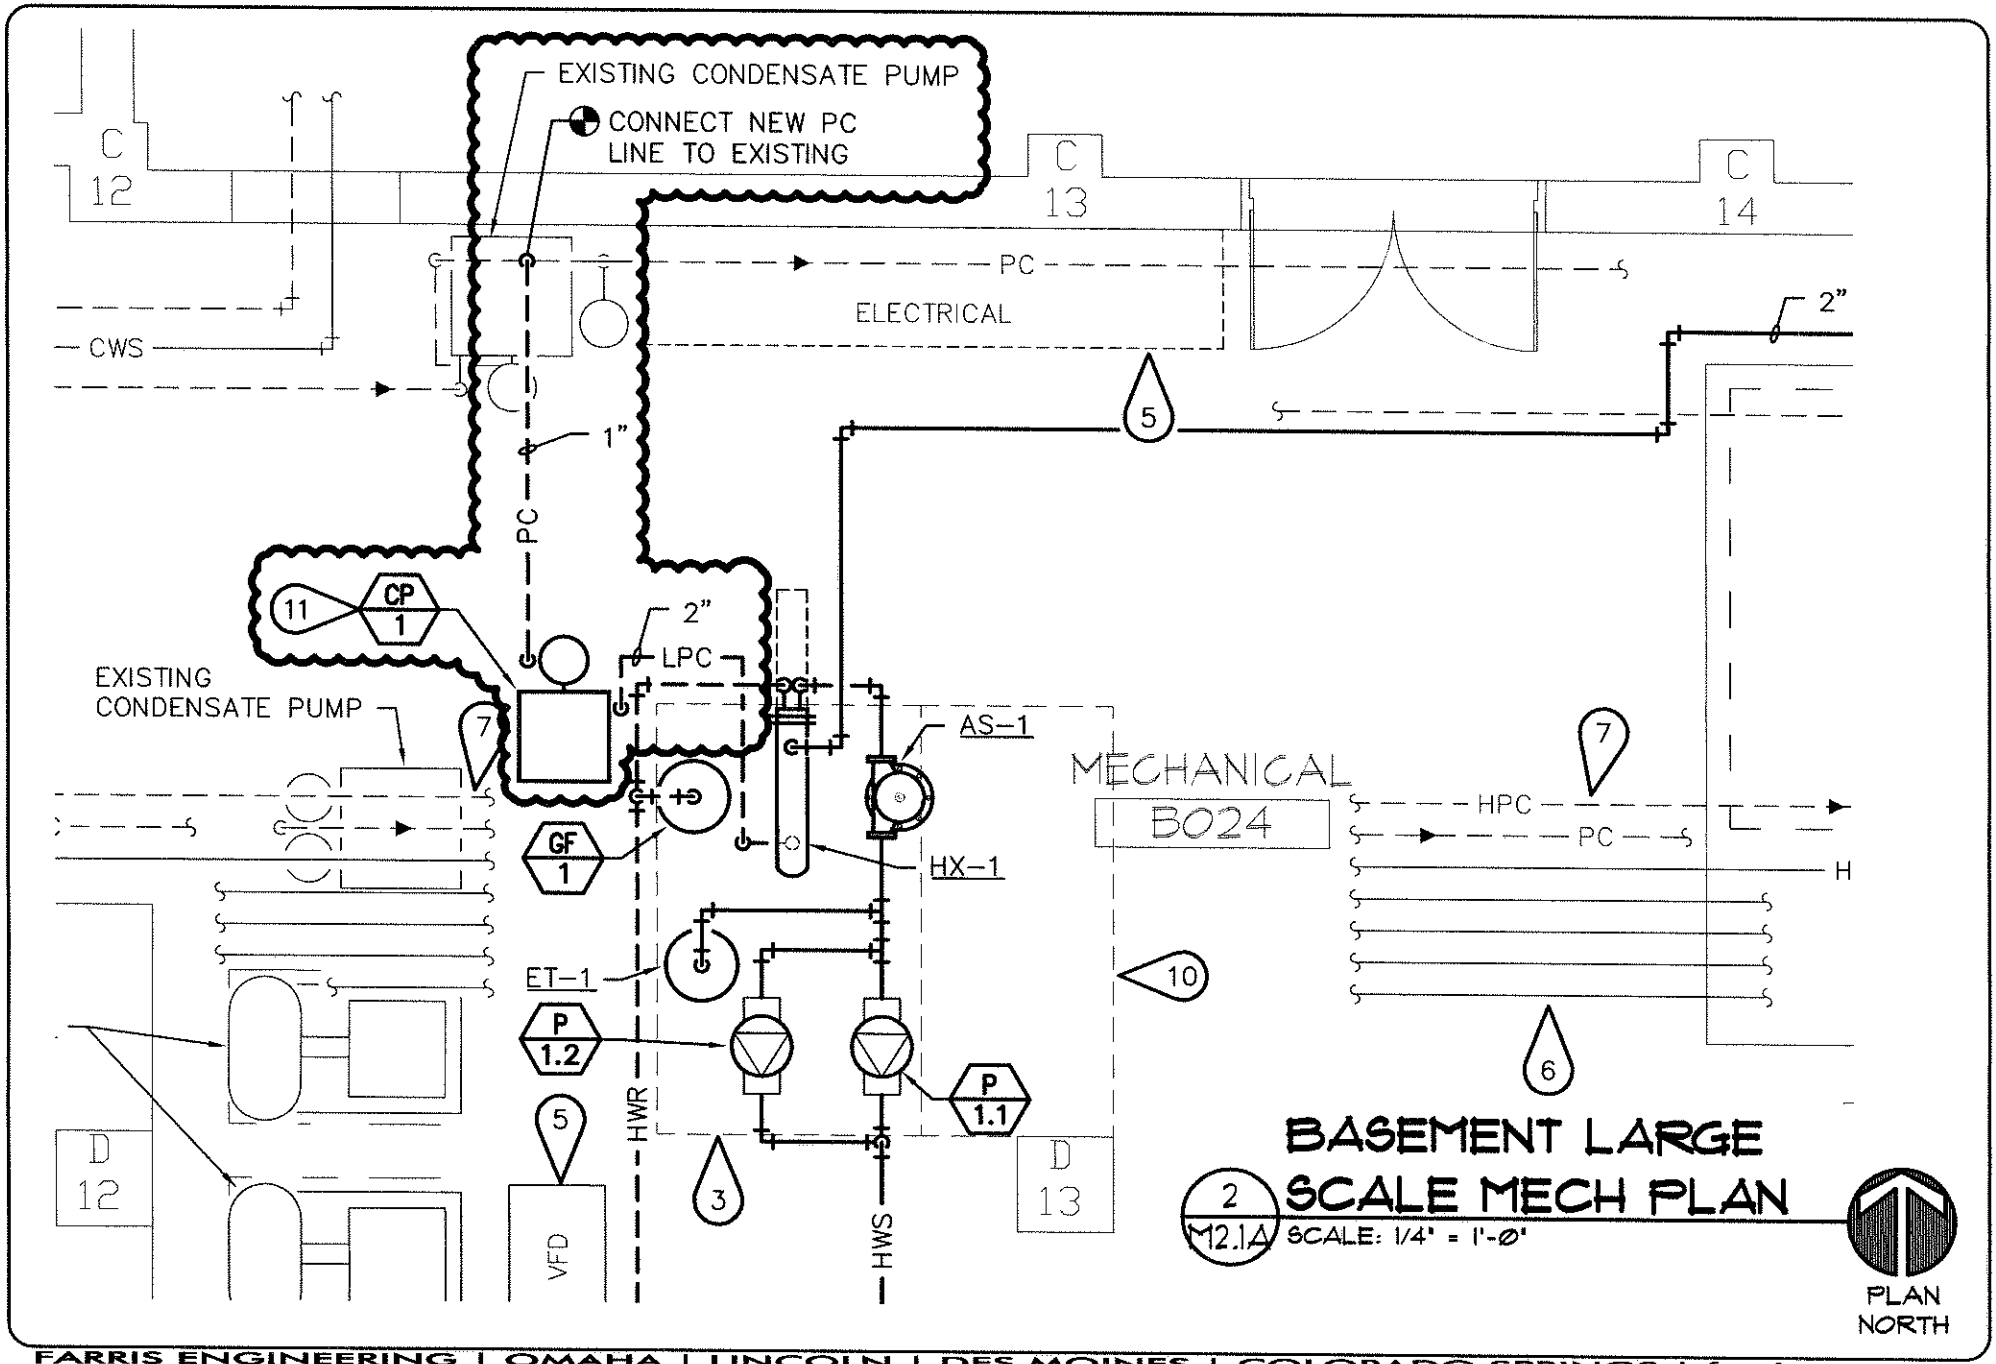

FARRIS ENGINEERING | OMAHA | LINCOLN | DES MOINES | COLORADO SPRINGS | farris-usa.com

Project:
CORRECT MAIN ENTRANCE HVAC

Sheet Title:
BASEMENT MECHANICAL PLANS

VA Project No:	Addenda No:	Dwg Ref No:	M2.1A
636-13-122	1	Addenda Sht:	1 of 3
FE Project No:	Date:	Checked By:	MKL
122032	06-21-13	Drawn By:	LMB

G:\2012\122032\CAD\Mechanical\122032_M2.1.dwg M2.1A 6/20/13 9:28am lmb

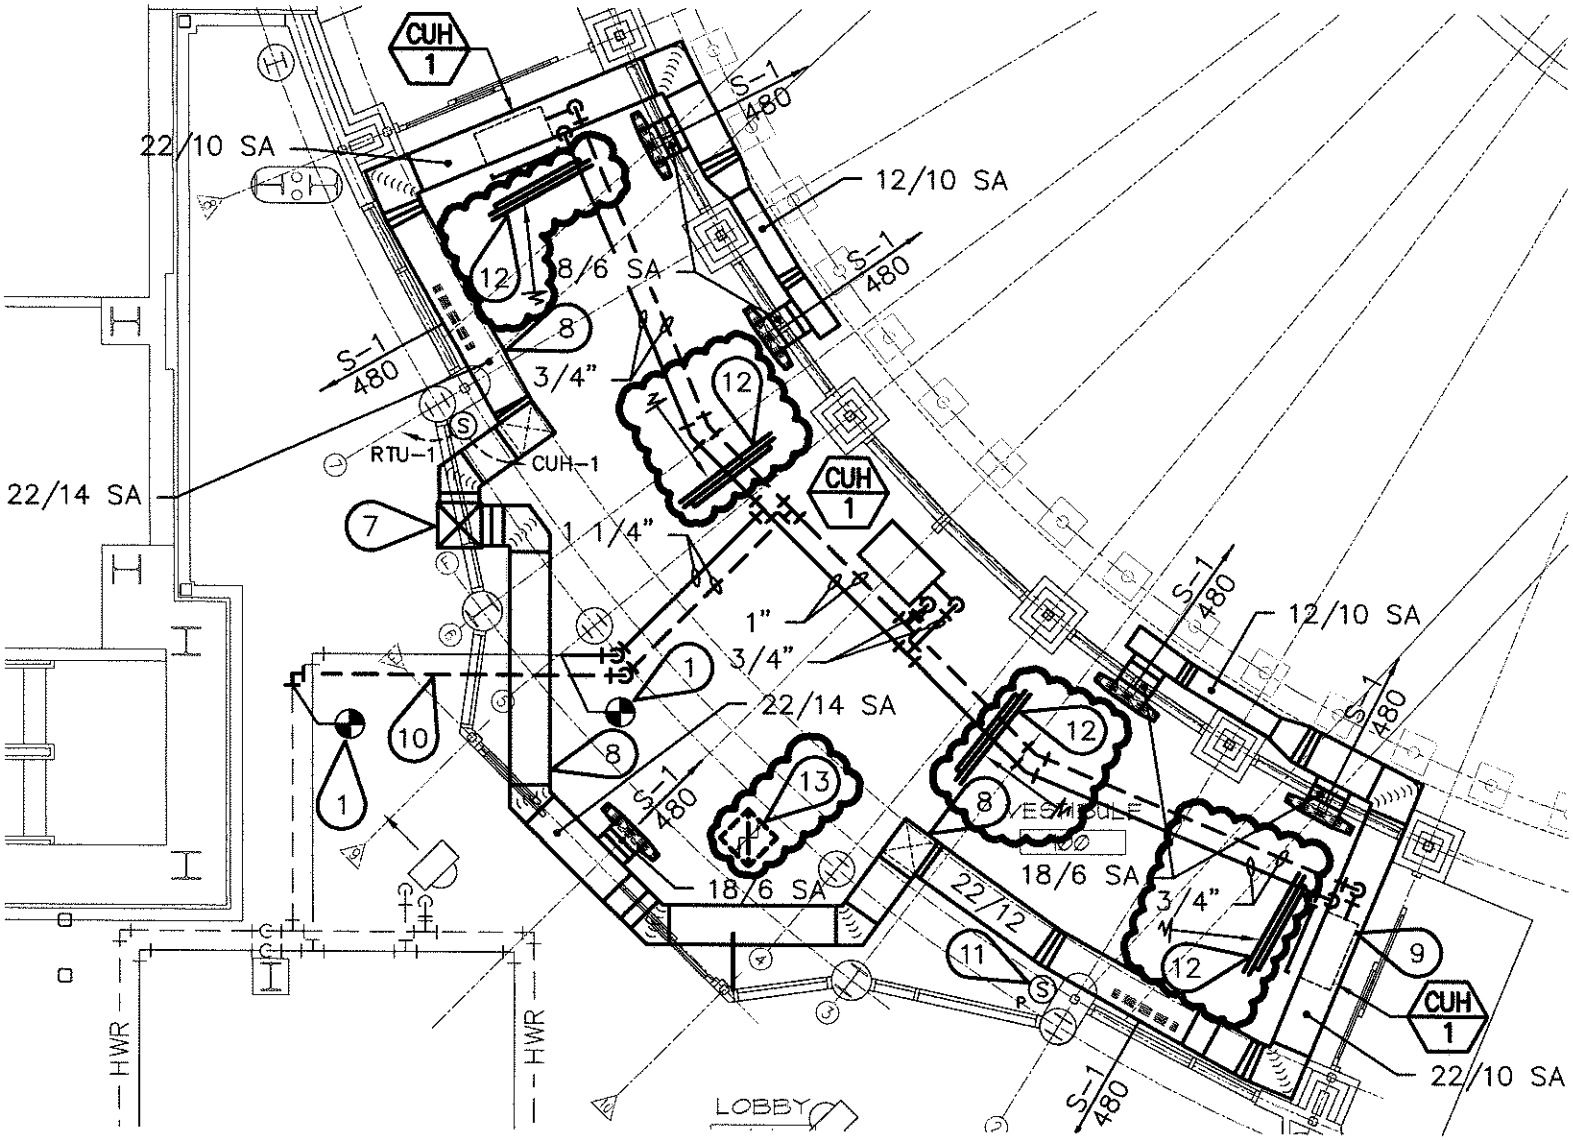

1 M2.2A FIRST FLOOR MECHANICAL PLAN

SCALE: 1/8" = 1'-0"

PLAN NORTH

MECHANICAL KEYNOTES:

12 PROVIDE 48"X6" KRUEGER S80H GRILLE CENTERED IN BACK WALL OF LIGHT COVE. GRILLE SHALL HAVE 0° BLADE DEFLECTION AND SHALL BE OPEN TO VESTIBULE CEILING SPACE.

13 PROVIDE 20"X20" RELIEF AIR OPENING AND BAROMETRIC RELIEF DAMPER WITH ADJUSTABLE SETTING AT TOP LID OF VESTIBULE. RELIEF AIR OPENING SHALL CONNECT CEILING SPACE ABOVE VESTIBULE WITH ADJACENT LOBBY. SEE WALL SECTION ON A4.1.

Project: CORRECT MAIN ENTRANCE HVAC

Sheet Title: FIRST FLOOR MECHANICAL AND PLUMBING PLANS

VA Project No:	Addenda No:	Dwg Ref No:	M2.2A
636-13-122	1	Addenda Sht:	2 of 3
FE Project No:	Date:	Checked By:	MKL
122032	06-21-13	Drawn By:	LMB

G:\2012\122032\CAD\Mechanical\122032_M2.2.dwg M2.2A 6/20/13 9:29am lmb

CONDENSATE RETURN PUMP SCHEDULE

MARK	TYPE	CAPACITY LB/HR	GPM	HEAD PSIG	PUMP RPM	RECEIVER CAP. (GAL)	MANUFACTURER & MODEL NO.	REMARKS
CP-1	SIMPLEX	1,700	12	20	3500	10	SHIPCO 80 EC-P	1

REMARKS:

1. SEE MECHANICAL/ELECTRICAL COORDINATION SCHEDULE FOR ELECTRICAL DATA.