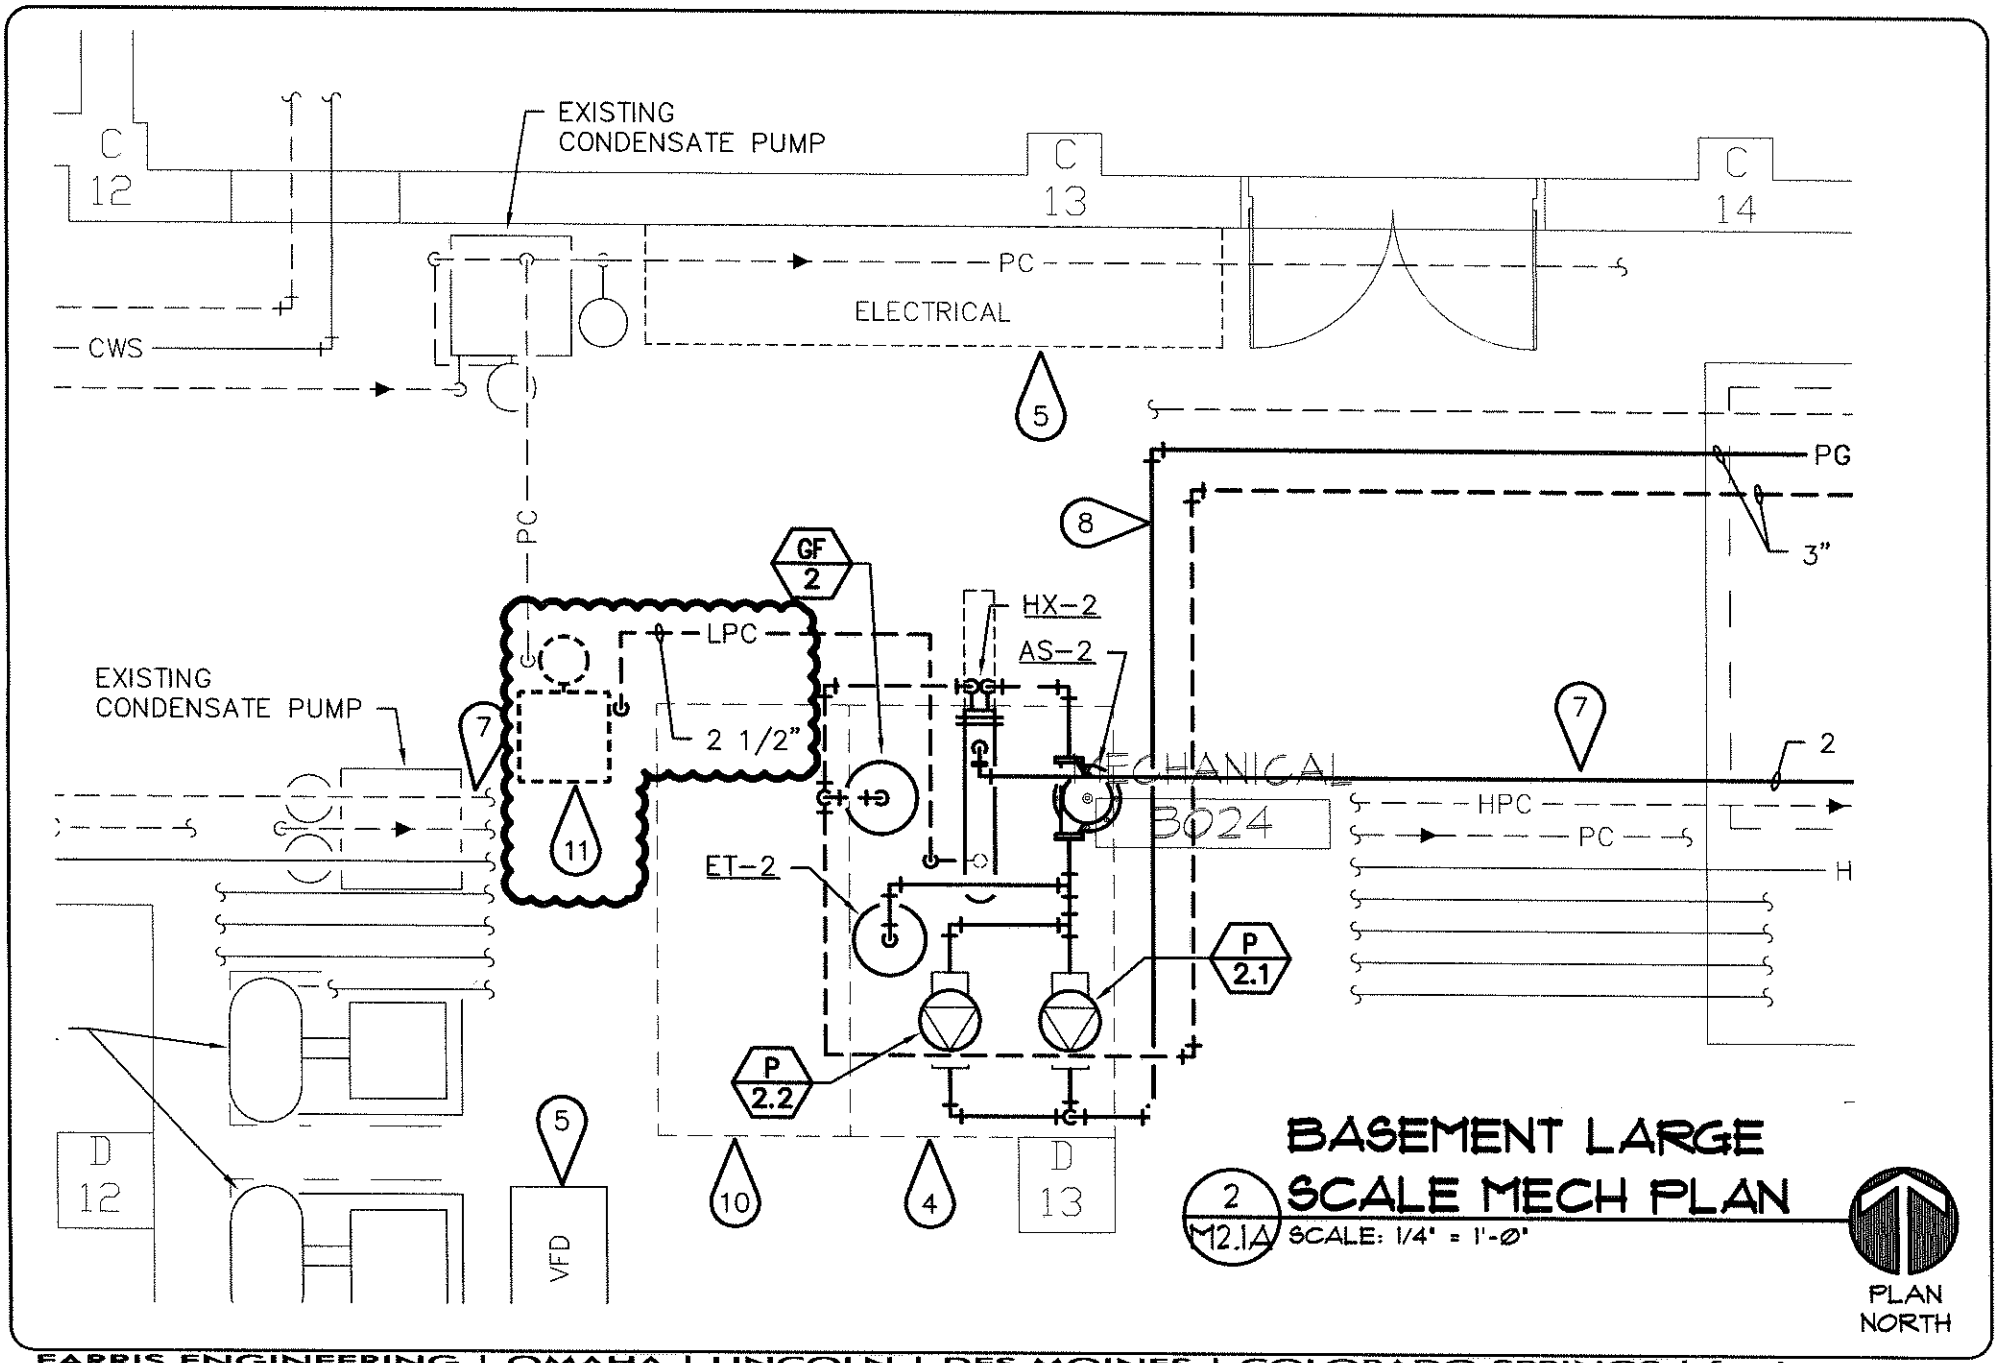

FARRIS ENGINEERING | OMAHA | LINCOLN | DES MOINES | COLORADO SPRINGS | farris-usa.com

Project:
UPGRADE FORCE PROTECTION FRONT ENTRANCE

Sheet Title:
BASEMENT MECHANICAL PLANS

VA Project No:	Addenda No:	Dwg Ref No:	M2.1A
636-13-126	1	Addenda Sht:	1 of 1
FE Project No:	Date:	Checked By:	MKL
122032	06-21-13	Drawn By:	LMB

G:\2012\122032\CAD\Mechanical\122032FP_M2.1.dwg M2.1A 6/20/13 9:23am lmb