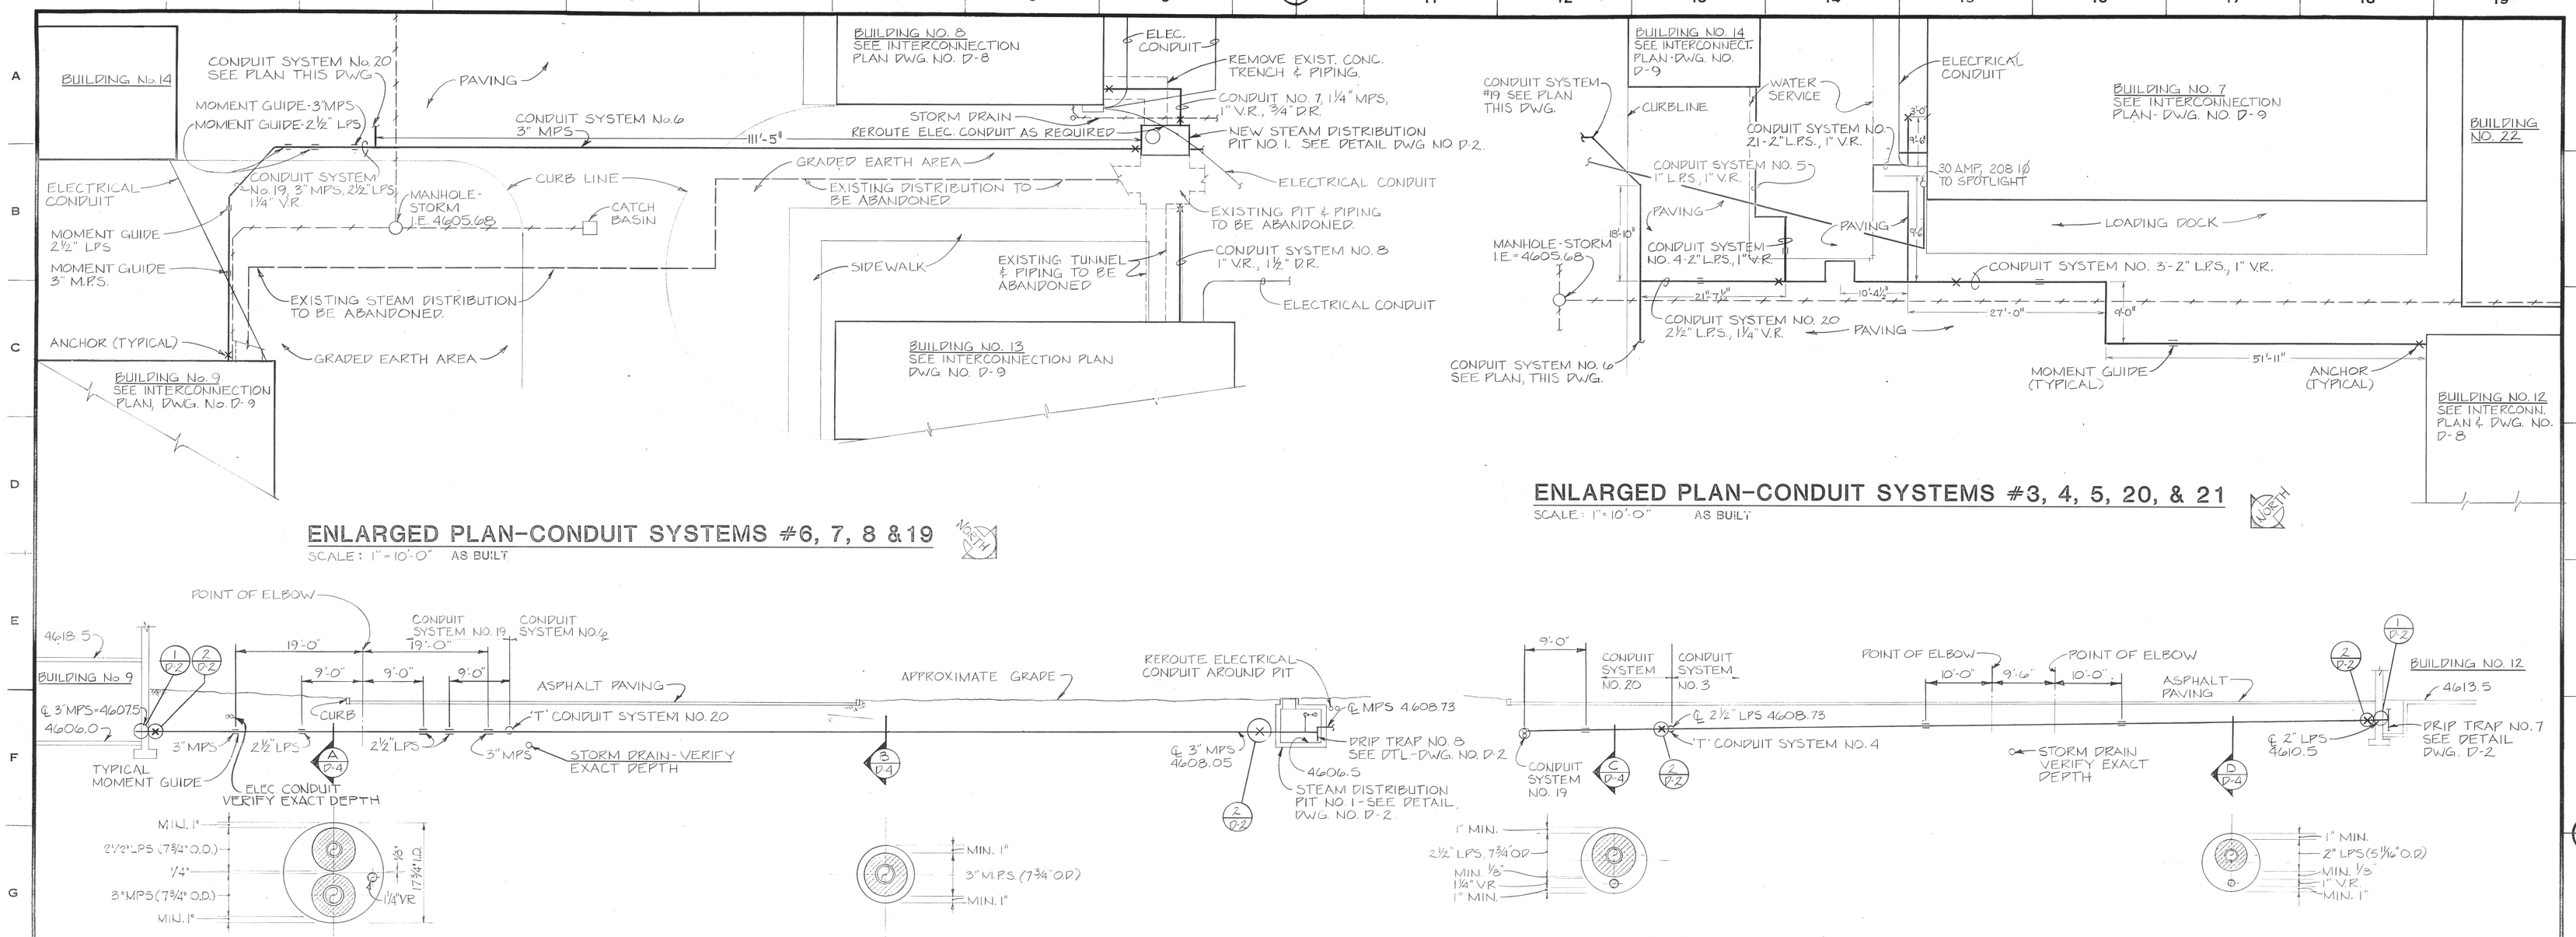

NO	DATE	DESCRIPTION
1	1-11-82	AS BUILT

REVISIONS

SHEET TITLE: ENLARGED PLAN & PROFILES CONDUIT SYSTEMS 3,4,5,6,7,8,19,20,21

BLDG. NO.

PROJECT TITLE: REPLACE STEAM MAINS

DRAWN: D.B. RYLATT | CHECKED: W.R. HARMON | DATE: 15 MARCH 1981

APPROVED: DIVISION CHIEF

DRAWING NUMBER: D-4

DWG. 4 OF 9

PROJECT NUMBER: 575-80-123

APPROVED: DIRECTOR

VETERANS ADMINISTRATION

LOCATION: 2121 NORTH AVENUE GRAND JUNCTION, CO. 81501

VA FORM 08-6231, FEB 1973

U.S. GOVERNMENT PRINTING OFFICE 1974 O - 223-122