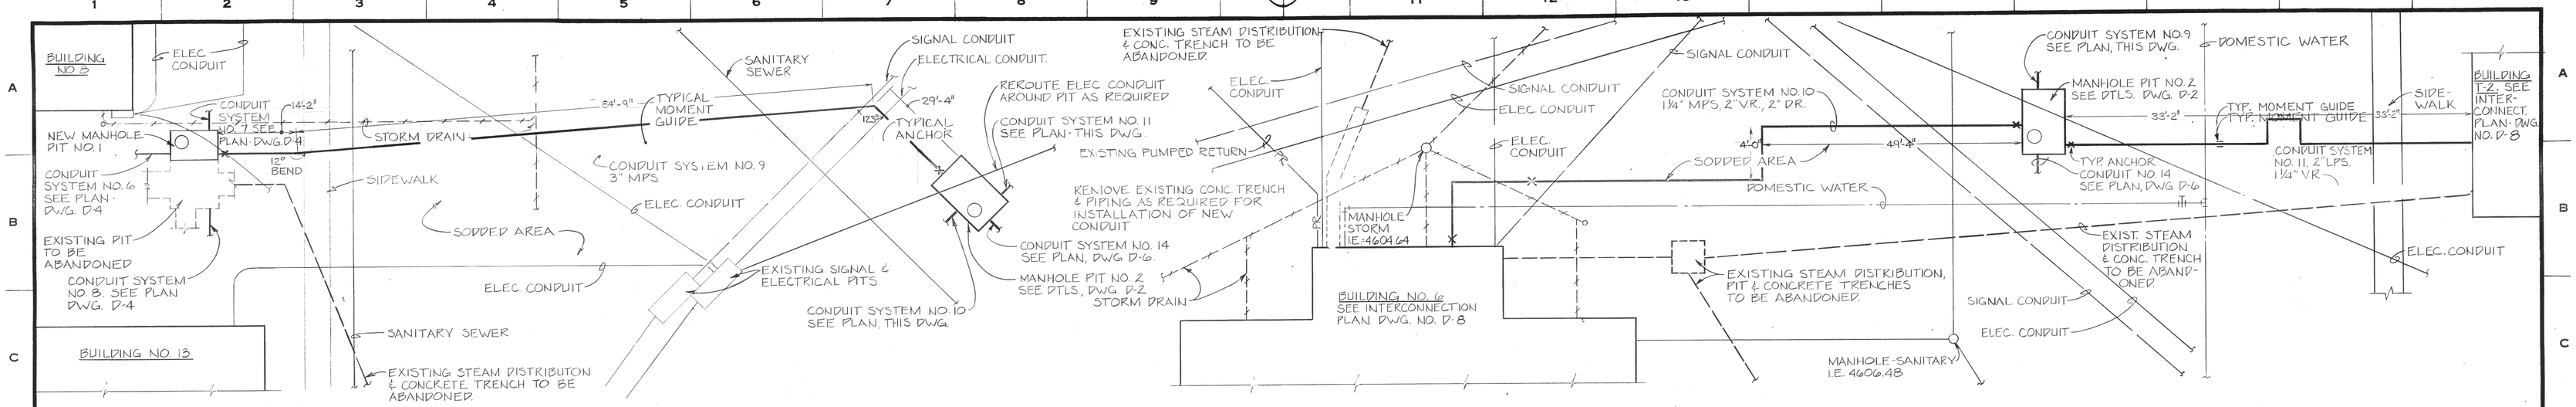

ENLARGED PLAN-CONDUIT SYSTEM NO. 9

SCALE: 1" = 10'-0" AS BUILT

ENLARGED PLAN-CONDUIT SYSTEMS NO. 10 & 11

SCALE: 1" = 10'-0" AS BUILT

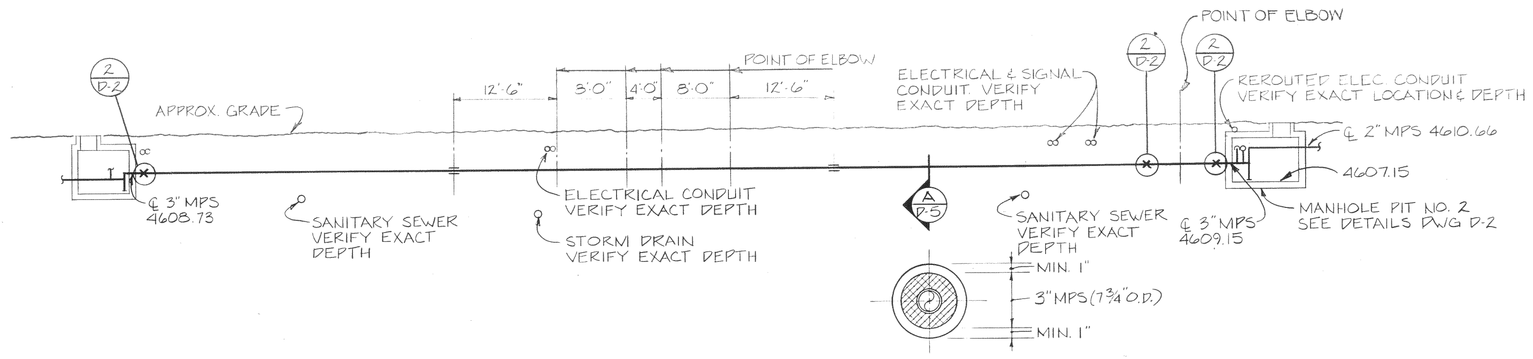

SECTION "A"

SCALE: 1" = 1'-0"

NOTE: PROFILES DO NOT REFLECT ACCURATE PLAN ARRANGEMENT

PROFILE-CONDUIT SYSTEM NO. 9

SCALE: 1" = 10'-0" (HORIZ. & VERT.)

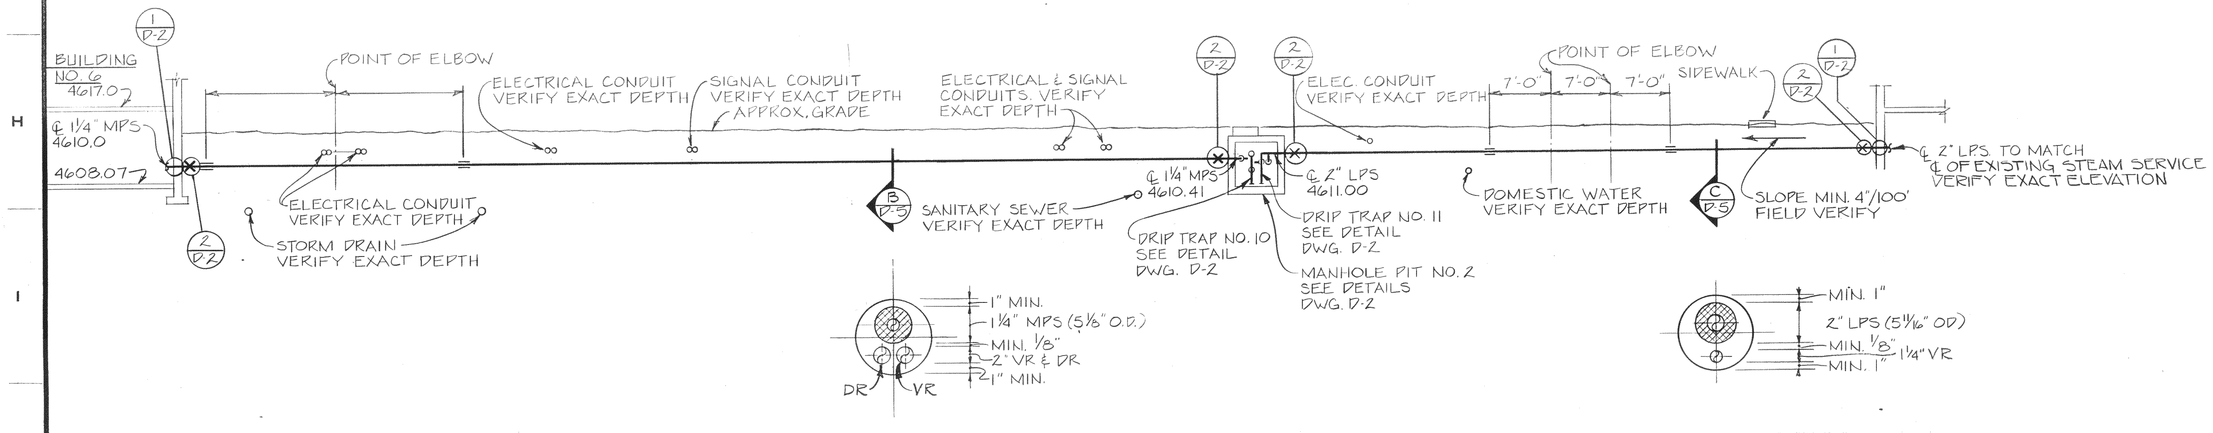

SECTION "B"

SCALE: 1" = 1'-0"

SECTION "C"

SCALE: 1" = 1'-0"

PROFILE-CONDUIT SYSTEMS NO. 10 & 11

SCALE: 1" = 10'-0"

NO.	DATE	DESCRIPTION
1	1-11-82	AS BUILT

REVISIONS

SHEET TITLE: ENLARGED PLANS & PROFILES CONDUIT SYSTEMS 9, 10 & 11

BLDG. NO. / PROJECT TITLE: REPLACE STEAM MAINS

DRAWN: D B RYLATT | CHECKED: W.R. HARMON | DATE: 15 MARCH 1981

APPROVED DIVISION CHIEF

DRAWING NUMBER: D-5

DWG. 5 OF 9

PROJECT NUMBER: 575-80-123

APPROVED ~~SERVICE~~ HECTOR

WILLIAM R. HARMON REGISTERED 6864 PROFESSIONAL ENGINEER STATE OF COLORADO

BHCD ENGINEERS, INC.

VETERANS ADMINISTRATION

LOCATION: 2121 NORTH AVENUE GRAND JUNCTION, CO. 81501

0 10 20 30
1" = 10'-0"

THREE INCHES EQUALS ONE FOOT | ONE AND ONE HALF INCHES EQUALS ONE FOOT | ONE INCH EQUALS ONE FOOT | THREE QUARTER INCH EQUALS ONE FOOT | ONE HALF INCH EQUALS ONE FOOT | THREE EIGHTH INCH EQUALS ONE FOOT | ONE QUARTER INCH EQUALS ONE FOOT | ONE EIGHTH INCH EQUALS ONE FOOT

VA FORM 08-6231, FEB 1973

☆ U. S. GOVERNMENT PRINTING OFFICE 1974 O - 223-322