

SYMBOL LEGEND

- N2O — NITROUS OXIDE PIPING
- G — GAS PIPING
- A — AIR PIPING TO REMAIN
- O — OXYGEN PIPING TO REMAIN
- V — VACUUM PIPING TO REMAIN

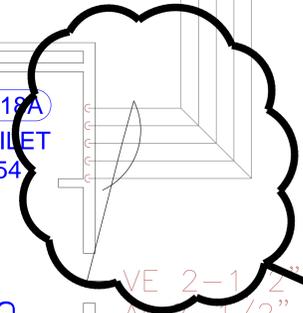


PHOTO TAKEN IN GROUND FLOOR OF MEDICAL GAS PENETRATION THROUGH FIRST FLOOR CONTRACTOR TO WORK AROUND MEDICAL GAS WHILE RENOVATING FIRST FLOOR. FLOOR PLAN MAY BE MODIFIED AS NOT TO DISTURB MEDICAL GAS SYSTEM

FLOOR PLAN

SCALE: 1/4" = 1'-0"


Revision	Date
REVISION: CLARIFICATION IN SCOPE	01 JULY 2013

RECOMMEND APPROVAL			
REQUESTER	Date	CHIEF OF STAFF	Date
CHIEF OF SERVICE	Date	ASSOC. DIR. for OPERATIONS	Date
ASSOC. DIR. PATIENT CARE SVC.	Date		
APPROVAL BY:	Date		
MEDICAL CENTER DIRECTOR			

Drawing Title	MEDICAL GAS EXISTING
Project Title	B-2 ENTRANCE RENOVATION
Approved: Safety Manager/M&O Supervisor	
Approved: Chief of Facilities Management Svr.	

Building Number	BUILDING #2	Checked		Drawn	BLF
Location	W.G.(BII) Hefner Medical Center 1601 Brenner Ave. Salisbury NC 28144				

Date	15 MAR 2013
Project No.	659-13-115
DRAWING NO.	P-105
DWG. 16 OF 28	

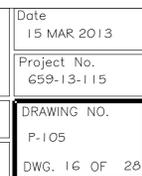

Department of Veterans Affairs