



one eighth inch = one foot  
one quarter inch = one foot  
one half inch = one foot  
three eighths inch = one foot  
one inch = one foot  
one and one half inches = one foot  
two inches = one foot  
three inches = one foot

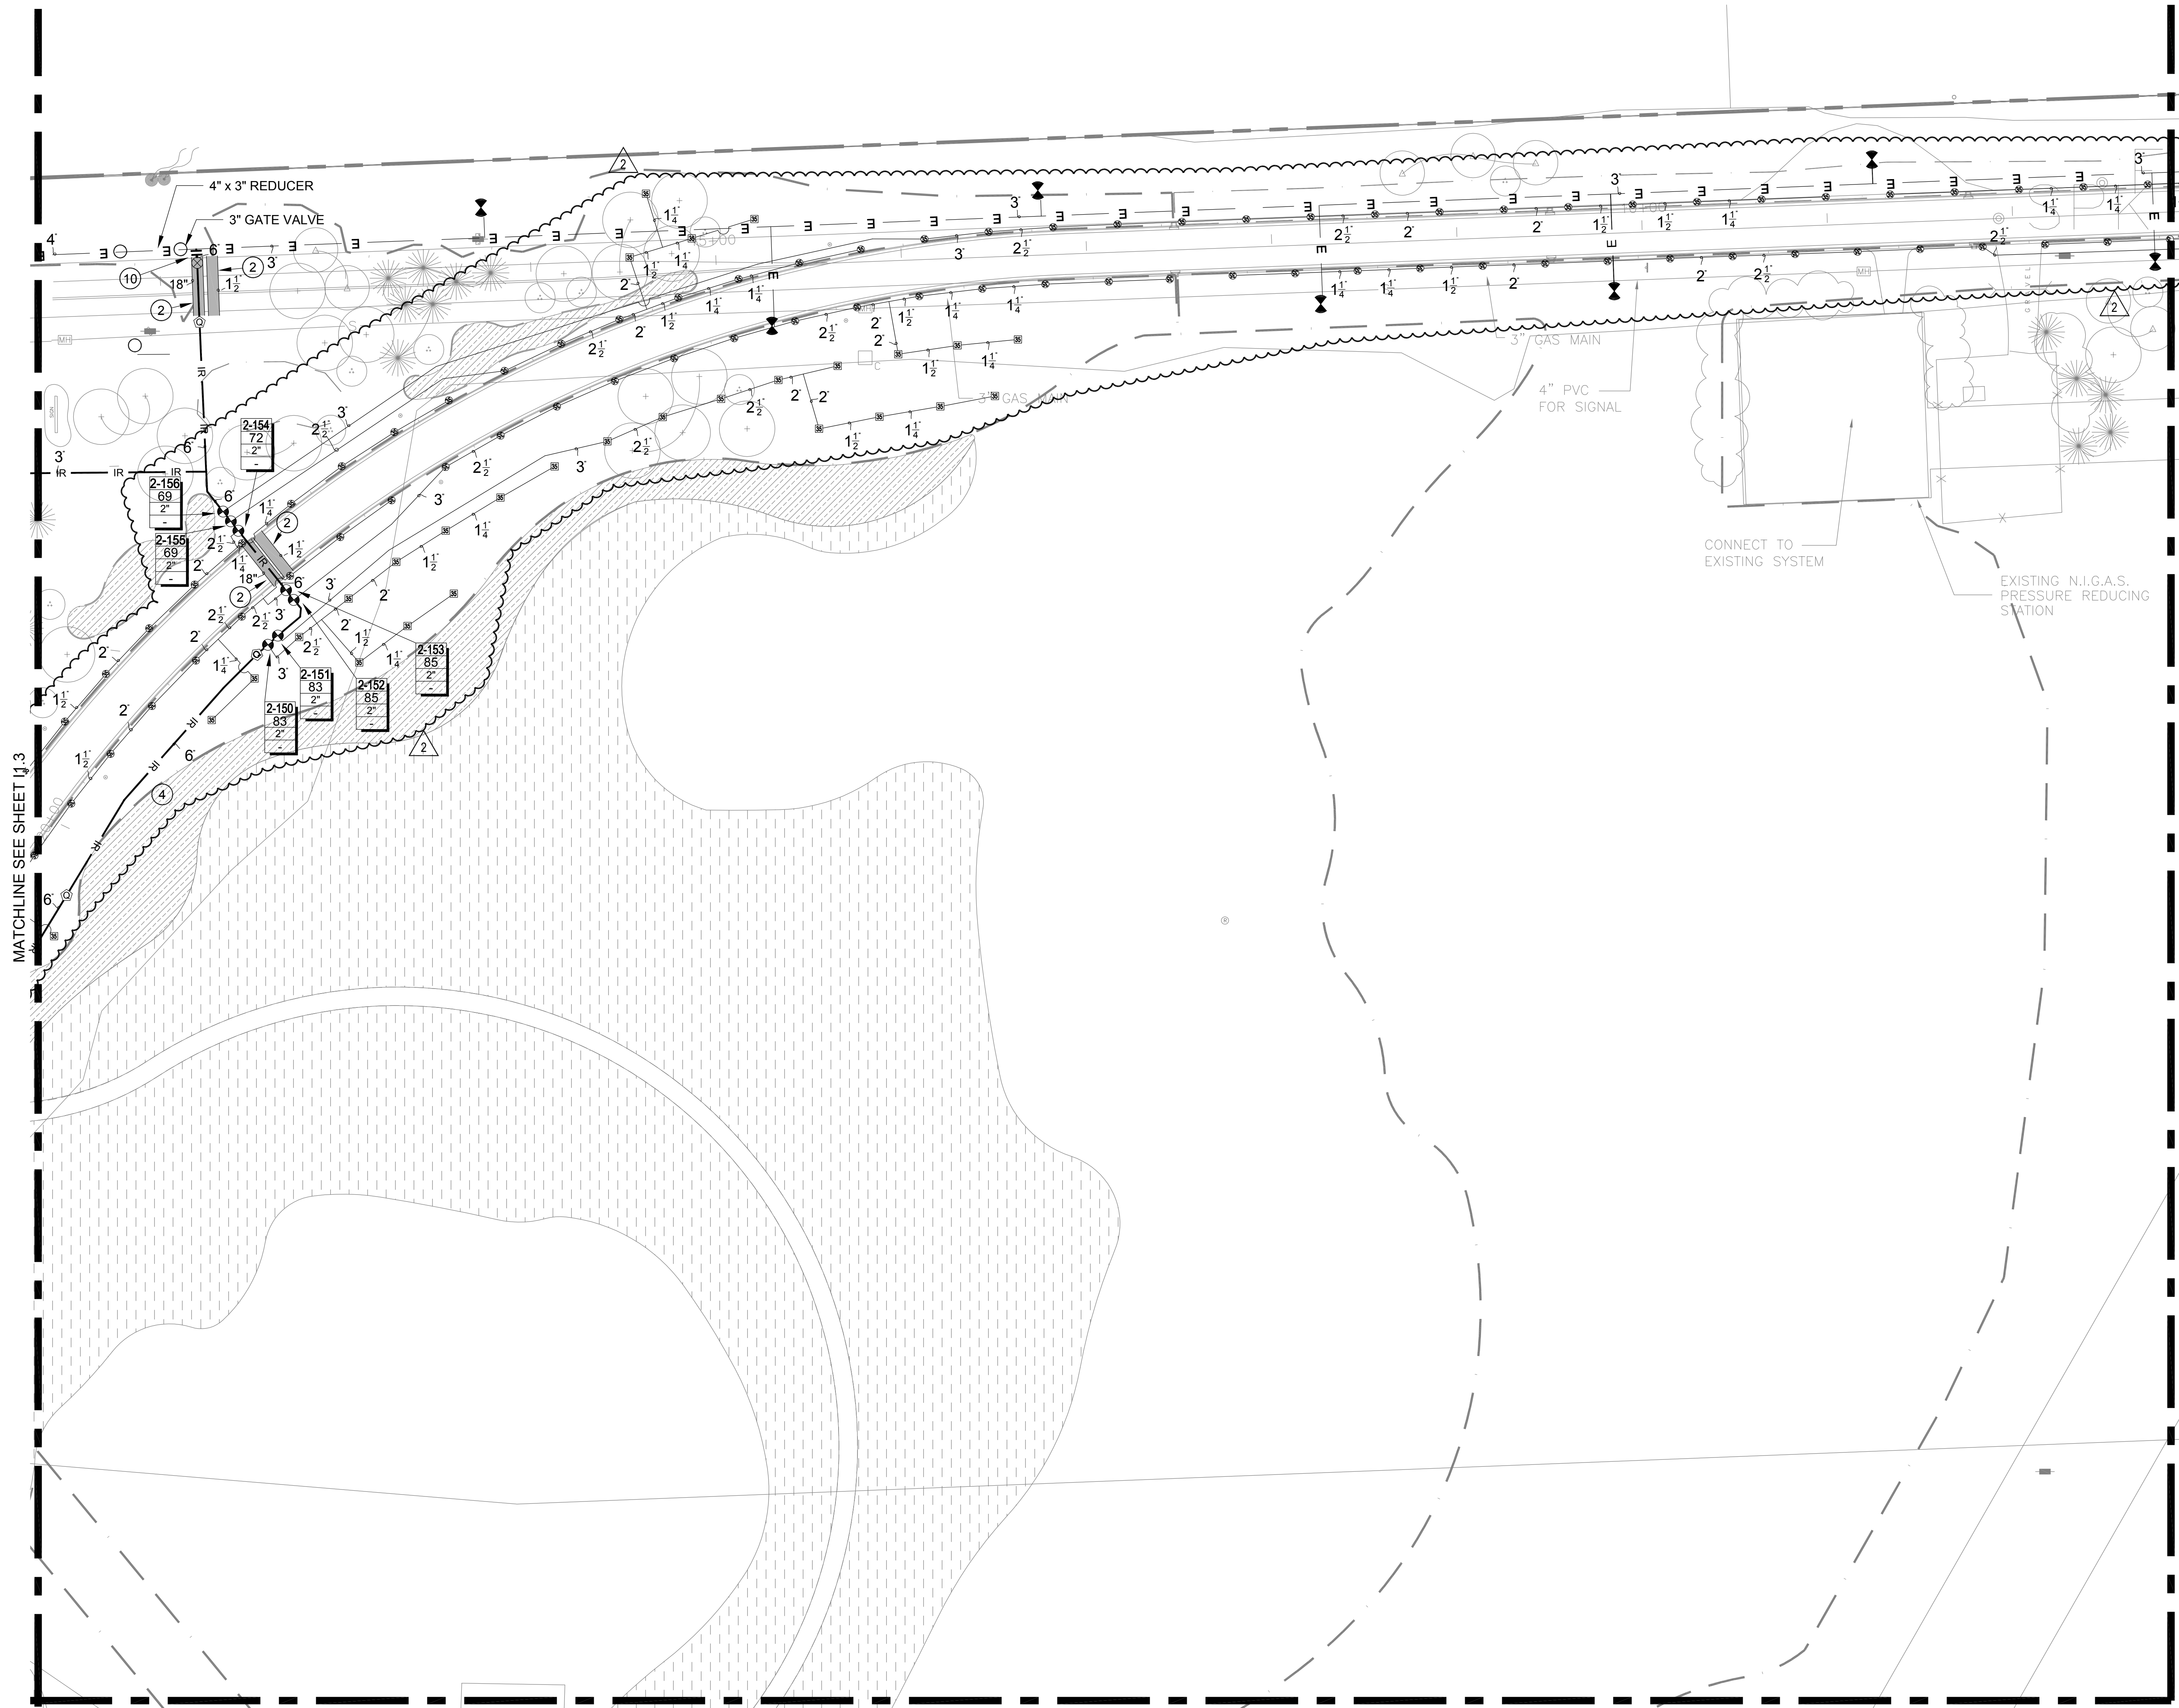

MATCHLINE SEE SHEET 11.5

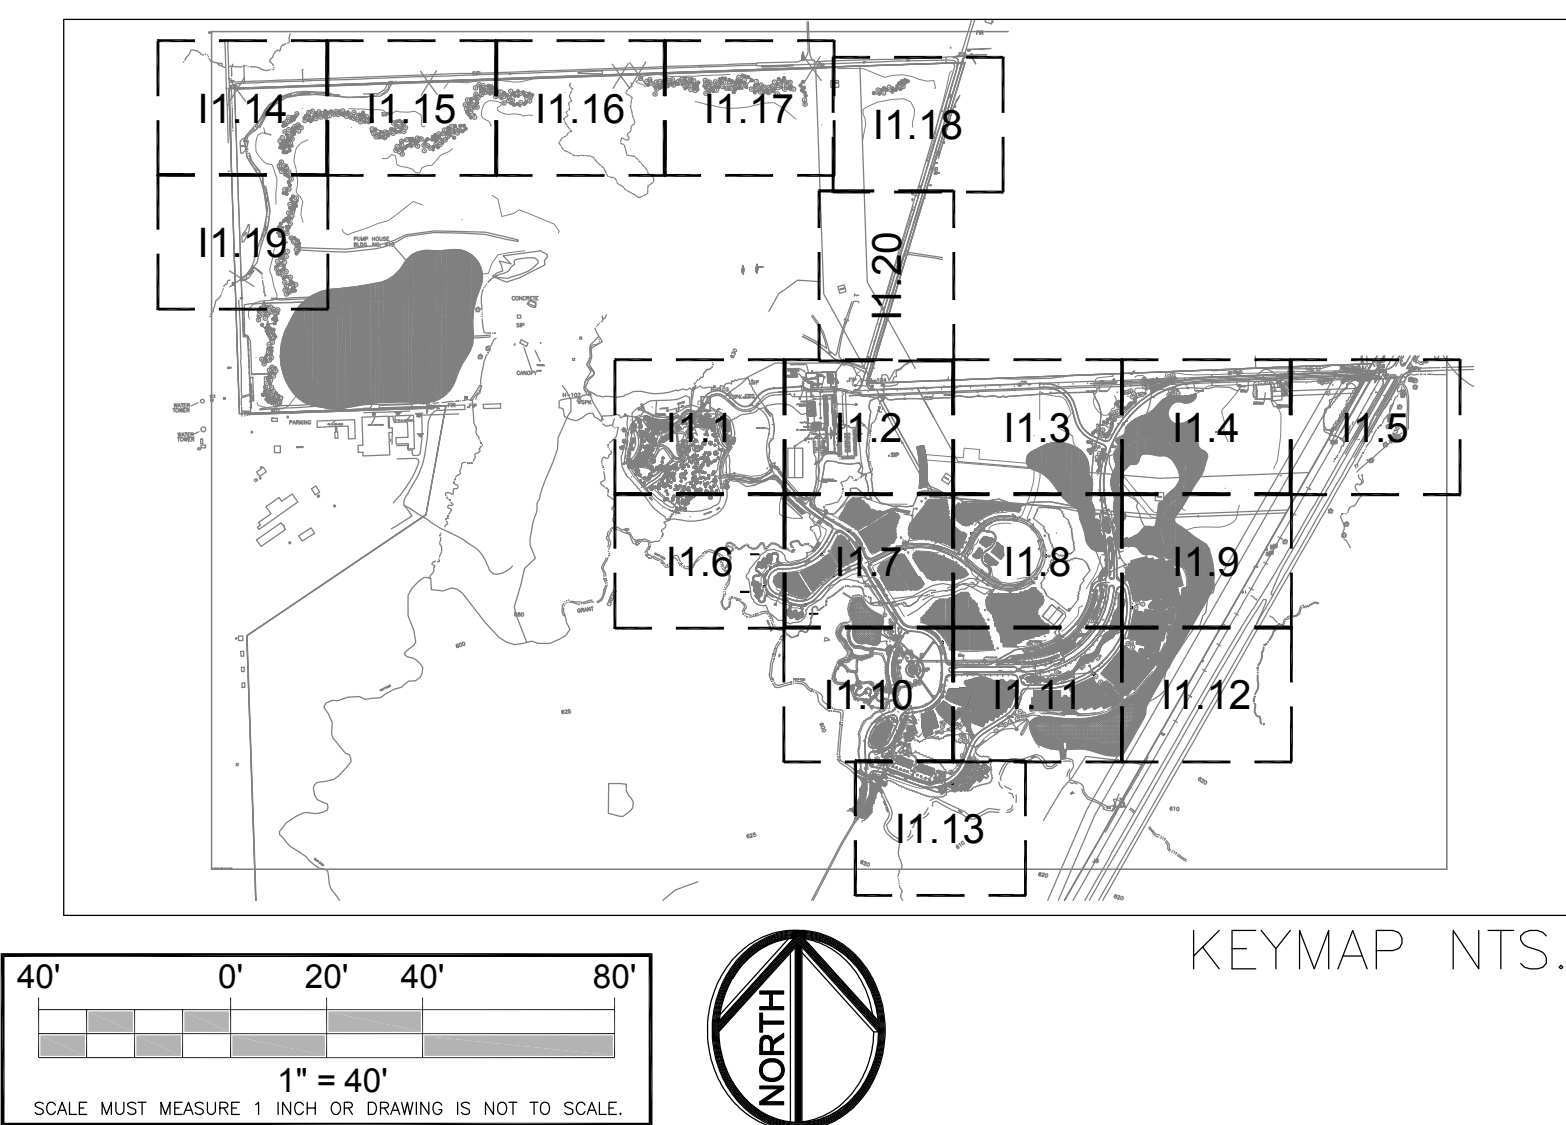

Revision 2	2	11/11/11
Revisions:		Date

**CONSULTANTS:**

**Landmark Engineering**  
3521 West Eisenhower Blvd., Loveland, Colorado 80537  
(970) 667-6286 • Toll Free (866) 379-6282 • Fax (970) 667-6298  
www.landmarkeng.com

**Walton and Associates Architects, P.C.**  
1227 South Sixth Street  
Springfield, Illinois 62703  
Tel: (217) 544-8888 Fax: (217) 544-1881 Email: wa@waltonarchitects.com

**Anderson Engineering of Minnesota, LLC**  
15905 144 Avenue North, Suite 100, Plymouth, MN 55441  
Tel: (763) 418-6000 Fax: (763) 418-6000  
www.ae-minn.com

**Aqua Engineering, Inc.**  
Innovative Water Solutions  
4803 Innovation Drive  
Fort Collins, Colorado 80525  
Phone: (970) 225-9668  
Fax: (970) 226-3855

**JOSE DE AVILA AND ASSOCIATES**  
Electrical and Mechanical Engineers  
6611 W. North Avenue Suite 101  
Oak Park, Illinois 60302  
(708) 383-5330 (708) 383-5871 fax  
www.jda-us.com

**SMITHGROUP**  
architecture engineering interiors planning

**SMITHGROUP, INC.**  
500 GRISWOLD  
SUITE 1700  
DETROIT, MICHIGAN 48226  
T 313.983.3600  
F 313.983.3636  
www.smithgroup.com

**ARCHITECT/ENGINEERS:**

**JJR**  
landscape architecture  
planning  
urban design  
civil engineering  
environmental science

**JJR LLC**  
110 MILLER AVENUE  
ANN ARBOR, MICHIGAN 48104  
734.662.4457 T 734.662.0779 F  
www.jjr-us.com

Drawing Title  
**IRRIGATION PLAN  
AREA D**

Approved Project Director

Project Title  
**ABRAHAM LINCOLN NATIONAL  
CEMETERY - PHASE 2 GRAVESITE  
EXPANSION AND IMPROVEMENTS**

Location  
**ELWOOD, ILLINOIS**

Date  
2010/05/13

Checked  
2010/04/12

Drawn  
JDL/CAM

Project Number  
**915PC2003**

Drawing Reference Number  
**260**

Drawing Number  
**11.4**

Office of  
Construction  
and Facilities  
Management

Department of  
Veterans Affairs