

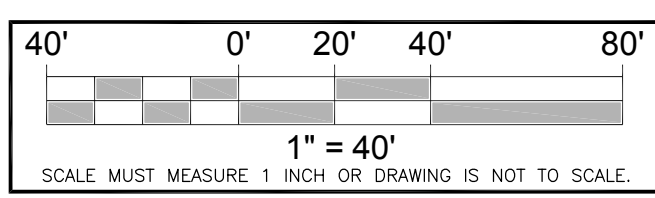


three inches = one foot
one inch = one foot
one and one half inches = one foot
three quarters inch = one foot
one half inch = one foot
three eighths inch = one foot
one quarter inch = one foot
one eighth inch = one foot

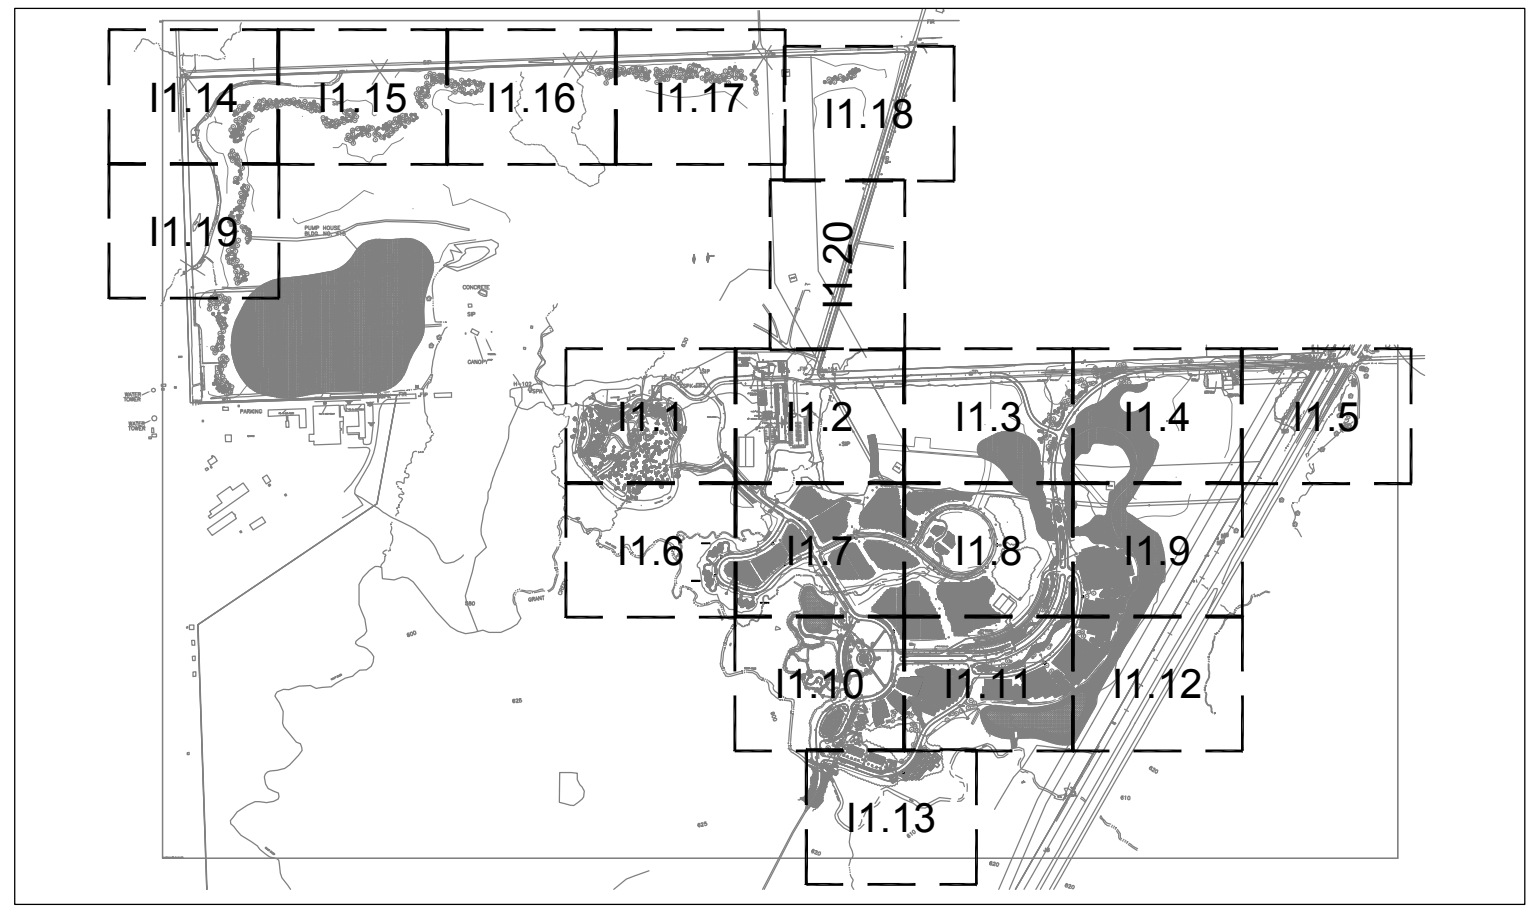

Revision 2	2	11/11/11
Revisions:		Date

CONSULTANTS:

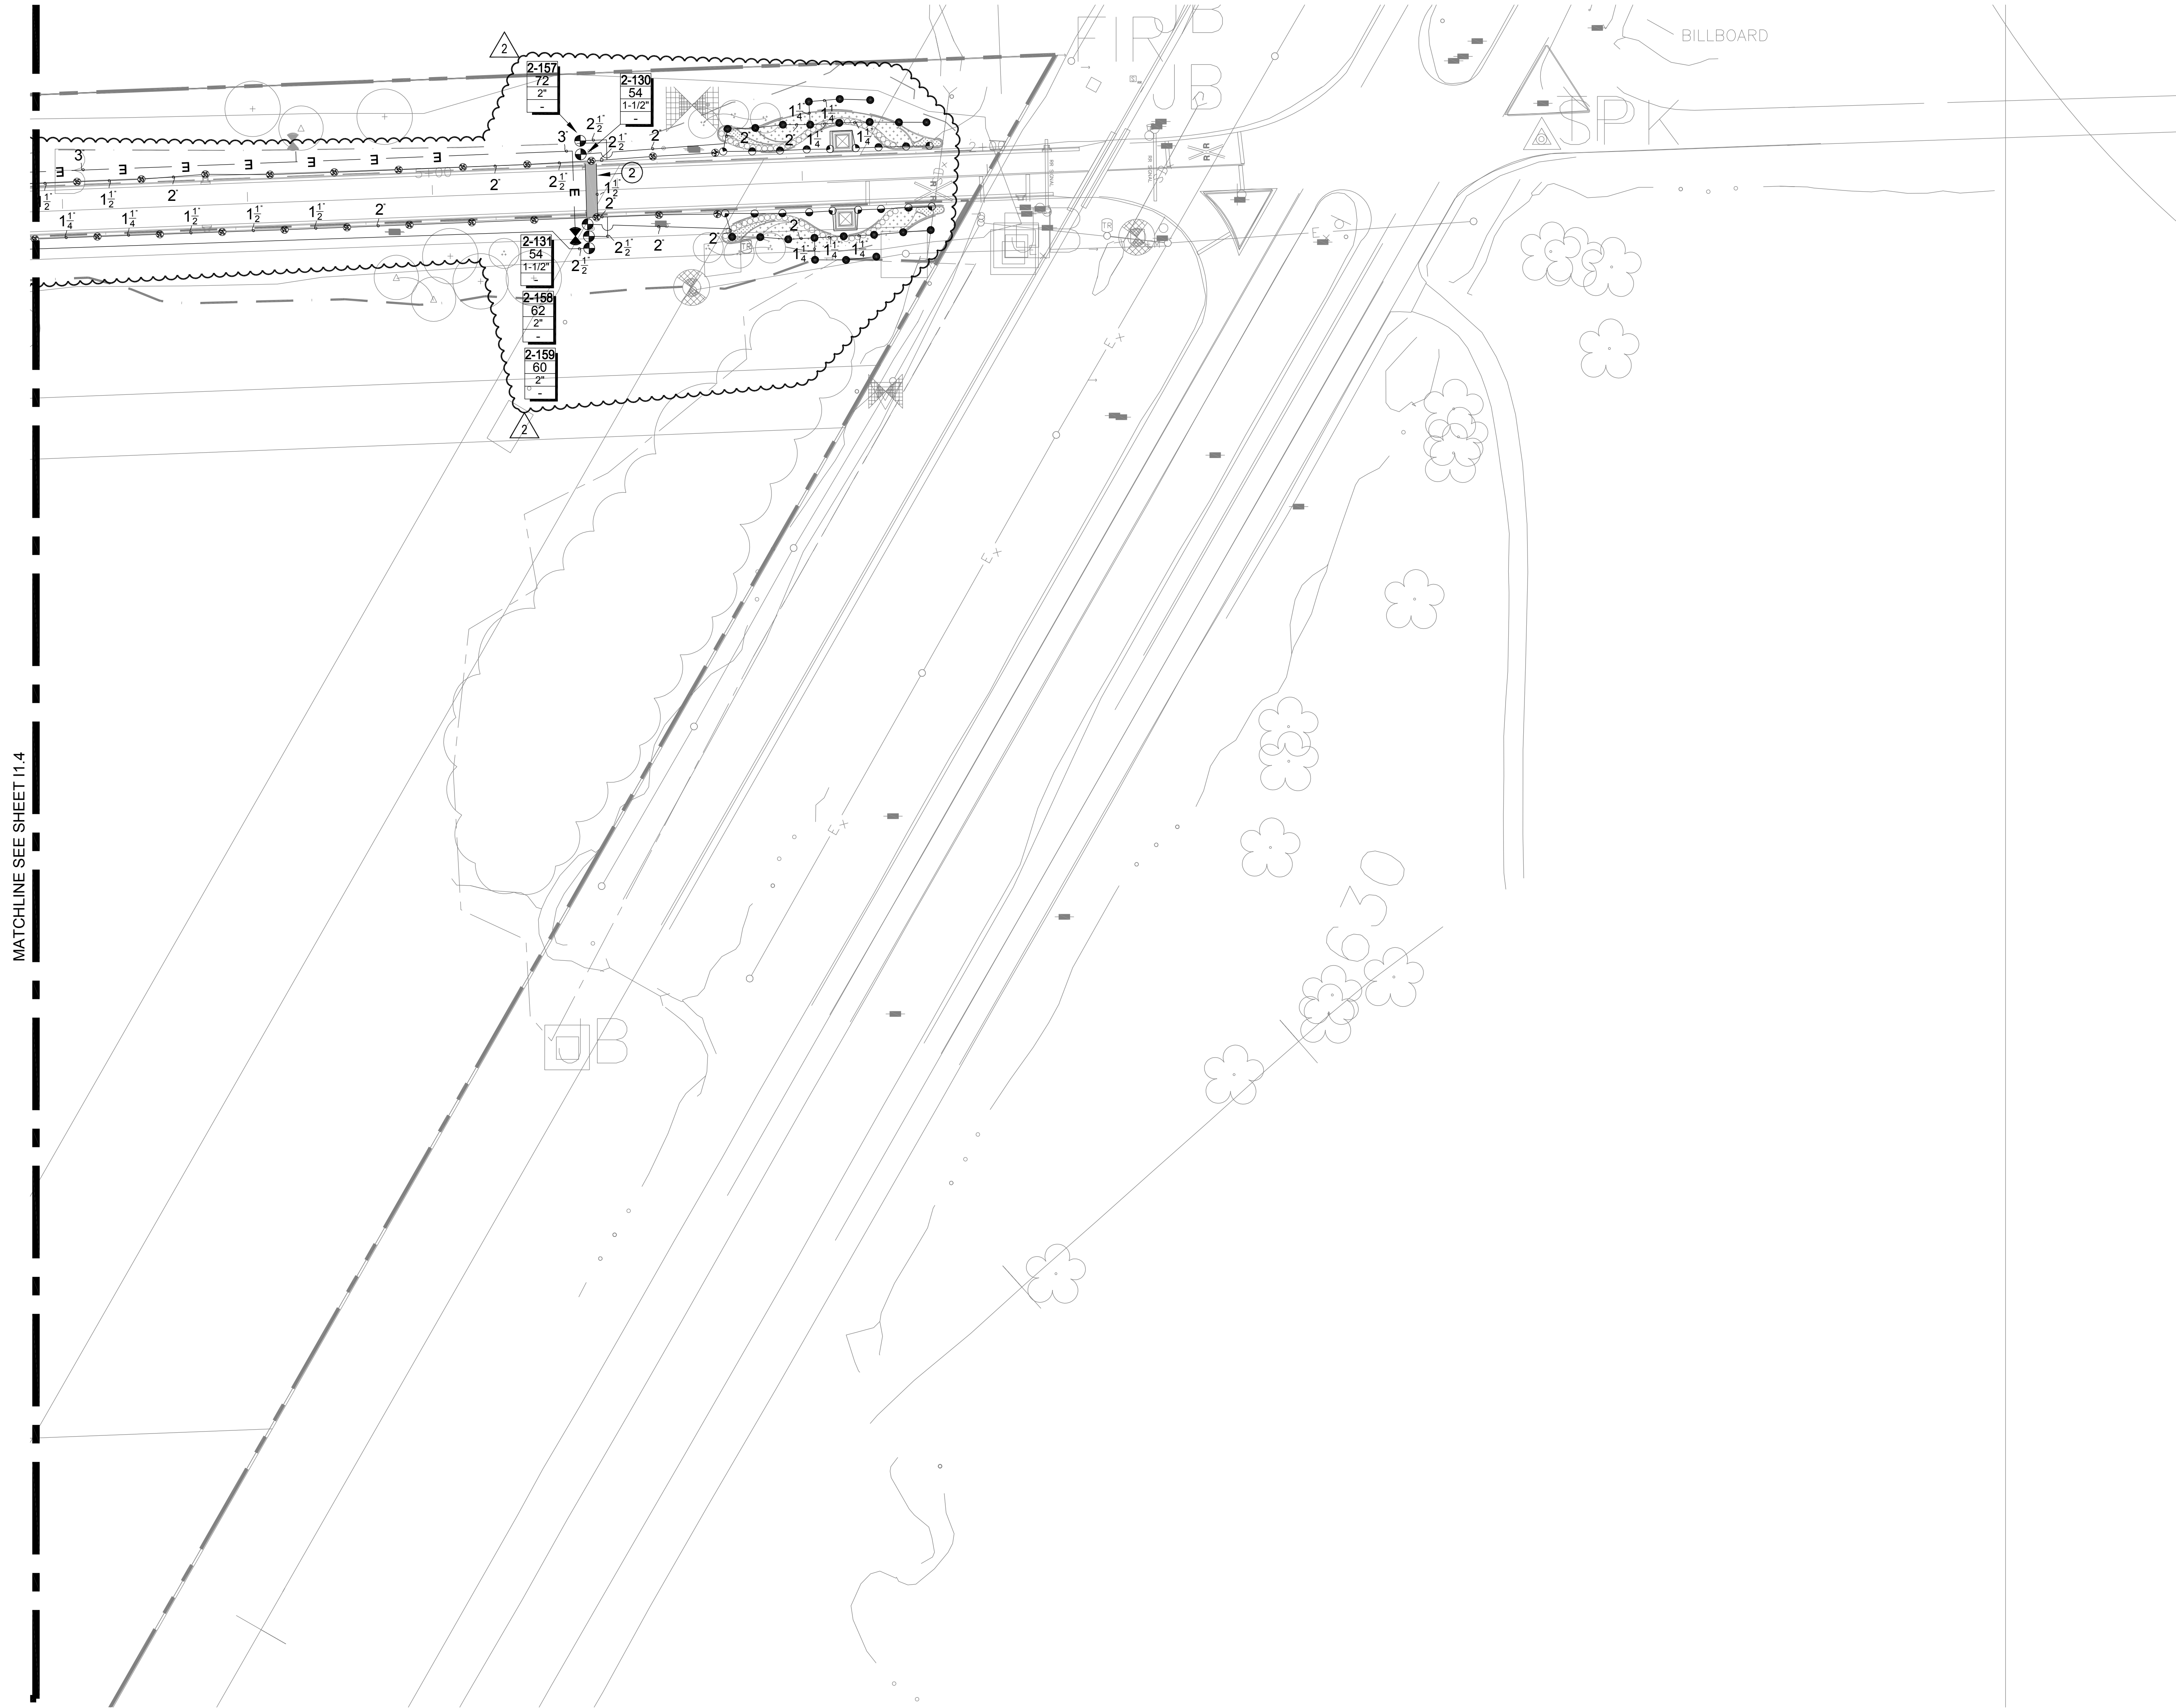

Walton and Associates Architects, P.C.
1227 South Sixth Street
Springfield, Illinois 62703
Tel: (217) 544-5888 Fax: (217) 544-1881 Email: wa@waltonarchitects.com



Anderson Engineering of Minnesota, LLC

15905 144 AVENUE NORTH, SUITE 100, FLYNNCREEK, MN 55441
TEL: (763) 418-6000 FAX: (763) 418-6000
www.ae-mn.com



JOSE DE AVILA AND ASSOCIATES
Electrical and Mechanical Engineers
6611 W. North Avenue Suite 101
Oak Park, Illinois 60302
(708) 383-5330 (708) 383-5871 fax



SMITHGROUP

architecture engineering interiors planning
SMITHGROUP, INC.
500 GRISWOLD
SUITE 1700
DETROIT, MICHIGAN 48226
T 313.983.3600
F 313.983.3636
www.smithgroup.com

ARCHITECT/ENGINEERS:



landscape architecture
planning
urban design
civil engineering
environmental science
JJR LLC
110 MILLER AVENUE
ANN ARBOR, MICHIGAN 48104
734.662.4457 T 734.662.0779 F
www.jjr-us.com

Drawing Title	IRRIGATION PLAN AREA E
Approved Project Director	

Project Title	ABRAHAM LINCOLN NATIONAL CEMETERY - PHASE 2 GRAVESITE EXPANSION AND IMPROVEMENTS
Location	ELWOOD, ILLINOIS
Date	2010/05/13
Checked	2010/04/12
Drawn	JDL/CAM

Project Number	915PC2003
Drawing Reference Number	261
Drawing Number	11.5

Office of
Construction
and Facilities
Management