

- NOTES:
- 3" RED TEXT ON WHITE BACKGROUND
 - PLACARD 11" X 11" WITH BLACK LETTERS
 - COLOR BEHIND 3 IS RED
 - COLOR BEHIND 1 IS BLUE
 - COLOR BEHIND 0 IS YELLOW
 - COLOR OF EMPTY SECTION IS WHITE

(7902.1.3.1) **1** STORY BOARD
DFS 4.0 SCALE: NONE

2.1 DFS 4.0

VEEDER ROOT

2.2 DFS 4.0

FUEL CONTROL PANEL

2.3 DFS 4.0

FUEL LOG

- NOTES:
- 3/4" BLACK LETTERING ON WHITE BACKGROUND
 - 1.0" TAPE

2.X LETTERING STICKER
DFS 4.0 SCALE: NONE

3.1 DFS 4.0

← DISPENSOR VAPOR RETURN ←

3.2 DFS 4.0

← E85 FUEL SUPPLY ←

3.3 DFS 4.0

VAPOR RETURN


3.4 DFS 4.0

FUEL VENT

- NOTES:
- 1-1/4" BLACK LETTERING ON YELLOW BACKGROUND WITH FLOW DIRECTION ARROWS.

3.X LETTERING STICKER
DFS 4.0 SCALE: NONE

4.1 DFS 4.0

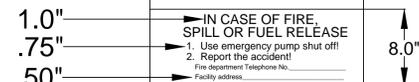


(5201.6.3) PLACE TEXT AS SHOWN TEXT HEIGHT AS INDICATED ON WHITE BACKGROUND

4.2 DFS 4.0



(5201.9) PLACE 2.0" BLACK TEXT AS SHOWN. WHITE BACKGROUND

4.3 DFS 4.0

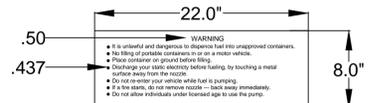

(5201.9) PLACE TEXT AS SHOWN TEXT HEIGHT AS INDICATED ON WHITE BACKGROUND

4.X LETTERING STICKER
DFS 4.0 SCALE: NONE

5.1 DFS 4.0

NO SMOKING

5.2 DFS 4.0

ATTENTION: ALARM SOUNDS AT 85% FILLED

- NOTES: 3" HIGH BLACK LETTERS BACKGROUND: WHITE, HEIGHT AS INDICATED, EXTEND 2.0" BEYOND END OF TEXT

5.X LETTER SIGN
DFS 4.0 SCALE: NONE

AS BUILT
09/17/08

FUEL OIL SYSTEMS

1558 "B" STREET HAYWARD CALIFORNIA
PH 510 727 6701 FAX 510 888 1755
WWW.FUELOILSYSTEMS.NET, EMAIL: INFO@FUELOILSYSTEMS.NET

**E85 DISPENSING SYSTEM
SINAGE DETAILS**

REVISION: 0	SPEC:	SHT 1 OF 2
SUBMITTAL:	JOB: SAN FRANCISCO VA E85	
REF DWG.:	SCALE: NONE	
APPROVED: CA HASKINS	DFS-4.1	
DATE: 9/12/07		