










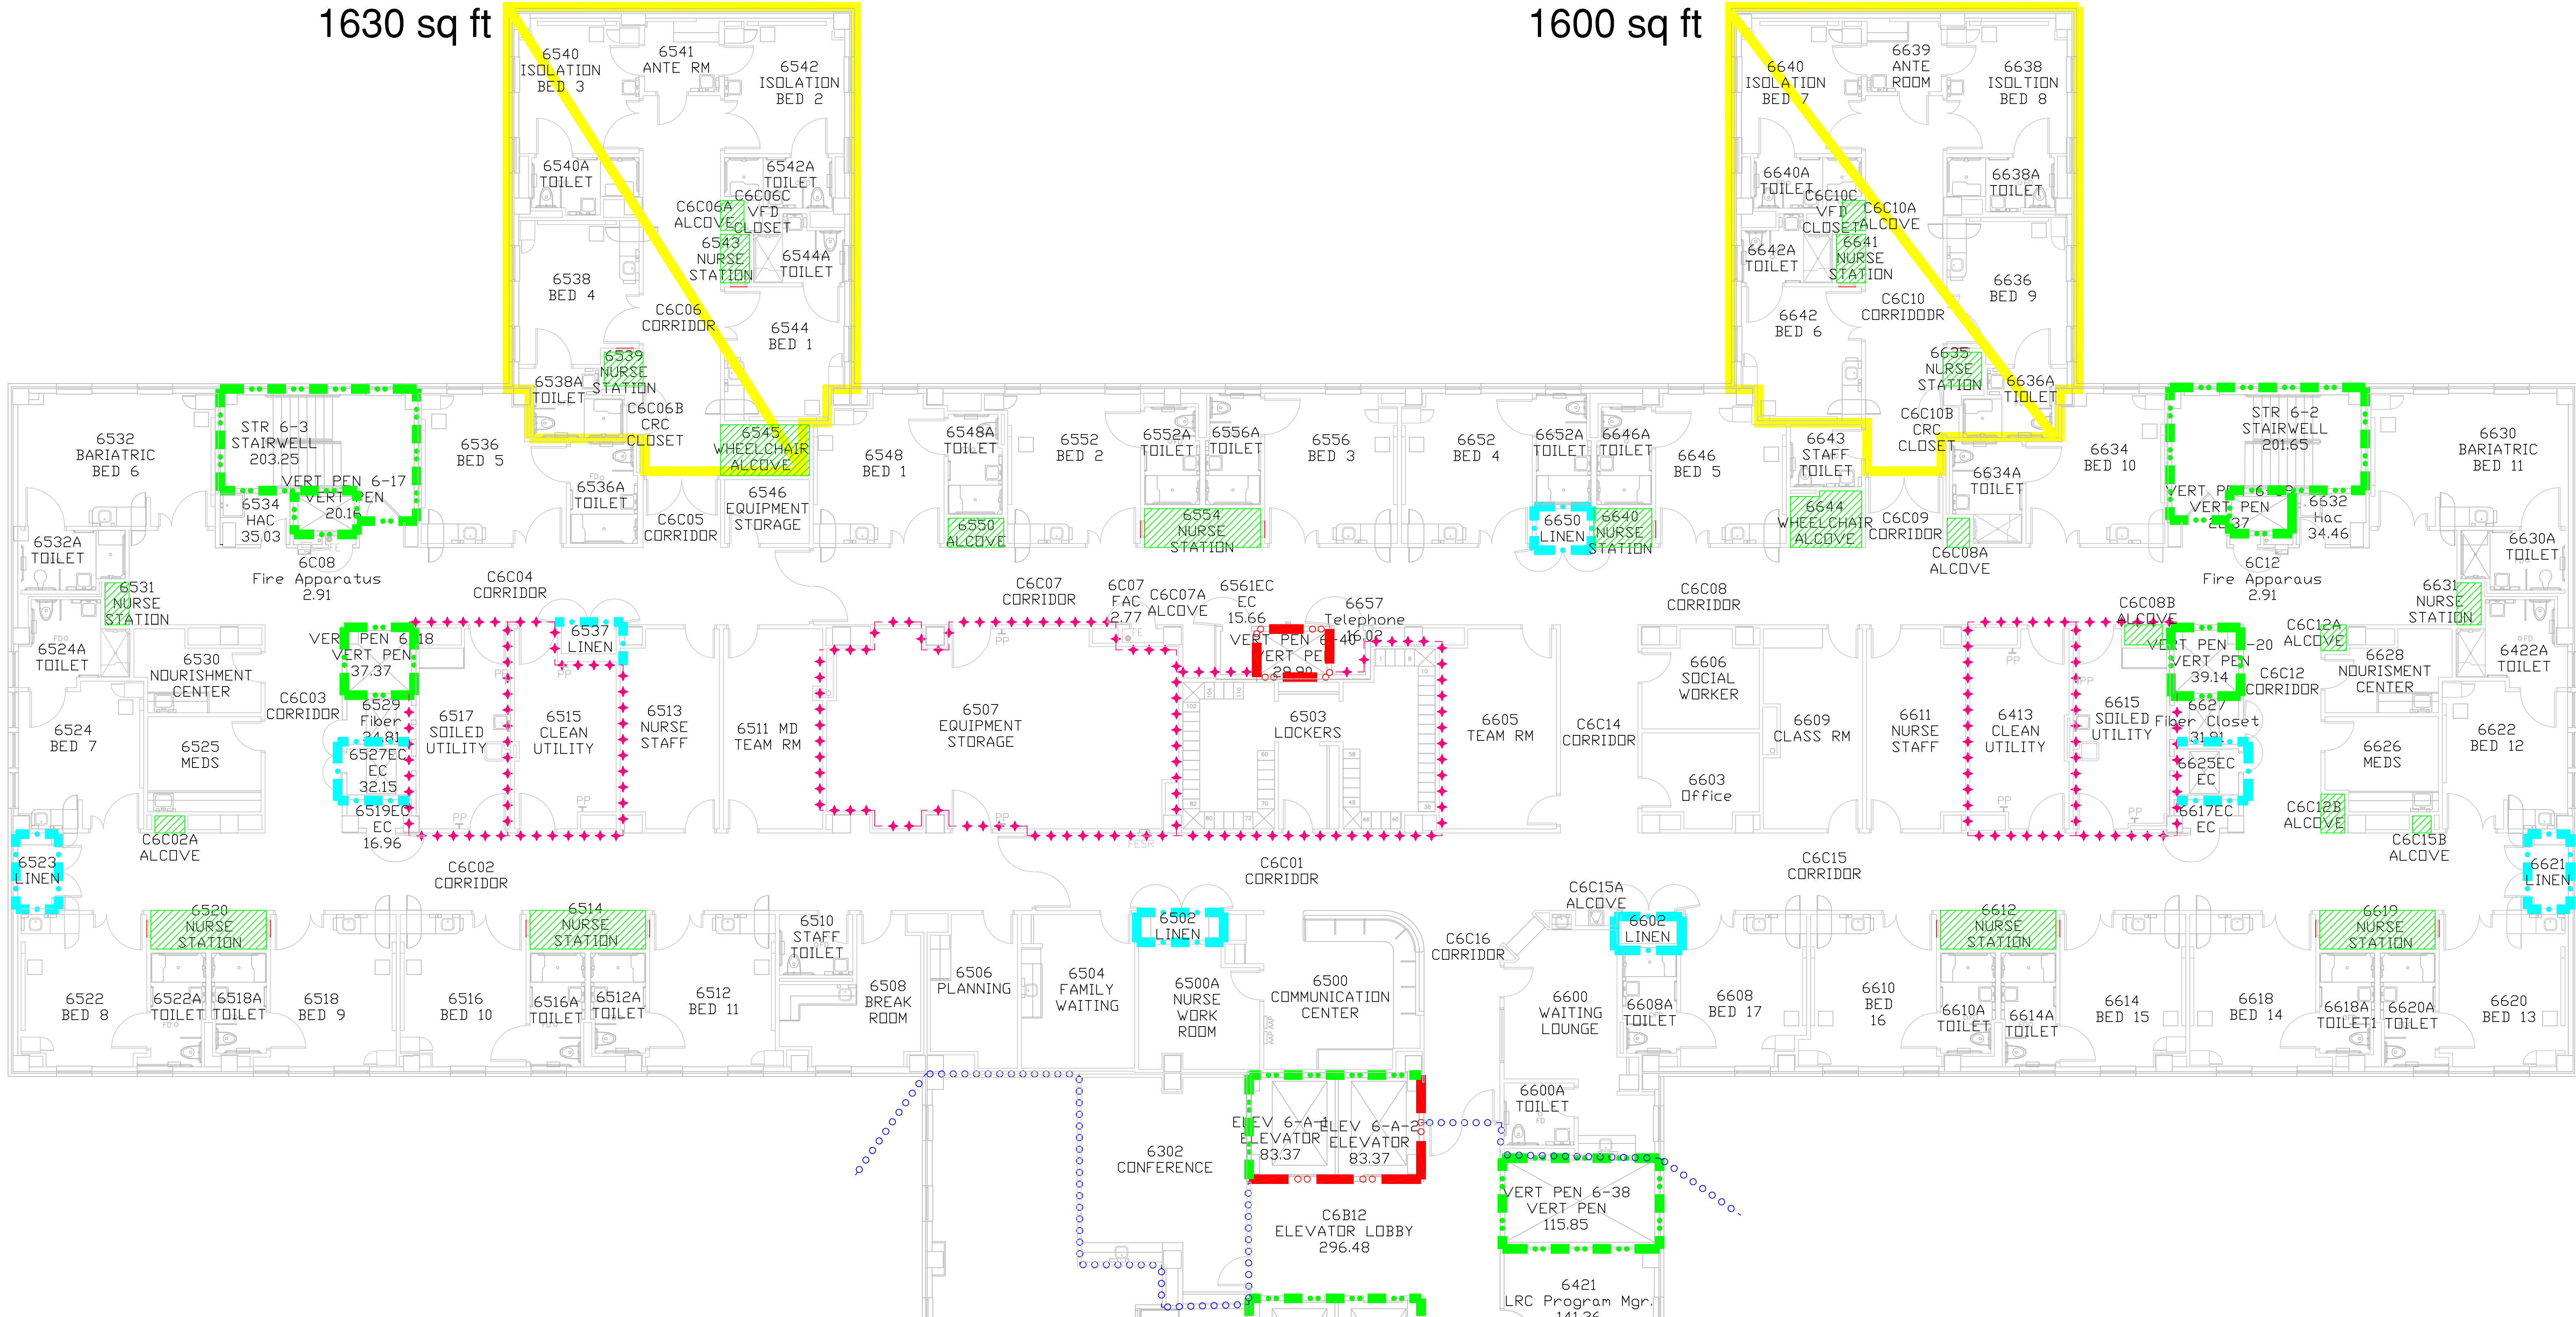




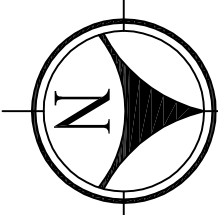
1630 sq ft

1600 sq ft



## SYMBOLS LIST


- |  |   |
|--|---|
|  | 2 HOUR FIREWALL                                     |
|  | 1 HOUR FIREWALL                                     |
|  | 2 HOUR FIRE/SMOKEWALL                               |
|  | 1 HOUR FIRE/SMOKEWALL                               |
|  | 30 MINUTE SMOKE BARRIER                             |
|  | SMOKE RESISTIVE HAZARDOUS AREA                      |
|  | HORIZONTAL EXIT PASSAGEWAY                          |
|  | EXIT  |
|  | EXIT PASSAGEWAY                                     |
|  | LINEN CHUTE   |
|  | SUITE DESIGNATIONS                                  |
|  | AREA OPEN TO CORRIDOR – WITH SMOKE DETECTION        |
|  | AREA OPEN TO CORRIDOR – NO SMOKE DETECTION REQUIRED |



BUILDING 111 SIXTH FLOOR

## FULLY SPRINKLERED HEALTHCARE OCCUPANCY

Revisions		Date
FP&C Proj.#:		1751-16



Dept. of Veterans Affairs  
Medical Center  
5000 W. National Ave.  
Milwaukee, WI 53295

Approved: Chief, Facilities Management Services		Project Title <b>STATEMENT OF CONDITIONS</b>		Drawing Title <b>BUILDING 111 SIXTH FLOOR-C WING</b>		Date 07/02/12	
Approved: Medical Center Director						Scale: 1/16"=1'-0"	
Approved:		Client Project No.	Contract No.	Designed By BAA	Drawn By SFF/JV	Checked By BAA	Drawing No. <b>SOC-7</b>
Approved:		Building No. BUILDING 111	AutoCAD File Name SOC07-111-06	Location VA MEDICAL CENTER MILWAUKEE, WISCONSIN		Dwg. xx of 14	

Department of Veterans Affairs

