



three inches = one foot
one and one half inches = one foot
one inch = one foot
three quarters inch = one foot
one half inch = one foot
three eighths inch = one foot
one quarter inch = one foot
one eighth inch = one foot

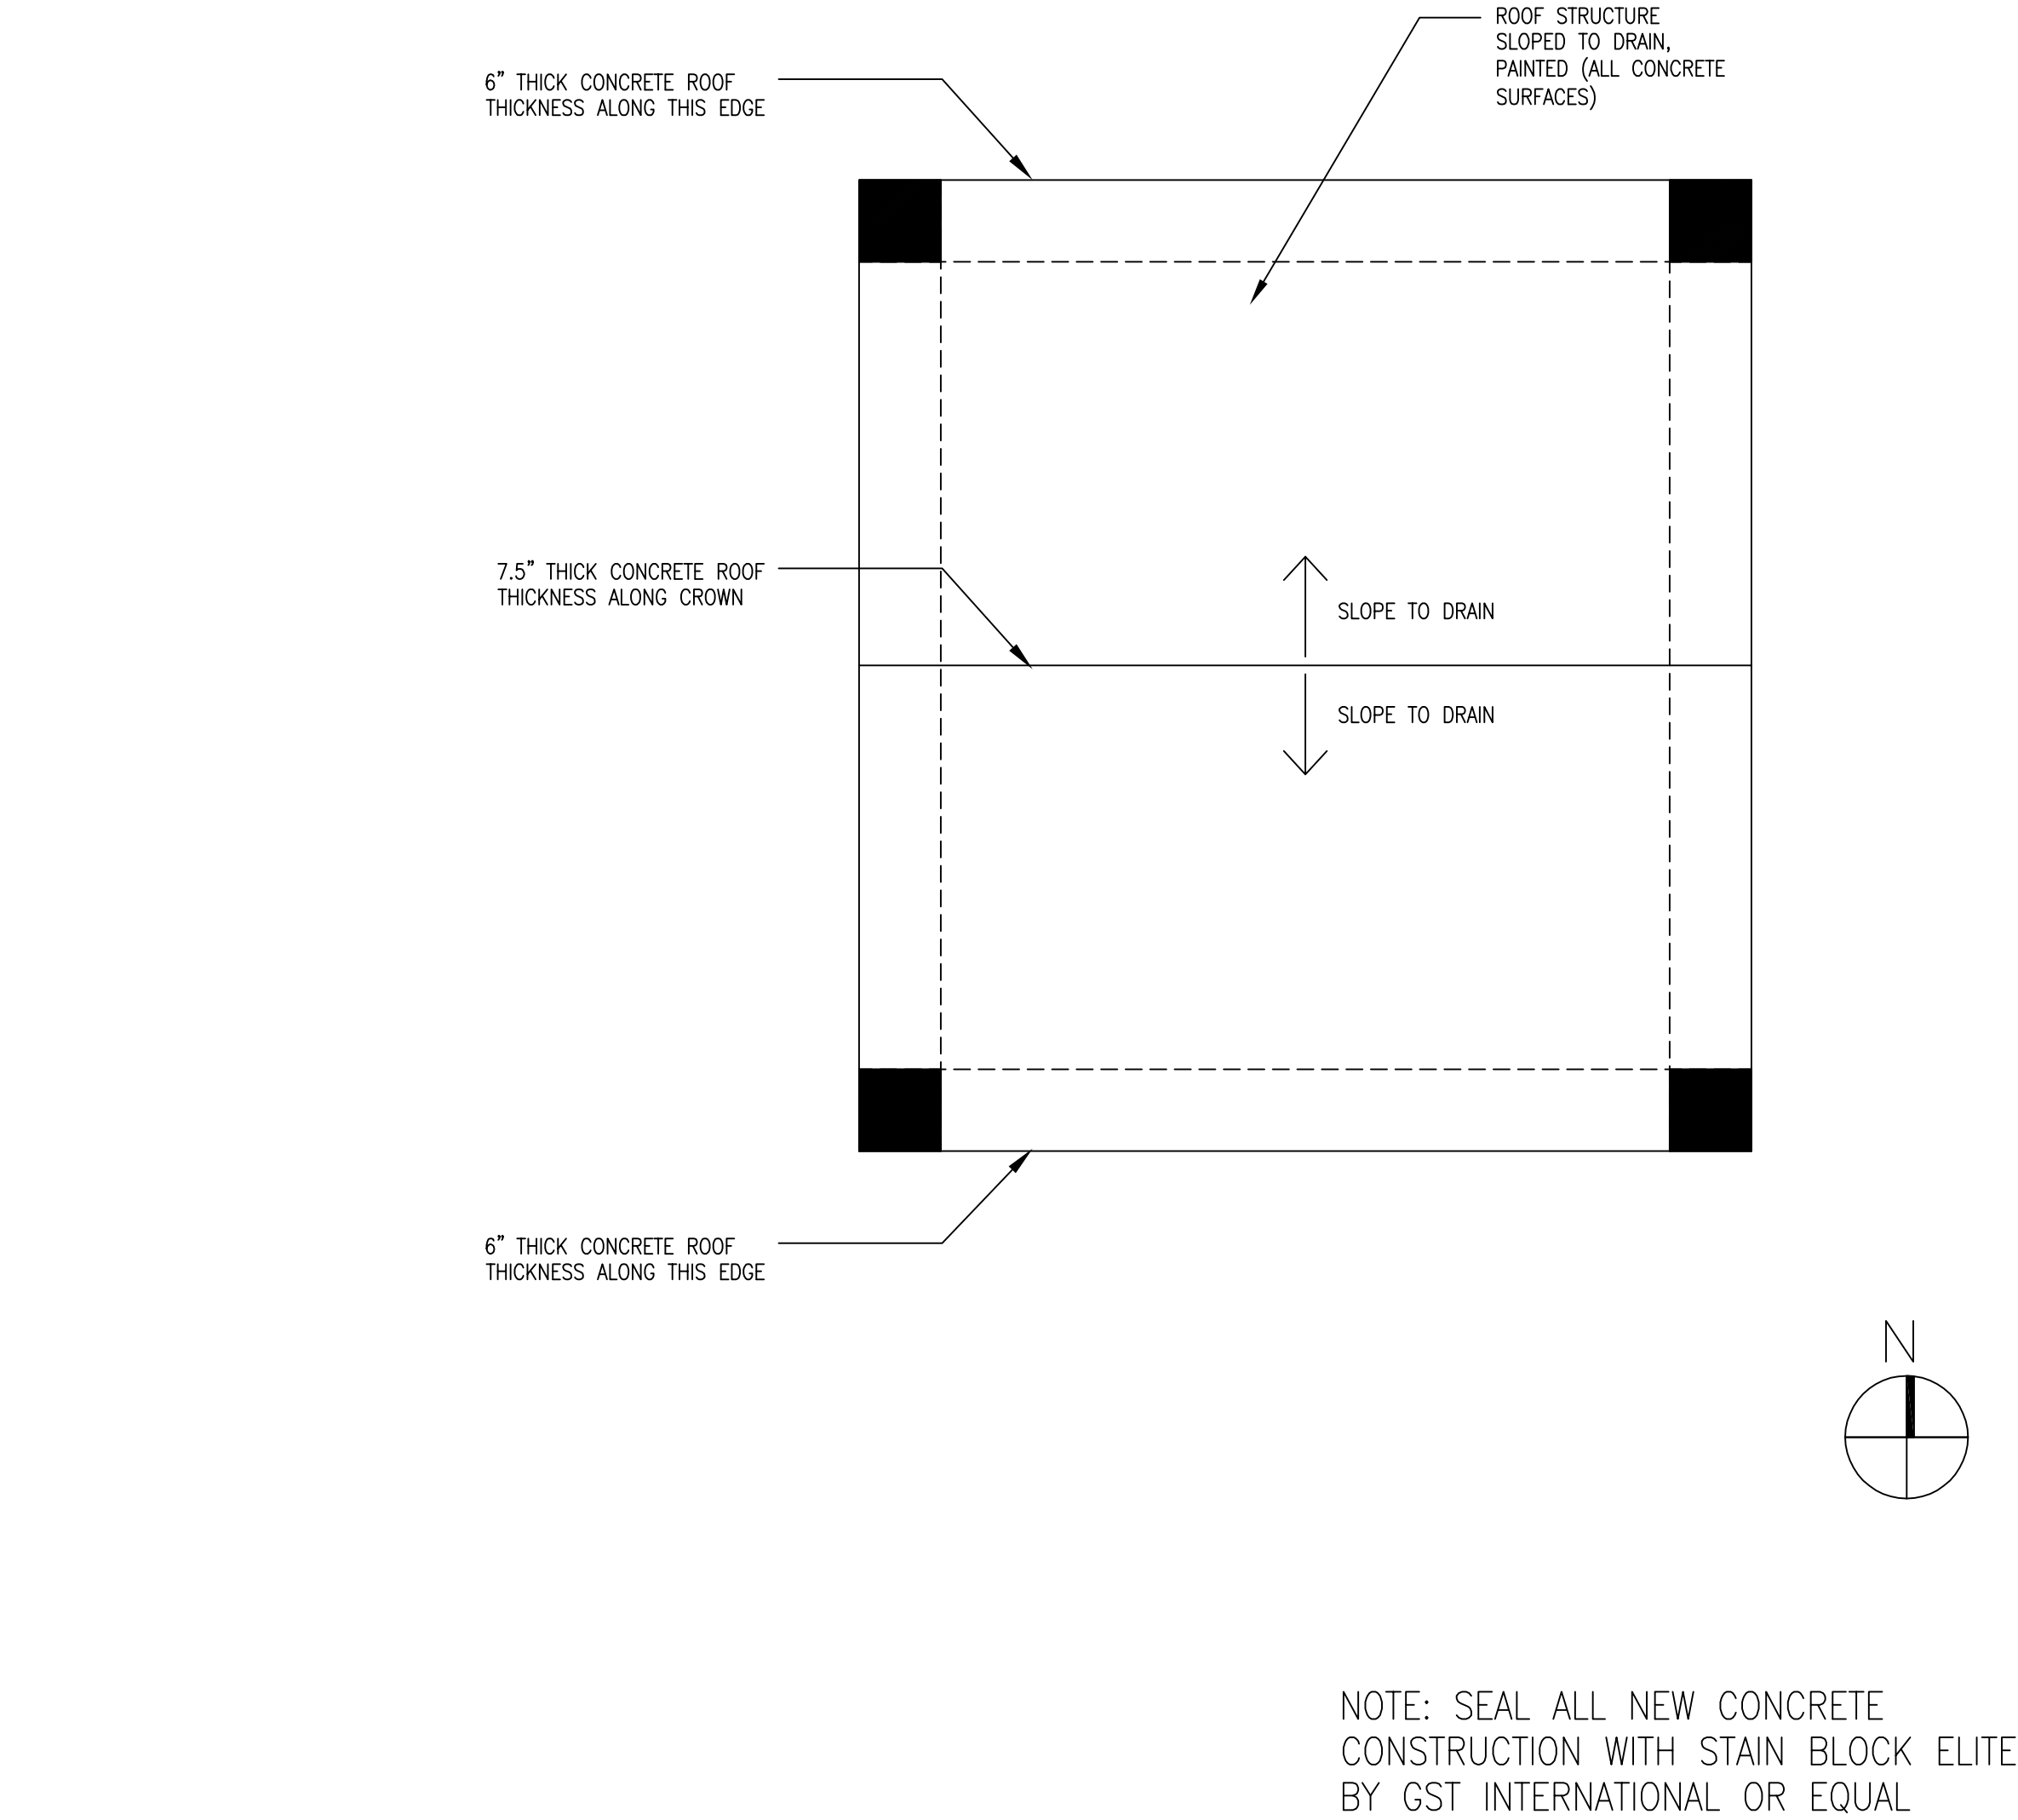

| | | |
|----|----------------|---------|
| 2 | AMENDMENT NO.2 | 7.22.13 |
| No | REVISION | DATE |

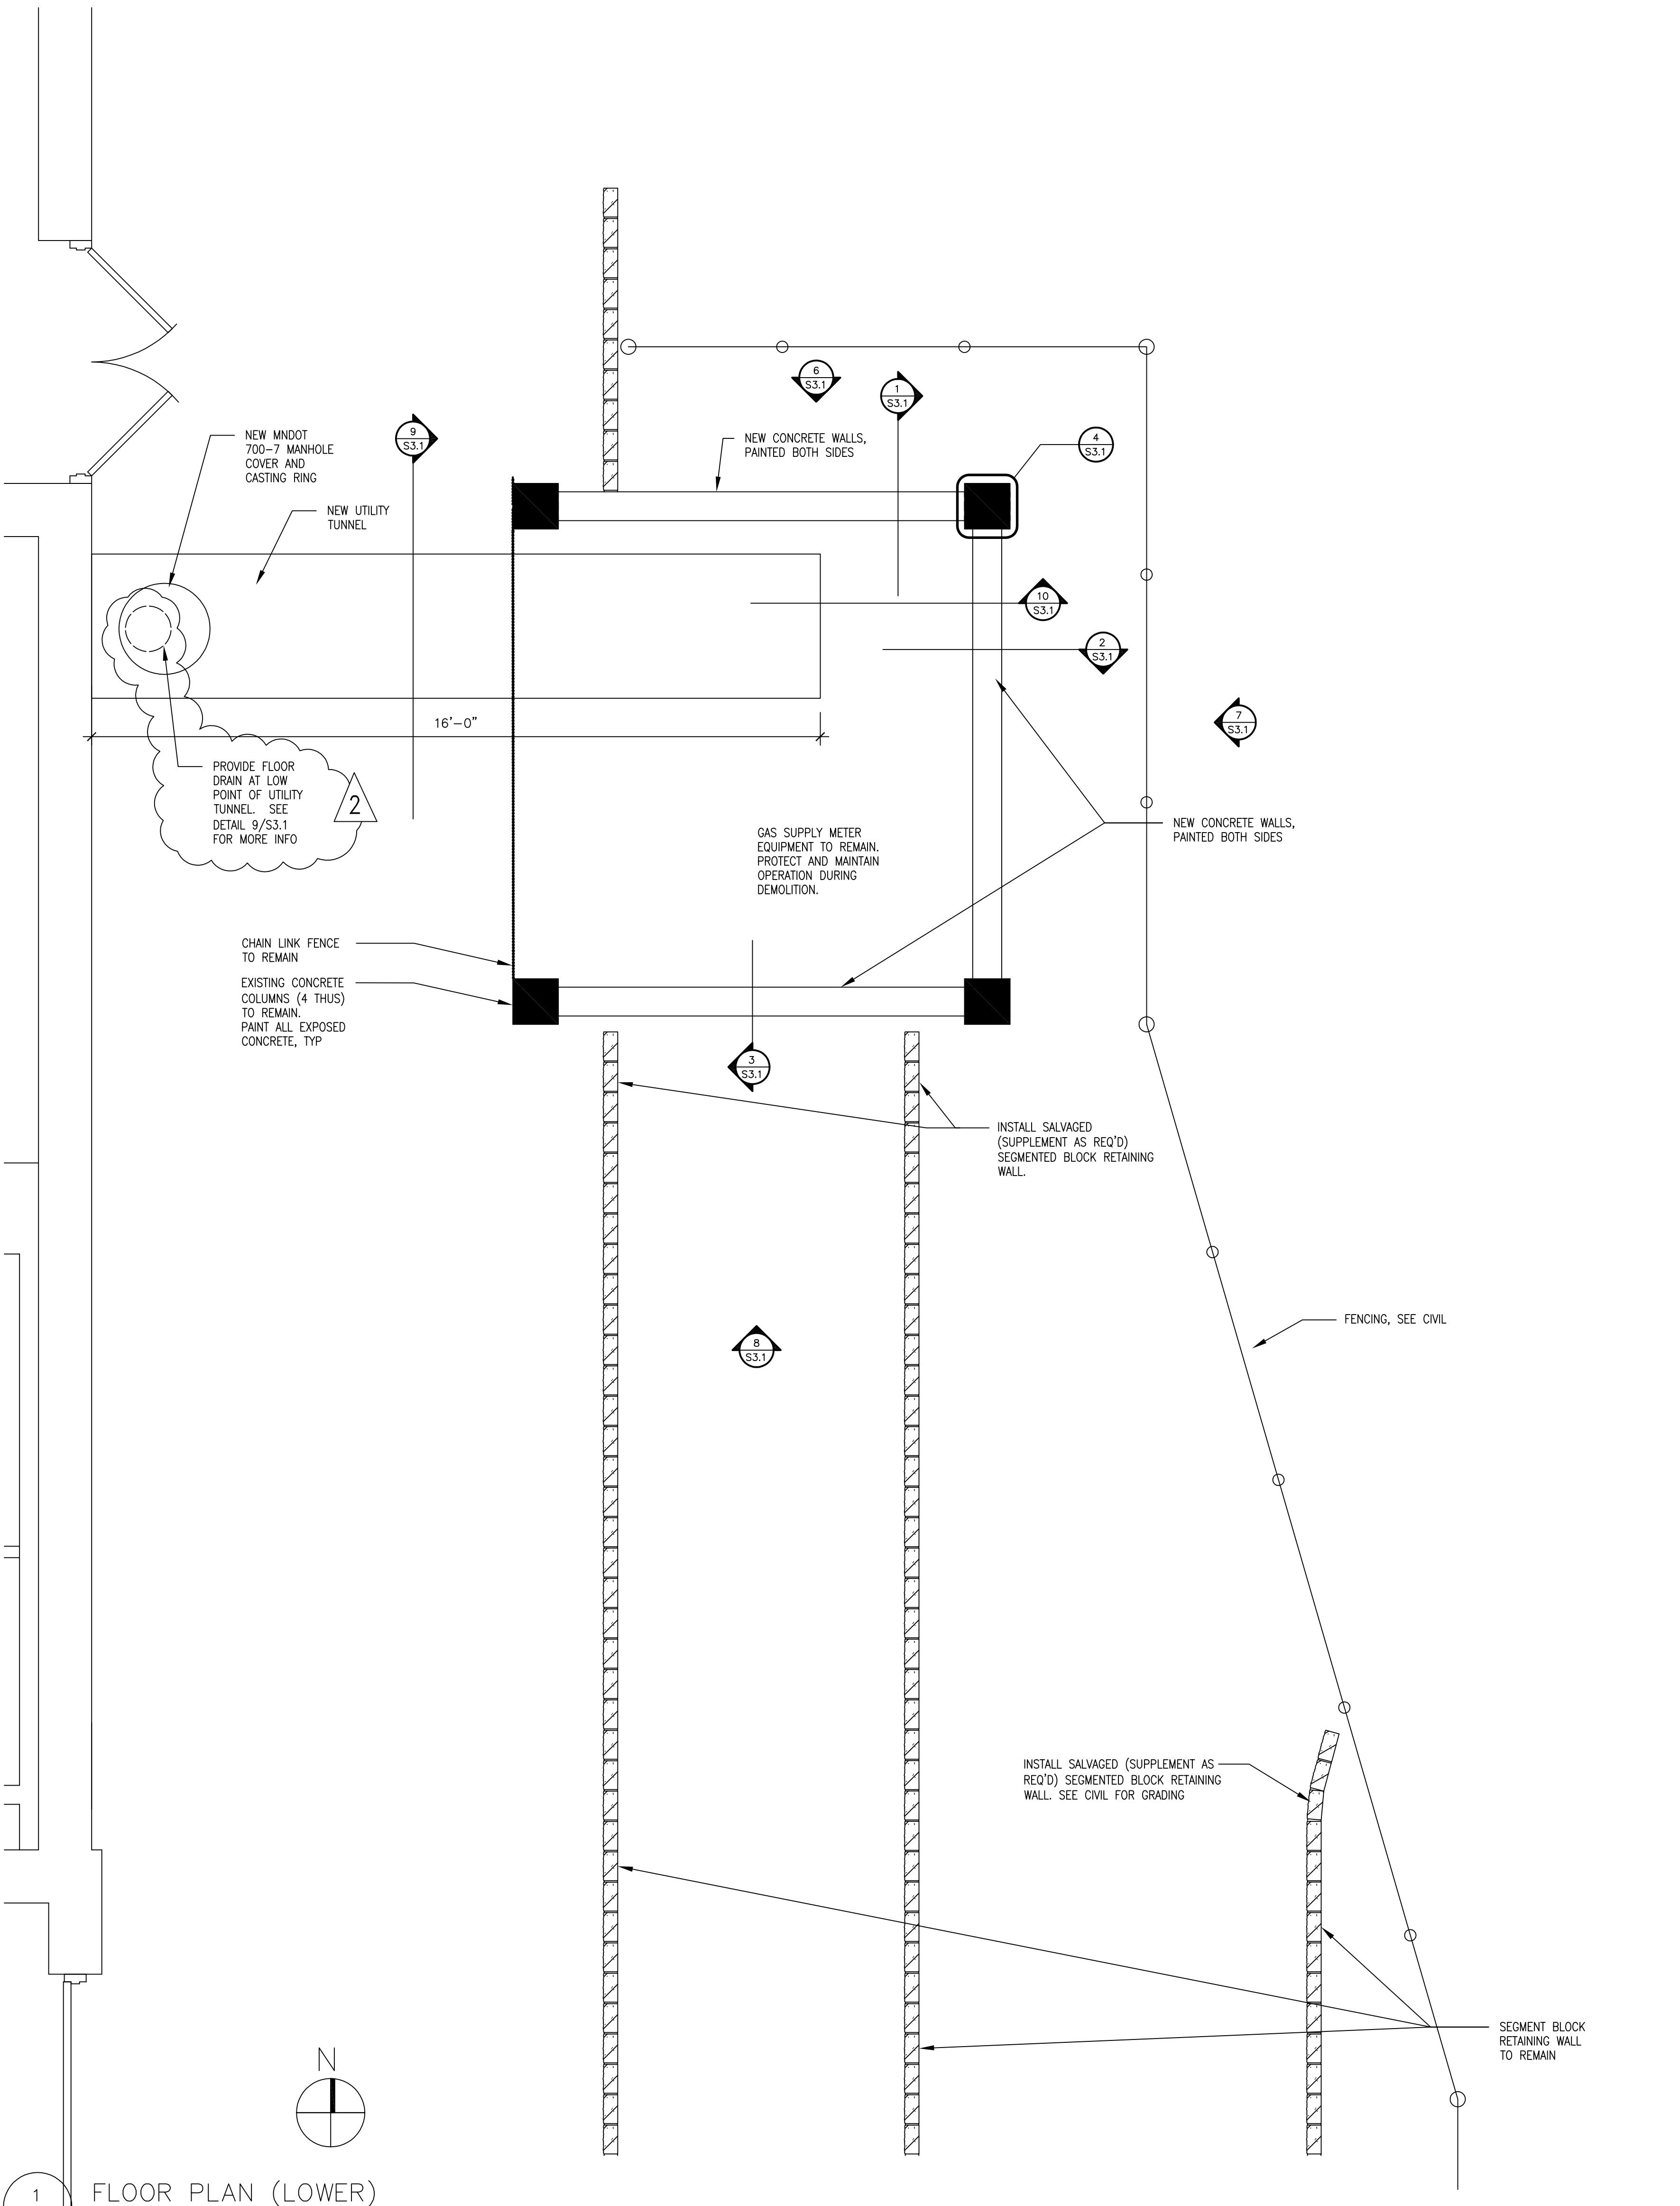


Alexandria
525 Broadway Street
Alexandria, MN 56308
phone 320.759.9030
facsimile 320.759.9062
www.jlgarchitects.com
copyright © 2013

STAMP/SEAL:
I HEREBY CERTIFY THAT THIS PLAN,
SPECIFICATION OR REPORT WAS PREPARED
BY ME OR UNDER MY CLOSE PERSONAL
SUPERVISION AND THAT I AM A QUALIFIED ARCHITECT
UNDER THE LAWS OF THE STATE OF
MINNESOTA.
DANIEL J. MILLER, AIA
DATE: 02.22.2013
REG. NO. 43013

DRAWING TITLE
FRAMING PLANS

PROJECT TITLE
DEMOLISH TRESTLE
AT BOILER PLANT

DATE
02.22.2013
PROJECT NO.
696-19-229
DRAWING NO.
S3.0
15 OF 17

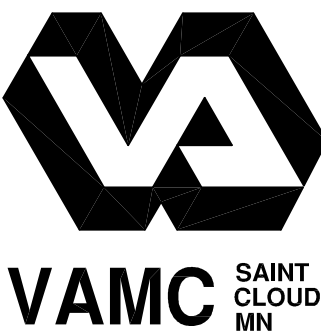

100% CONSTRUCTION DOCUMENTS - FOR CONSTRUCTION