



2/11/13
SHEET 5 OF 5

DOOR SCHEDULE

Mark	Width	Height	Thickness	Door Size	Door Type	Door Material	Frame Type	Frame Material	Hardware	Leafs	Modification /Glass Types	Fire Rating Sched
G-10-1	4'-0"	8'-0"		GG	46	AL	20	AL	01	1	T	
G-17-1	7'-0"	7'-0"	1 3/4"	U,U	3	WD	6	HM	21	2	T	
G-17-2	3'-8"	7'-0"	1 3/4"	V	3	WD	2	HM	22	1	T	
G-17-3	3'-0"	7'-0"	1 3/4"	S	1	WD	2	HM	23	1	T	
G-18-1	3'-4"	7'-0"	1 3/4"	T	1	WD	2	HM	22	1	T	
G-18-2	3'-4"	7'-0"	1 3/4"	T	1	WD	2	HM	22	1	T	
G-19-1	7'-0"	7'-0"	1 3/4"	U,U	3	WD	6	HM	21	2	T	
G-19-2	3'-8"	7'-0"	1 3/4"	V	3	WD	2	HM	22	1	T	
G-20-1	3'-0"	7'-0"	1 3/4"	S	3	WD	2	HM	23	1	T	
G-21-1	2'-6"	7'-0"	1 3/4"	Q	2	HM	2	HM	18	1		
G-22-1	2'-6"	7'-0"	1 3/4"	Q	2	HM	2	HM	16	1		
G-23-1	3'-8"	7'-0"	1 3/4"	V	3	WD	2	HM	22	1	T	
G-23-2	3'-8"	7'-0"	1 3/4"	V	3	WD	2	HM	22	1	T	
G-24-1	2'-6"	7'-0"	1 3/4"	Q	2	HM	2	HM	18	1		
G-25-1	3'-0"	7'-0"	1 3/4"	S	1	WD	2	HM	23	1	T	
G-25-2	3'-0"	7'-0"	1 3/4"	S	3	WD	2	HM	23	1	T	
G-26-1	7'-0"	7'-0"	1 3/4"	U,U	15	WD	6	HM	21A	2	V	
G-26-2	3'-8"	7'-0"	1 3/4"	V	15	WD	2	HM	22A	1	V	
G-26-3	3'-0"	7'-0"	1 3/4"	S	15	WD	2	HM	23a	1	V	
G-27-1	6'-0"	7'-0"	1 3/4"	S,S	15	WD	6	HM	21A	2	V	
G-27-2	3'-8"	7'-0"	1 3/4"	V	15	WD	2	HM	22A	1	V	
G-27-3	3'-0"	7'-0"	1 3/4"	S	15	WD	2	HM	23A	1	V	
G-33-1	7'-8"	7'-0"	1 3/4"	W,W	3	WD	12	HM	07	2	T	
G-34-1	5'-8"	7'-0"	1 3/4"	V,N	3	WD	16	AL	25	2	T	
G-34-2	3'-0"	7'-0"	1 3/4"	S	3	WD	18	AL	23	1	T	
G-35-1	3'-0"	7'-0"	1 3/4"	S	3	WD	18	AL	22	1	T	
G-39-1	3'-4"	7'-0"	1 3/4"	T	2	HM	2	HM	16	1		
G-41-1	3'-0"	7'-0"	1 3/4"	X	3	WD	4	HM	05	1		
G-41-2	4'-0"	7'-10"	1 3/4"	CC	2	HM	2	HM	04	1		
G-42-1	3'-0"	7'-0"	1 3/4"	S	1	WD	8	HM	12A	1		
G-45-1	3'-4"	7'-0"	1 3/4"	T	11	WD	2	HM	16	1		45 MINS
G-46-1	3'-0"	7'-0"	1 3/4"	S	2	HM	2	HM	12	1		
G-47-1	5'-8"	7'-0"	1 3/4"	V,N	11	WD	22	AL	11B	2	F	
G-47-2	3'-0"	7'-0"	1 3/4"	DD	44	AL	14	AL	27	3	T	
G-48-1	3'-4"	7'-0"	1 3/4"	T	11	WD	2	HM	17	1		45 MINS
G-49-1	3'-4"	7'-0"	1 3/4"	T	11	WD	2	HM	17	1		45 MINS
G-50-1	7'-8"	7'-0"	1 3/4"	W,W	3	WD	12	HM	26	2	T	
G-50-2	7'-8"	7'-0"	1 3/4"	W,W	11	WD	12	HM	7	2	W	
G-51-1	3'-0"	7'-0"	1 3/4"	S	3	WD	2	HM	24	1	T	
G-51-2	3'-0"	7'-0"	1 3/4"	S	1	WD	2	HM	24	1		
G-53-1	3'-0"	7'-0"	1 3/4"	S	2	HM	2	HM	12	1		

DOOR TYPES

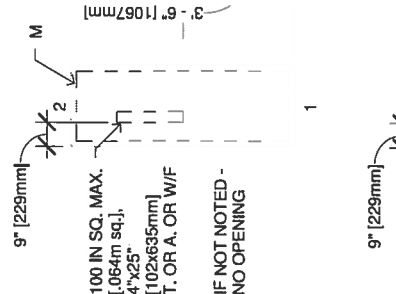


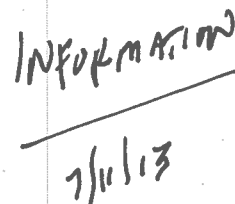


SLIDING DOOR

DOOR SCHEDULE							
Door Type	Door Material	Frame Type	Frame Material	Hardware	Leaves	Modification /Glass Types	Fire Rating Sched
WD	2	HM	09	1	W		90 MINS
WD	6	HM	08	2	W		90 MINS
HM	2	HM	19	1			


DOOR SCHEDULE							
Door Type	Door Material	Frame Type	Frame Material	Hardware	Leaves	Modification /Glass Types	Fire Rating Sched
WD	2	HM	09	1	W		90 MINS
WD	6	HM	08	2	W		90 MINS

DOOR SCHEDULE							
Door Type	Door Material	Frame Type	Frame Material	Hardware	Leaves	Modification /Glass Types	Fire Rating Sched
WD	2	HM	09	1	W		90 MINS
WD	6	HM	08	2	W		90 MINS

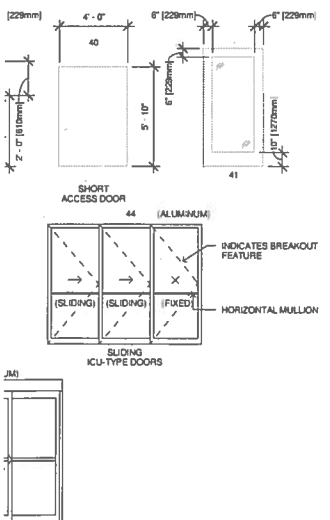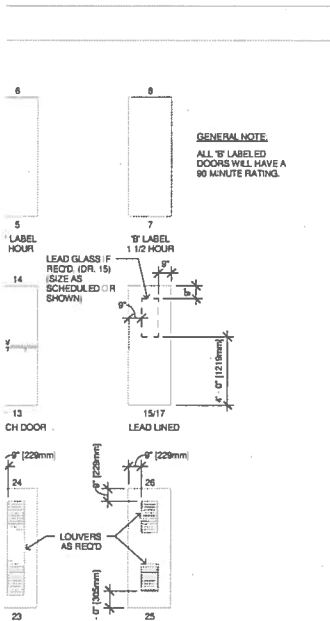

FRAME TYPES (SEE DOOR LEGEND)

GENERAL NOTE:
SEE FRAME DETAILS FOR SPECIFIC CONDITIONS

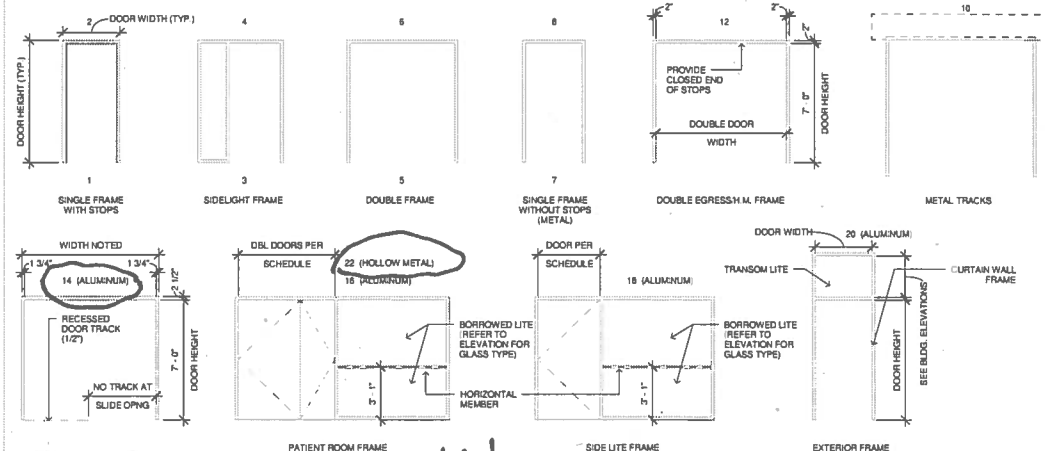

DOOR SIZES

MK	WIDTH		HEIGHT		MK	WIDTH		HEIGHT	
	IN	[mm]	IN	[mm]		IN	[mm]	IN	[mm]
A	1'-6"	[457]	6'-8"	[2032]	Q	2'-6"	[762]	7'-0"	[2134]
B	2'-0"	[610]	6'-8"	[2032]	R	2'-8"	[813]	7'-0"	[2134]
C	2'-2"	[660]	6'-8"	[2032]	S	3'-0"	[914]	7'-0"	[2134]
D	2'-4"	[711]	6'-8"	[2032]	T	3'-4"	[1016]	7'-0"	[2134]
E	2'-6"	[762]	6'-8"	[2032]	U	3'-6"	[1067]	7'-0"	[2134]
F	2'-8"	[813]	6'-8"	[2032]	V	3'-8"	[1118]	7'-0"	[2134]
G	2'-10"	[864]	6'-8"	[2032]	W	3'-10"	[1168]	7'-0"	[2134]
H	3'-0"	[914]	6'-8"	[2032]	X	4'-0"	[1219]	7'-0"	[2134]
I	3'-2"	[965]	6'-8"	[2032]	Y	3'-0"	[914]	8'-0"	[2438]
J	3'-4"	[1016]	6'-8"	[2032]	Z	3'-8"	[1219]	5'-10"	[1778]
K	3'-8"	[1118]	6'-8"	[2032]	AA	8'-0"	[2438]	10'-0"	[3048]
L	3'-10"	[1168]	6'-8"	[2032]	BB	7'-0"	[2134]	7'-0"	[2134]
M	1'-6"	[457]	7'-8"	[2337]	CC	4'-0"	[1219]	7'-10"	[2388]
N	2'-0"	[610]	7'-0"	[2134]	DD	9'-0"	[2742]	7'-0"	[2134]
O	2'-2"	[660]	7'-0"	[2134]	EE	1'-6"	[457]	7'-0"	[2134]
P	2'-4"	[711]	7'-0"	[2134]	FF	3'-0"	[1828]	5'-4"	[1628]
					GG	4'-0"	[1219]	8'-0"	[2438]

DOOR MODIFICATIONS

A LAMINATED GLASS
D DOUBLE GLAZED
TEMPERED GLASS
H ELECTRIC HOLD
L LOUVER
LP LIGHT PROOF LOUVER
M MECH. SEAL FOR LIGHT
PROOF & SOUND
RETARDING DOOR
T TEMPERED GLASS
T1 TEMPERED GLASS, ONE
LEAF ONLY
T2 TEMPERED GLASS,
BOTH LEAVES
U UNDERCUT 1" [25mm]
V LEAD GLASS
W FIRE RATED GLAZING
F WIRE GLASS

DOOR SYMBOL

FRAME TYPE (JAMB DETAIL)
DOOR SIZE
DOOR HARDWARE
DOOR MODIFICATION
DOOR NUMBER
DOOR TYPE
DOUBLE LETTERS
EQUAL SIZE OF
LEAF FOR PAIR
OF DOORS

LEGEND (SEE ELEVATIONS)

GLASS OR LOUVER
REQUIRED BY
MODIFICATION
GLASS OR LOUVER
REQUIRED BY
ELEVATION TYPE

EVEN NUMBERS (2,4,6) = METAL (STEEL (H.M.), U.N.O.)
ODD NUMBERS (1,3,5) = WOOD

NOTES

- ALL DOORS SHALL BE FLUSH - 1 3/4" [44mm] THICK UNLESS NOTED OTHERWISE.
- TOP & SIDE RAILS SHALL BE 9" [229mm] MIN. BOTTOM RAILS SHALL BE 12" MIN. [305mm].
- DOOR TYPES 7, 8, 9 & 10 SHALL NOT BE USED FOR OPPOSING DOORS.
- REFER TO SPECIFICATION SECTION 08 71 00 FOR DOOR HARDWARE.
- DOORS AT ISOLATION ROOMS G34-5 TO HAVE A MINIMUM OF 3/4" UNDERCUT, 1/8" JAMBS AND 1/2" BETWEEN DOUBLE DOORS FOR AIR QUALITY.

ENGINEERS/COST ESTIMATORS:

BECKET

2380 McGee Street,
Suite 200
Kansas City, MO 64108
816 561 4443

Ellerbe Becket, Inc.
Ellerbe Becket Architects
and Engineers, Inc.
Ellerbe Becket Architects
and Engineers

2009

Drawing Title:
DOOR SCHEDULE, DOOR SIZES, DOOR & FRAME TYPES

Approved: Project Director

Project Title:
CONSTRUCT SURGICAL SUITE

Location
SIOUX FALLS, SD

Date
05/14/2010

Checked
J. FRUSH

Drawn
DAH

FULLY SPRINKLERED

Project Number
438-363ES

Building Number
5

Drawing Number
5-AS905

Dwg. 113 of 194



Information
7/11/13

