




7/30/2013 11:55:18 AM C:\x\it Local\15101\_VA Dayton\_Local\_090.rvt  

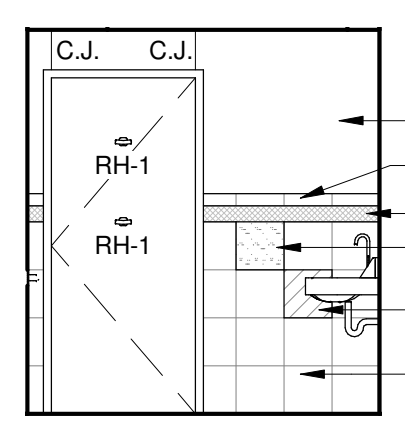


1 STAFF TOILET  
SCALE: 1/4" = 1'-0"

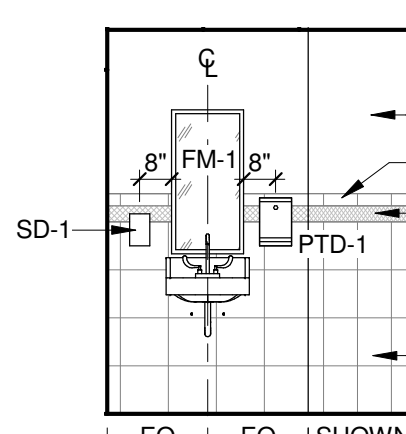


2 STAFF TOILET  
SCALE: 1/4" = 1'-0"

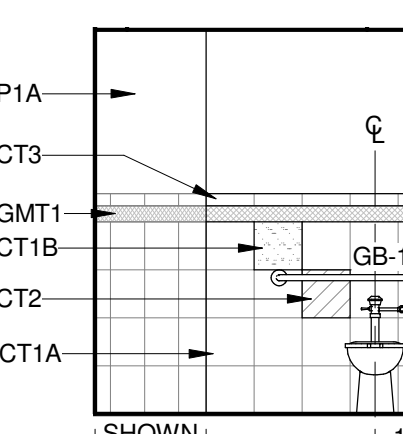


3 STAFF TOILET  
SCALE: 1/4" = 1'-0"

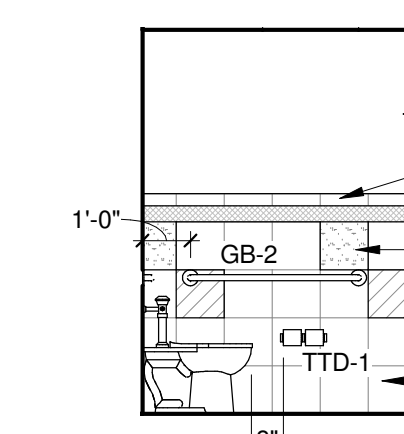


4 STAFF TOILET  
SCALE: 1/4" = 1'-0"

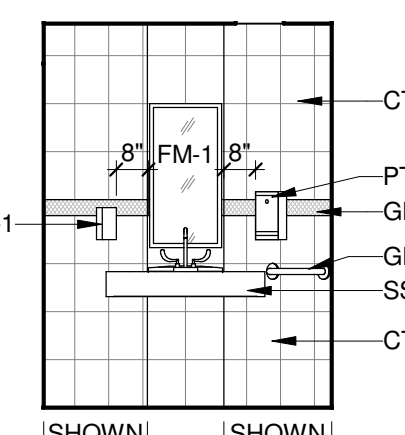


9 PATIENT ROOM  
SCALE: 1/4" = 1'-0"

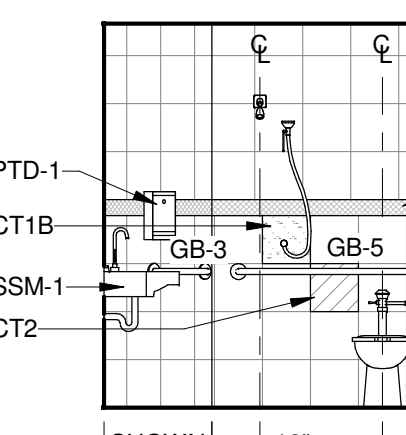


10 PATIENT ROOM  
SCALE: 1/4" = 1'-0"

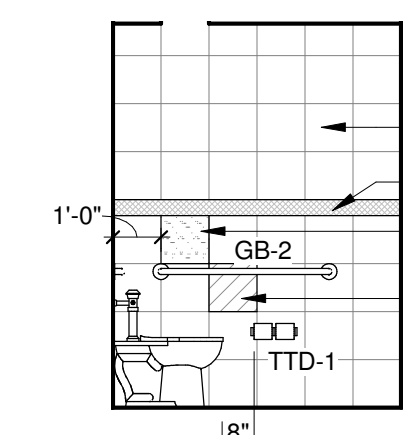


11 PATIENT ROOM  
SCALE: 1/4" = 1'-0"

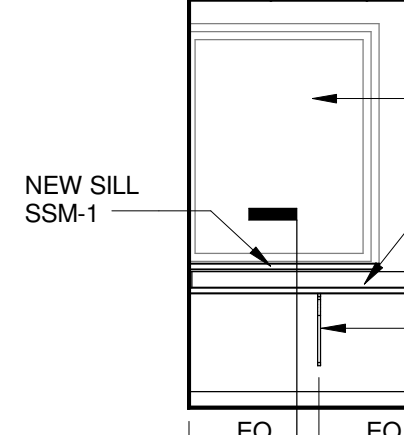


12 CHARTING  
SCALE: 1/4" = 1'-0"

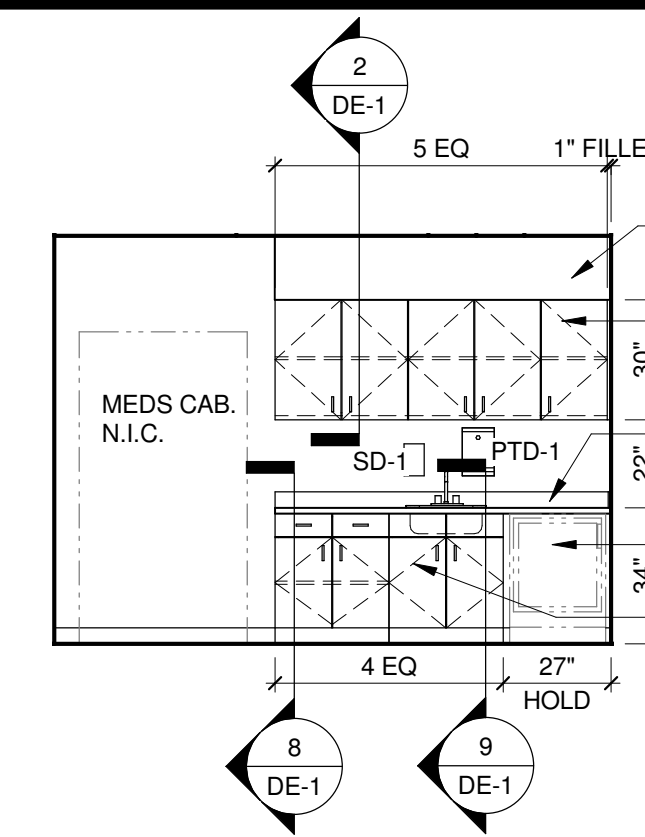


5 MEDS  
SCALE: 1/4" = 1'-0"

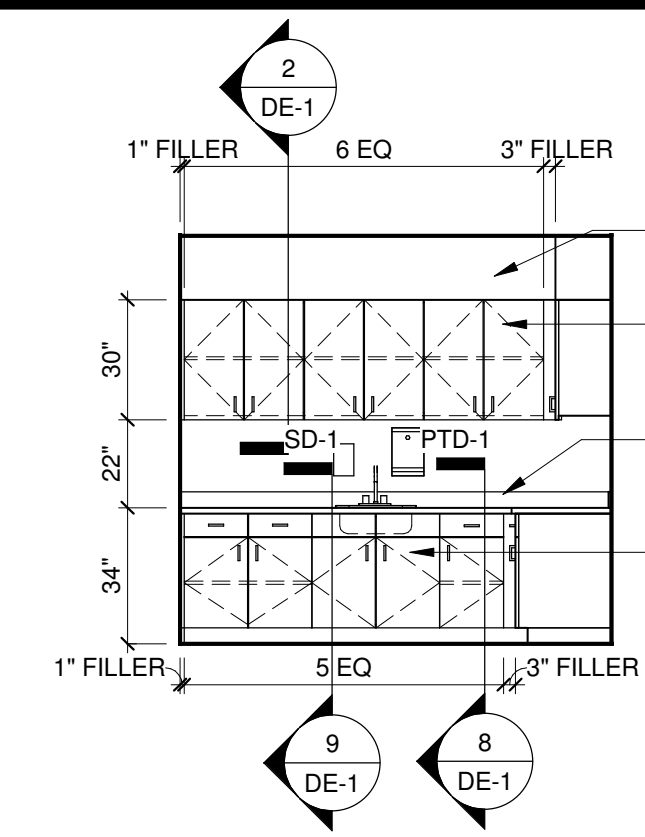


6 NOURISHMENT  
SCALE: 1/4" = 1'-0"

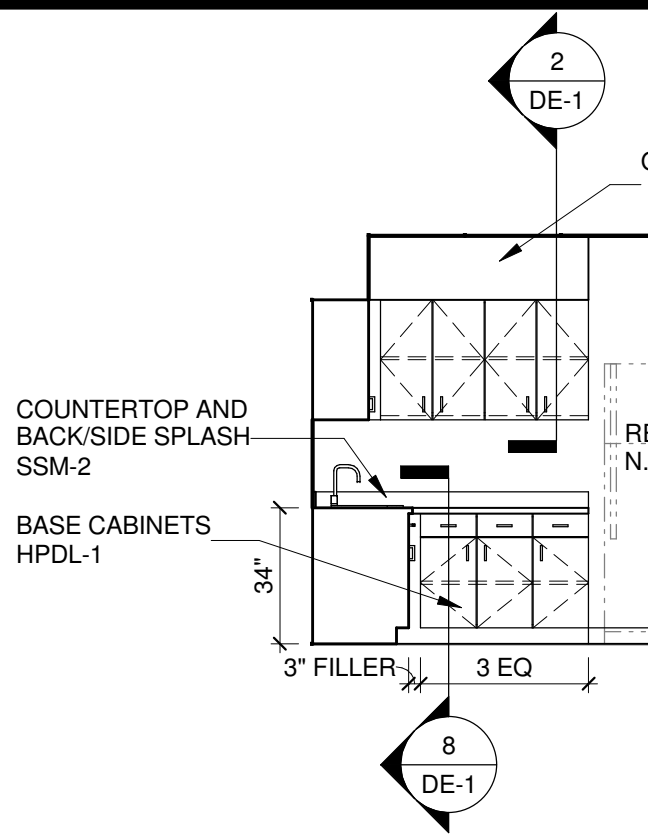


7 NOURISHMENT  
SCALE: 1/4" = 1'-0"

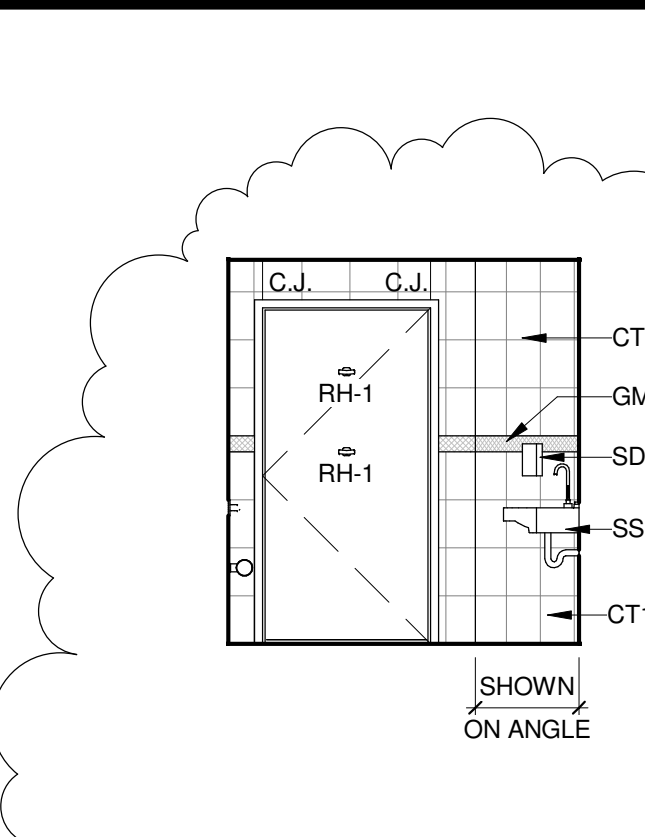


8 PATIENT TOILET  
SCALE: 1/4" = 1'-0"

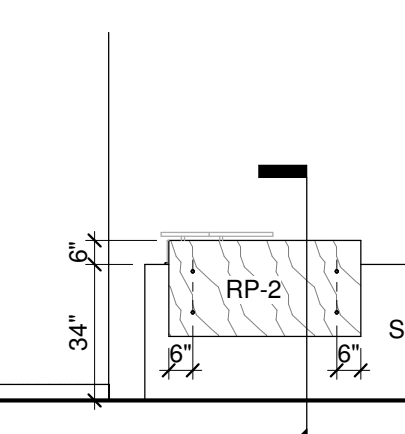


18 NURSE STATION  
SCALE: 1/4" = 1'-0"

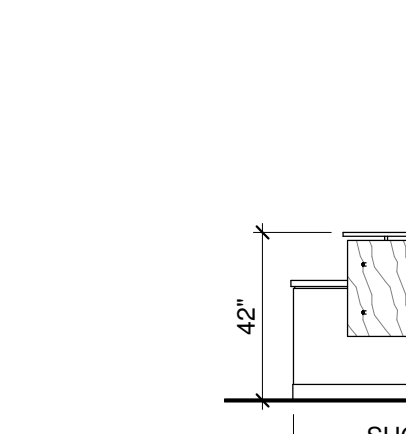


19 NURSE STATION  
SCALE: 1/4" = 1'-0"

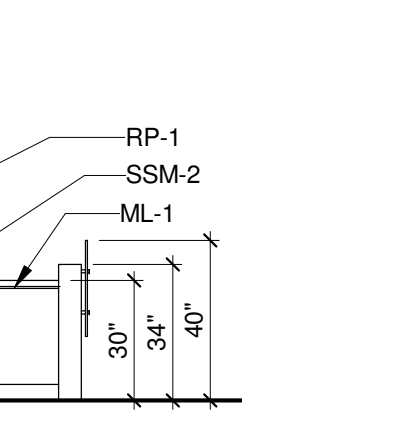


20 NURSE STATION  
SCALE: 1/4" = 1'-0"

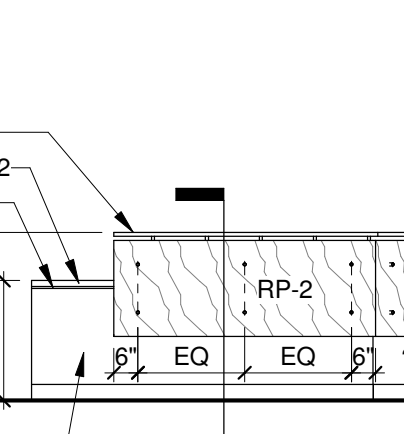


21 NURSE STATION  
SCALE: 1/4" = 1'-0"

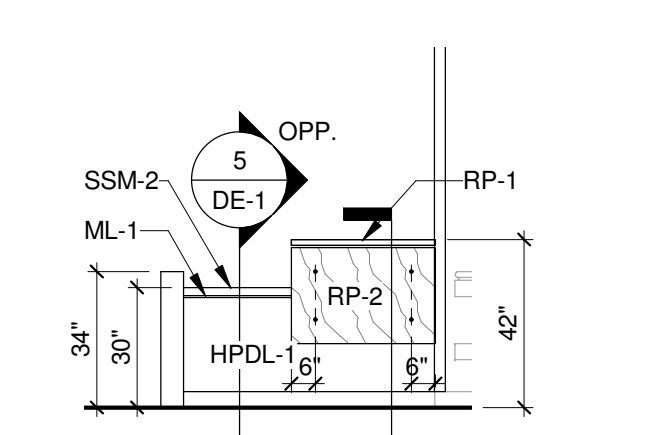


13 CHARTING  
SCALE: 1/4" = 1'-0"

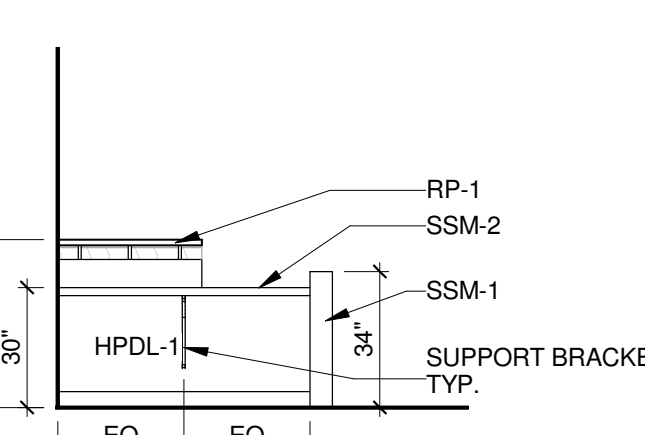


14 CHARTING  
SCALE: 1/4" = 1'-0"

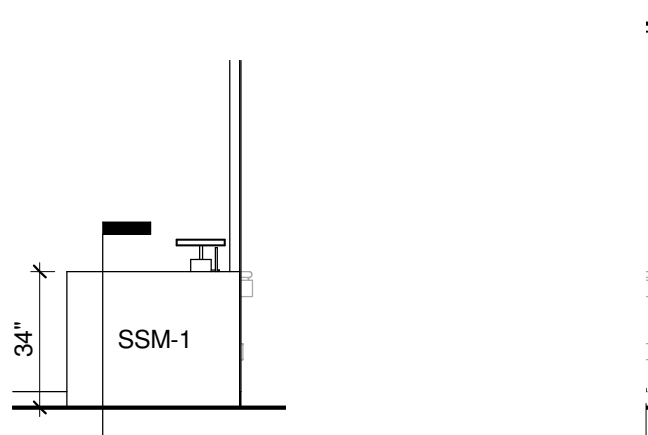


15 CHARTING  
SCALE: 1/4" = 1'-0"

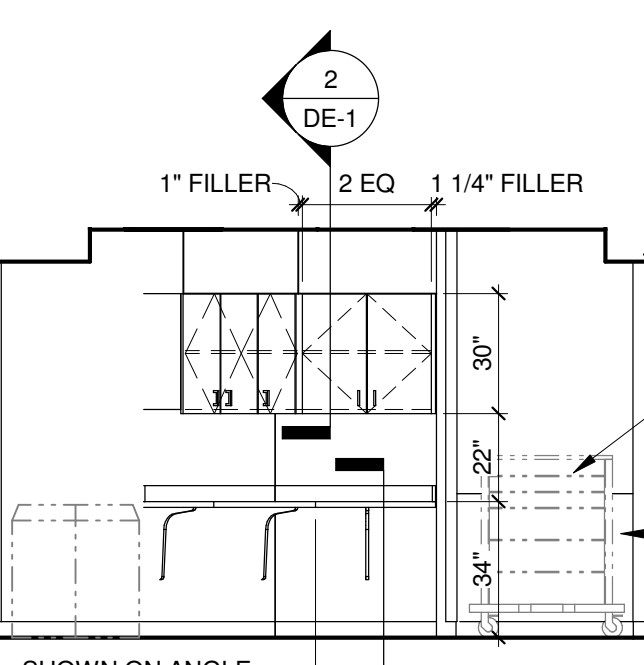


16 NURSE STATION  
SCALE: 1/4" = 1'-0"

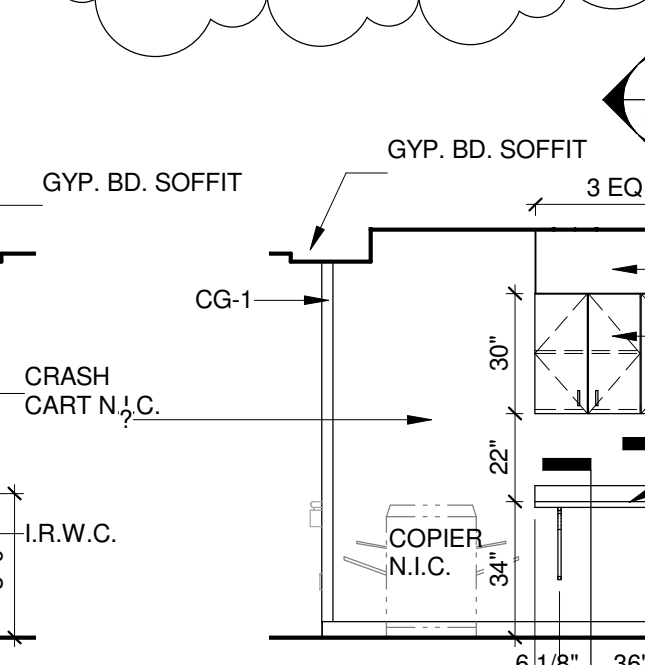


17 NURSE STATION  
SCALE: 1/4" = 1'-0"

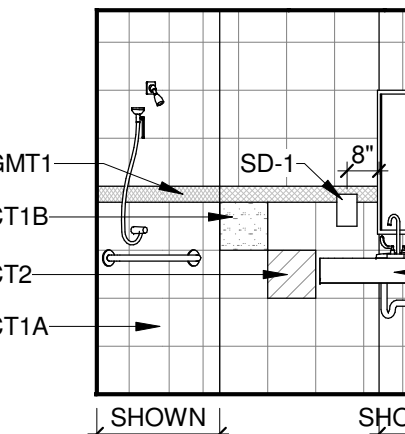


25 PATIENT TOILET  
SCALE: 1/4" = 1'-0"

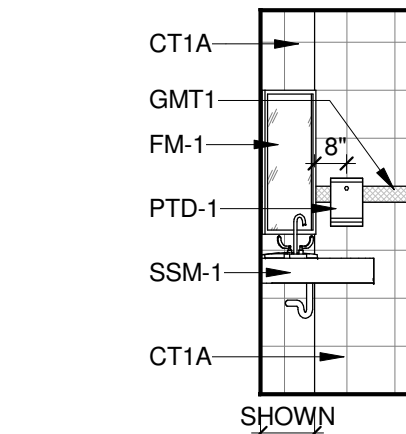


26 PATIENT TOILET  
SCALE: 1/4" = 1'-0"

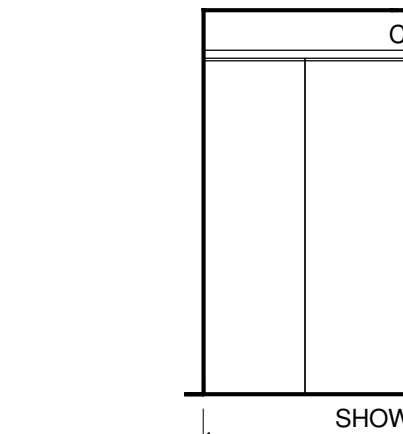


27 CORRIDOR  
SCALE: 1/4" = 1'-0"

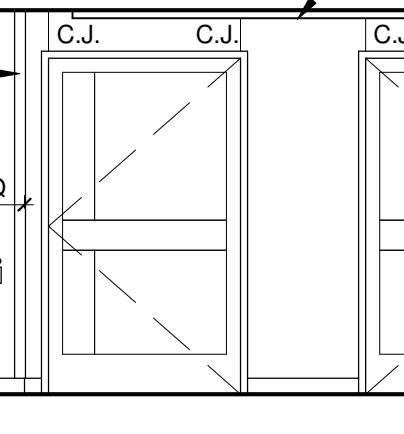


28 CORRIDOR  
SCALE: 1/4" = 1'-0"

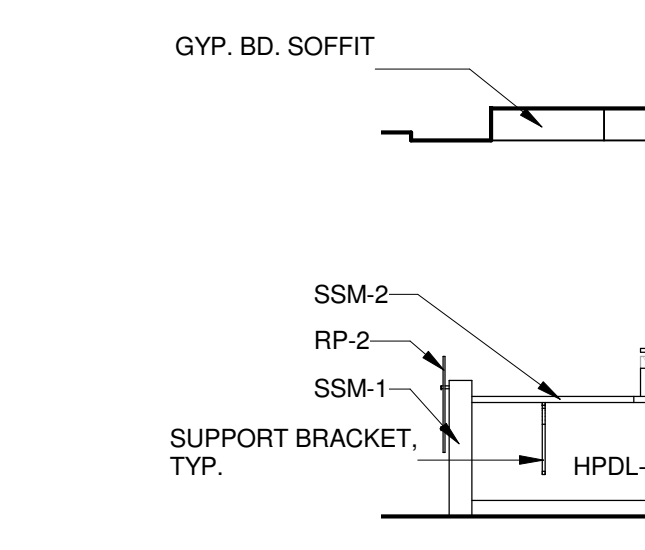


22 NURSE STATION  
SCALE: 1/4" = 1'-0"

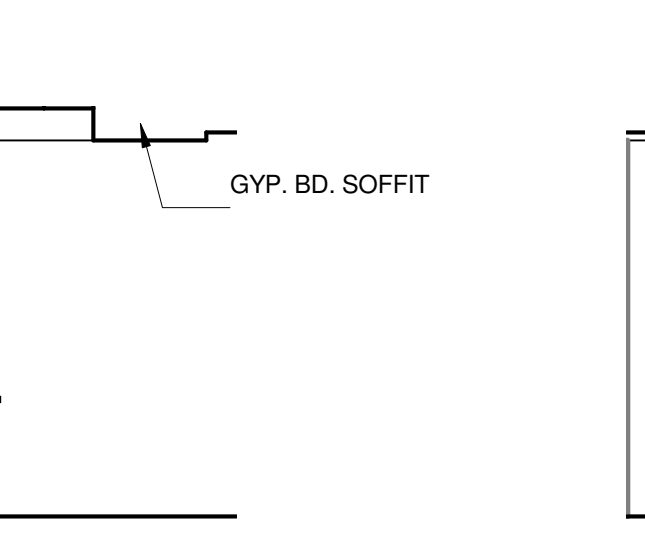


23 NURSE STATION  
SCALE: 1/4" = 1'-0"

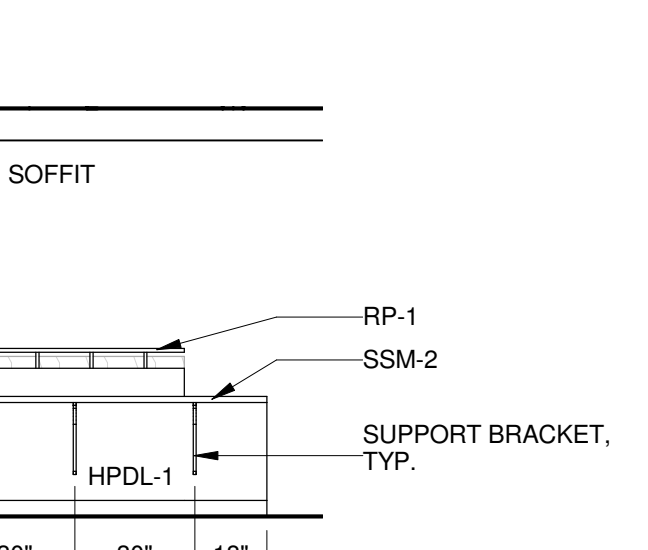


24 PATIENT TOILET  
SCALE: 1/4" = 1'-0"

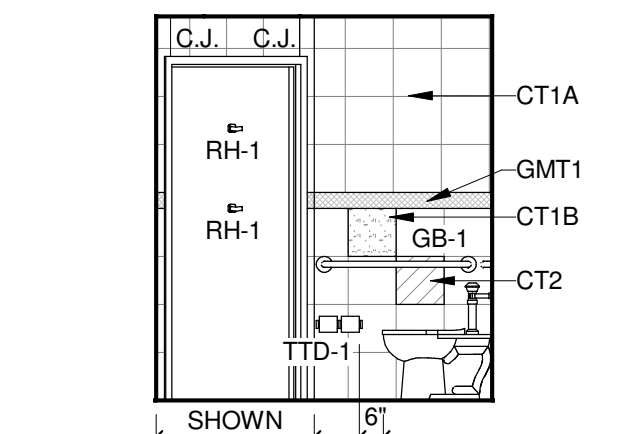


25 PATIENT TOILET  
SCALE: 1/4" = 1'-0"

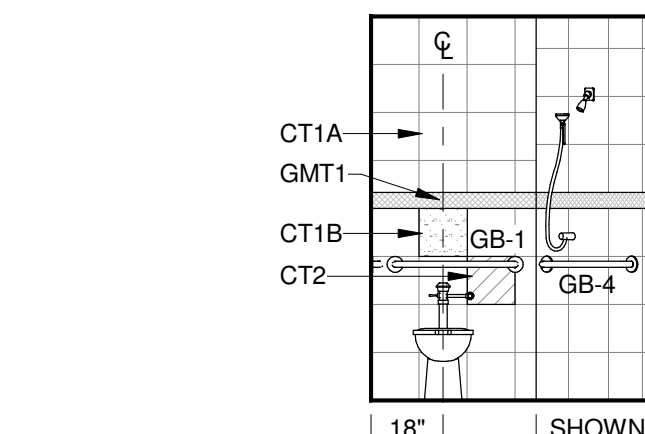


26 PATIENT TOILET  
SCALE: 1/4" = 1'-0"

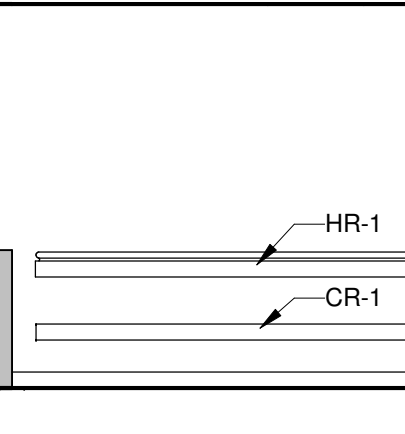


28 CORRIDOR  
SCALE: 1/4" = 1'-0"

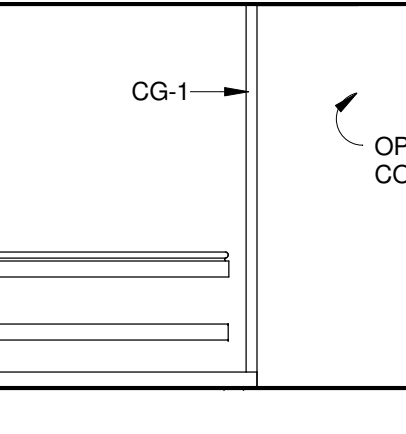


29 CORRIDOR  
SCALE: 1/4" = 1'-0"

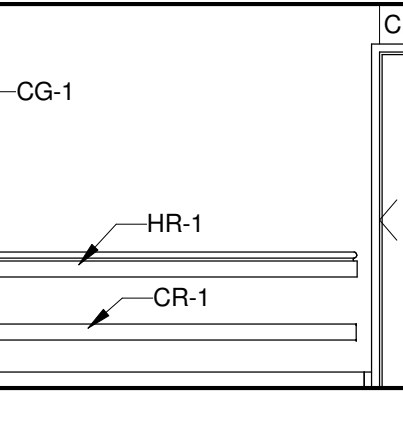


30 CORRIDOR  
SCALE: 1/4" = 1'-0"

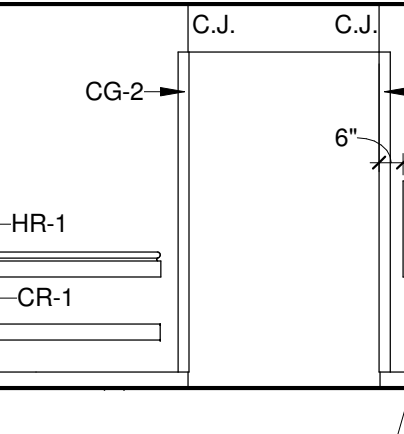

31 CORRIDOR  
SCALE: 1/4" = 1'-0"

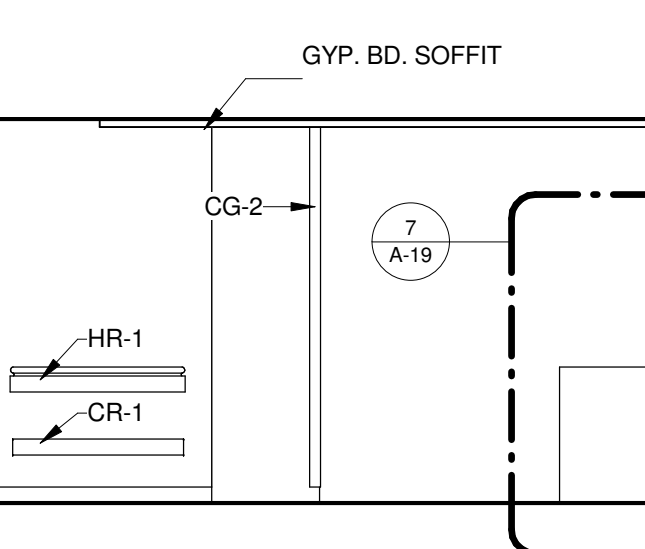

32 CORRIDOR  
SCALE: 1/4" = 1'-0"

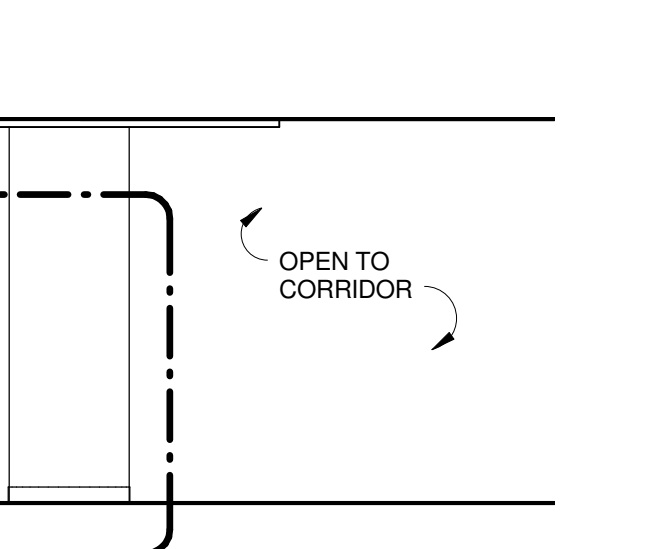


33 CORRIDOR  
SCALE: 1/4" = 1'-0"



34 CORRIDOR  
SCALE: 1/4" = 1'-0"



35 CORRIDOR  
SCALE: 1/4" = 1'-0"

 

36 CORRIDOR  
SCALE: 1/4" = 1'-0"

<b>CONSULTANTS:</b>		<b>ARCHITECTS/ENGINEERS:</b>		ARCHITECTURAL PROJECT # 18101		Drawing Title INTERIOR ELEVATIONS		Project Title RENOVATE PATIENT WARDS FOR PRIVACY, 3RD AND 4TH FLOOR, B-330		Project Number 552-13-202 Building Number B-330		Office of Construction and Facilities Management			
AMENDMENT NO. 1 100% SUBMISSION 75% SUBMISSION Revisions		KEY PLAN		CBLH DESIGN 7850 Freeway Circle 440.243.2000 t		Architecture Planning Interior Design Cleveland, OH 44130 440.243.3305 f		Approved: Project Director		Location 4100 WEST THIRD STREET, DAYTON, OH, 45428		Drawing Number A-18 Dwg. 24 of 87		Department of Veterans Affairs	
07/30/2013 12/14/2012 10/19/2012 Date										Date January 25, 2013		Checked NS/KML/TH		Drawn APOB	