



1 CORRIDOR
SCALE: 1/4" = 1'-0"

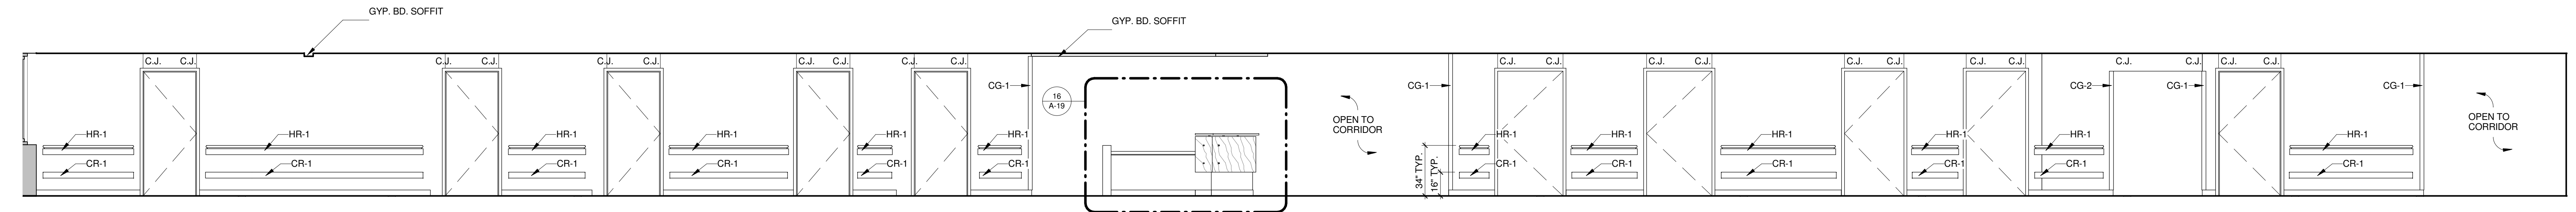

2 CORRIDOR
SCALE: 1/4" = 1'-0"

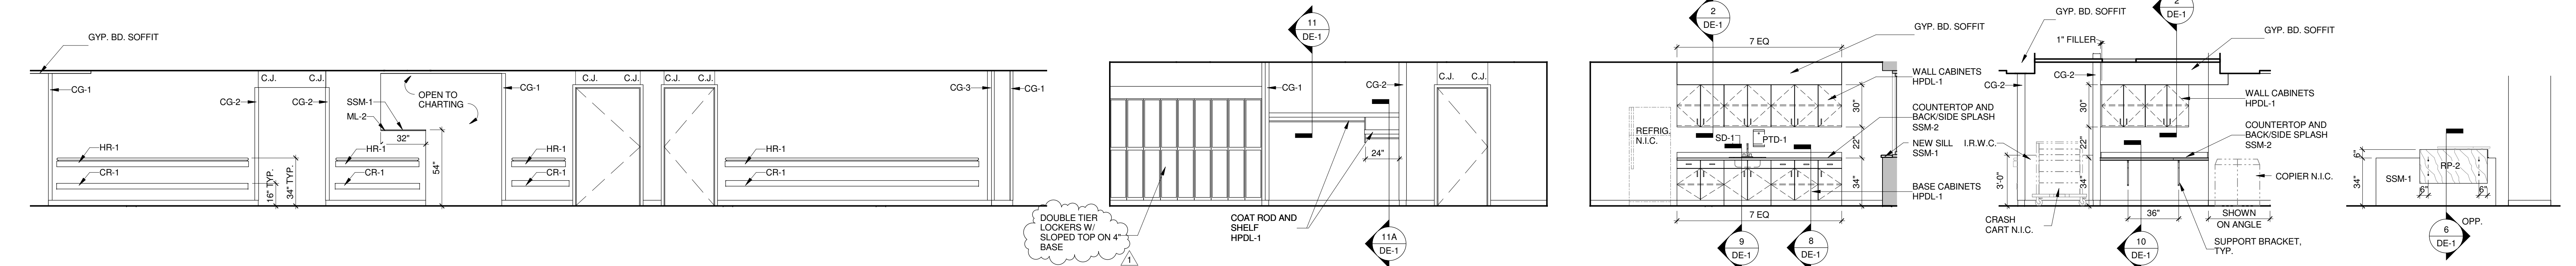


3 CORRIDOR
SCALE: 1/4" = 1'-0"

4 MULTI-PURPOSE
SCALE: 1/4" = 1'-0"


5 MULTI-PURPOSE
SCALE: 1/4" = 1'-0"

6 NURSE STATION
SCALE: 1/4" = 1'-0"


7 NURSE STATION
SCALE: 1/4" = 1'-0"

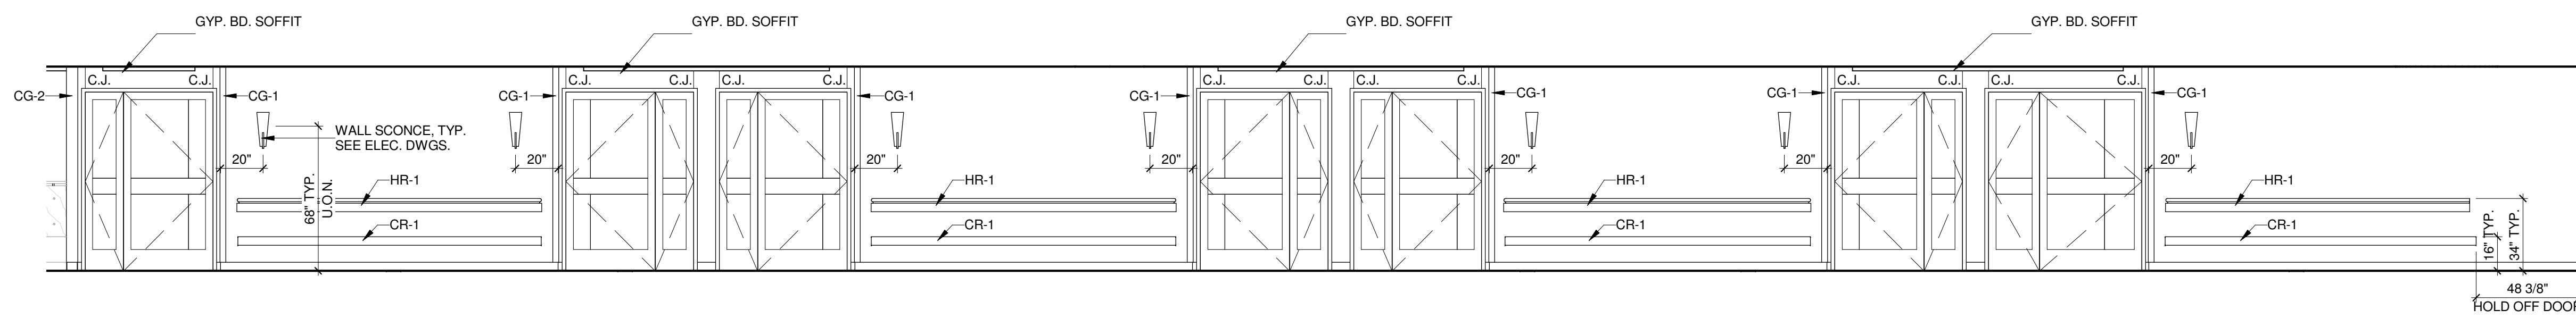


8 CORRIDOR
SCALE: 1/4" = 1'-0"

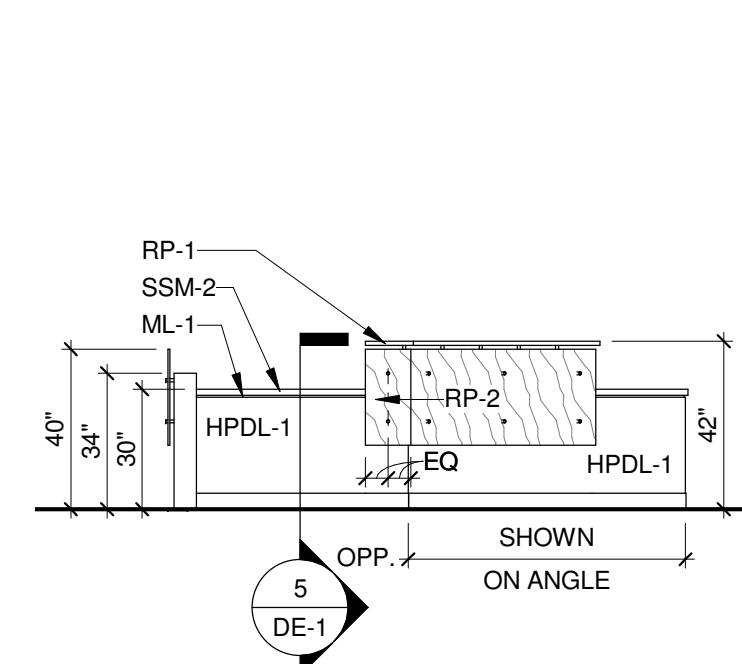


9 NURSE STATION
SCALE: 1/4" = 1'-0"

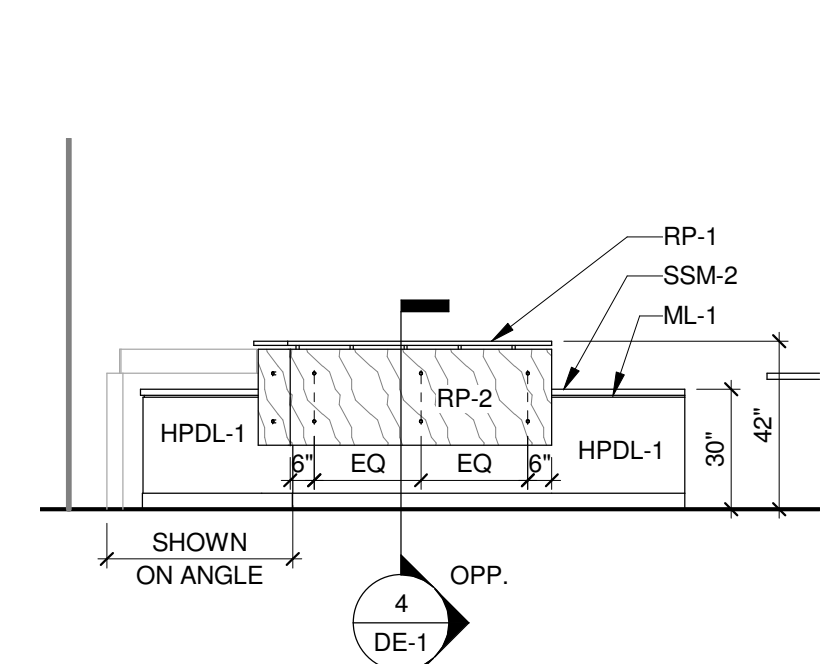


10 NURSE STATION
SCALE: 1/4" = 1'-0"

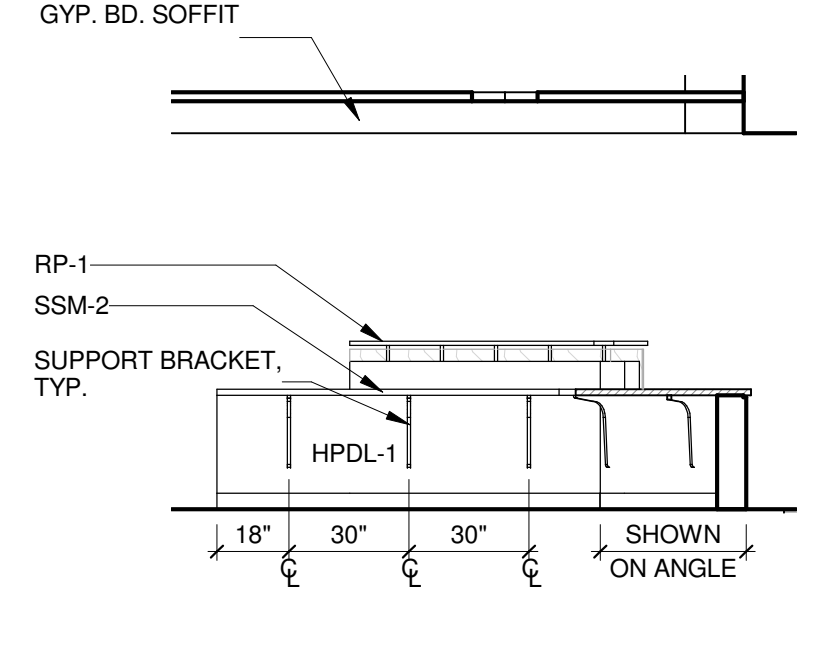


11 NURSE STATION
SCALE: 1/4" = 1'-0"

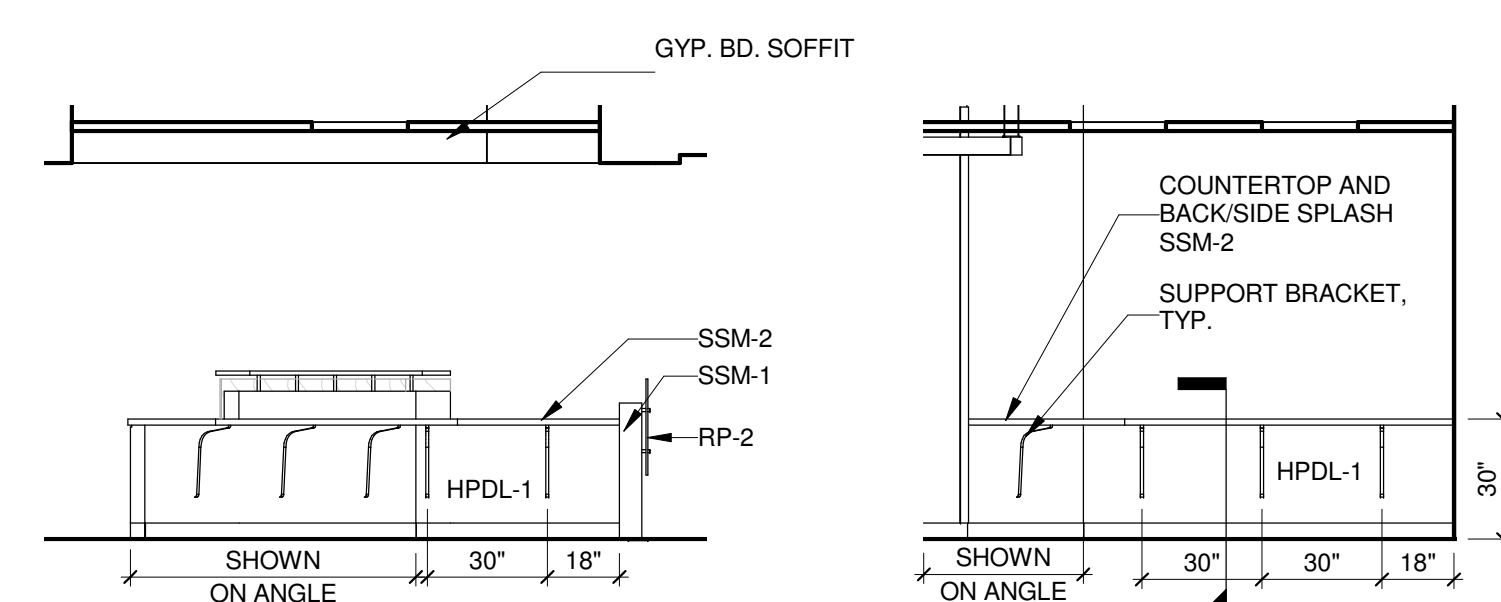


12 NURSE STATION
SCALE: 1/4" = 1'-0"

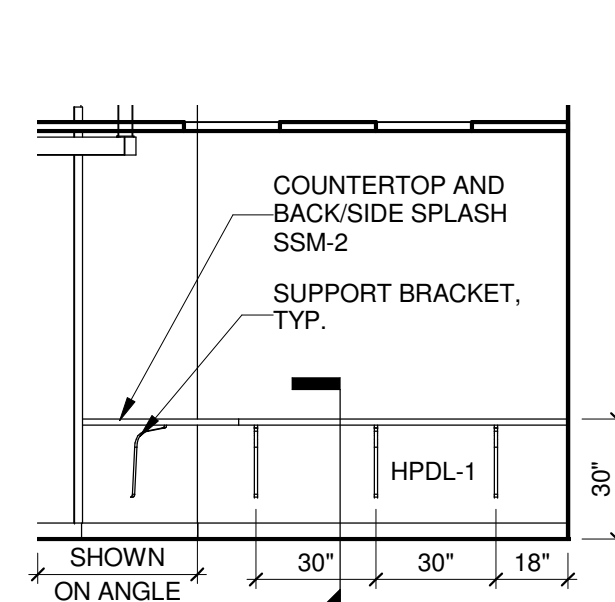


13 CHARTING
SCALE: 1/4" = 1'-0"

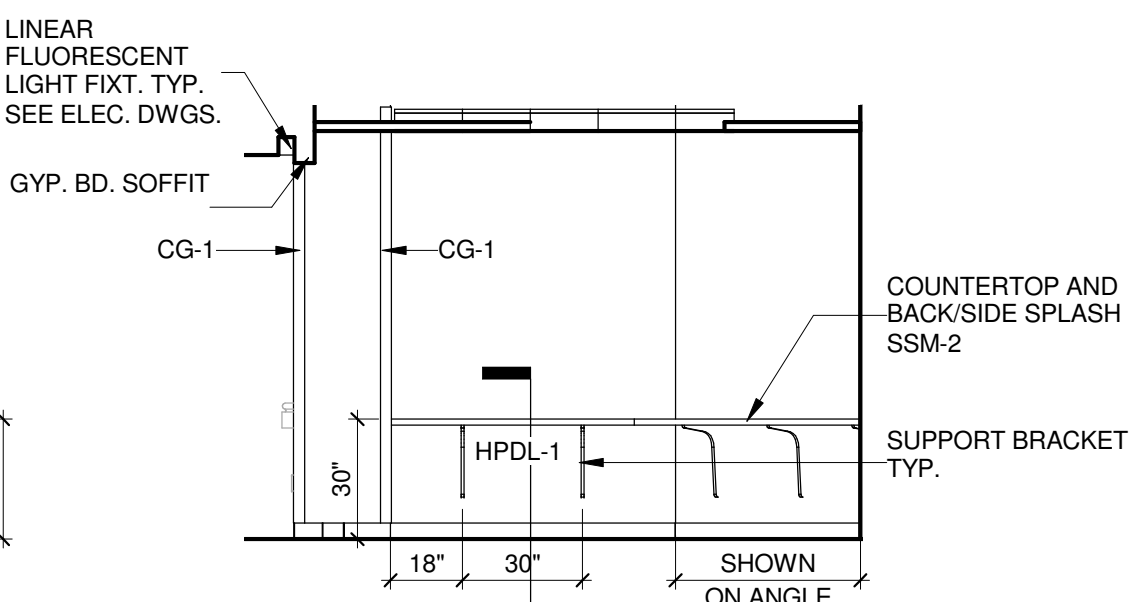


14 CHARTING
SCALE: 1/4" = 1'-0"

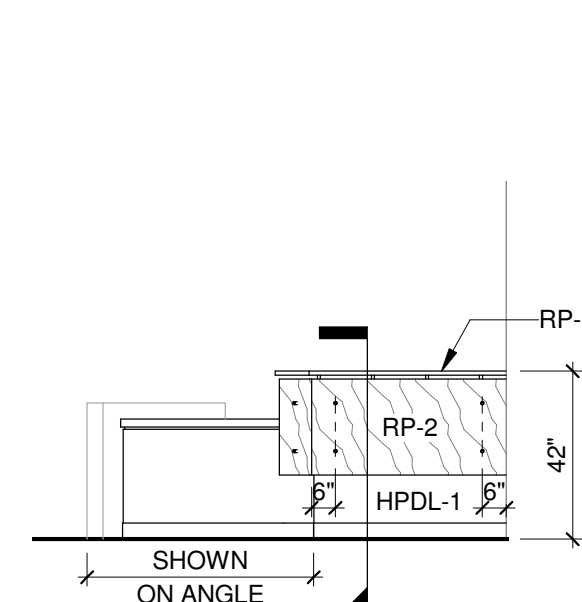


15 CHARTING
SCALE: 1/4" = 1'-0"

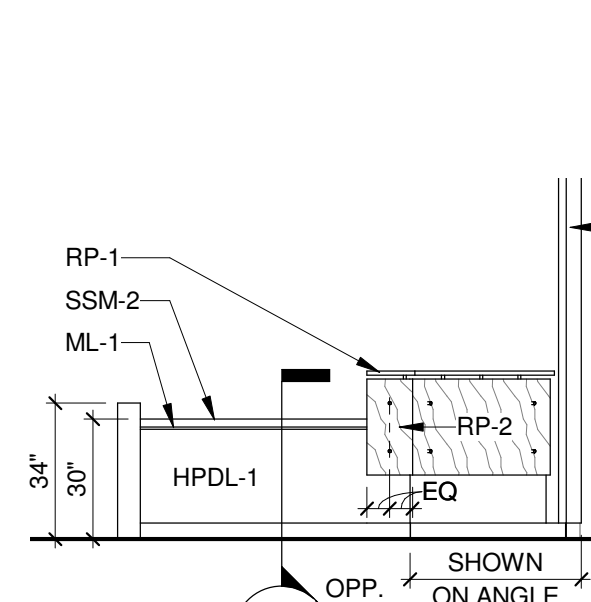


16 CHARTING
SCALE: 1/4" = 1'-0"

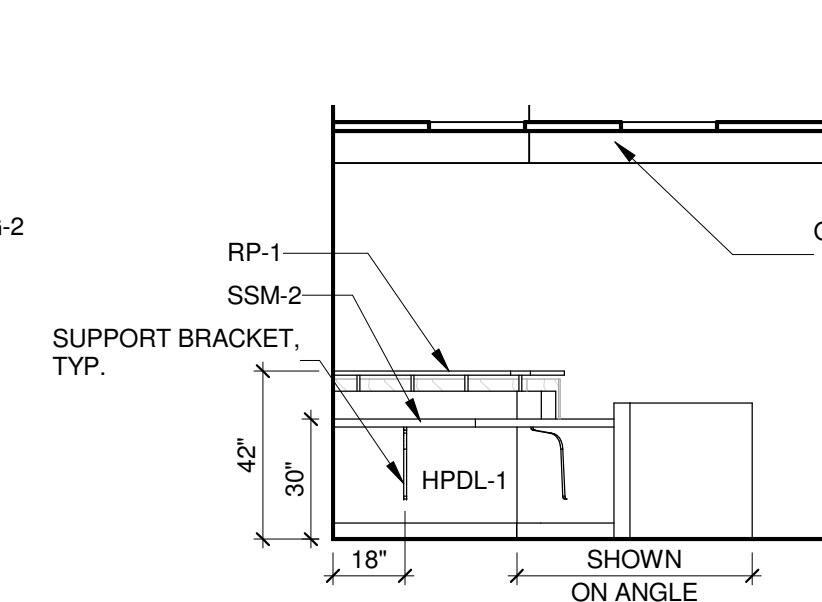

17 CHARTING
SCALE: 1/4" = 1'-0"

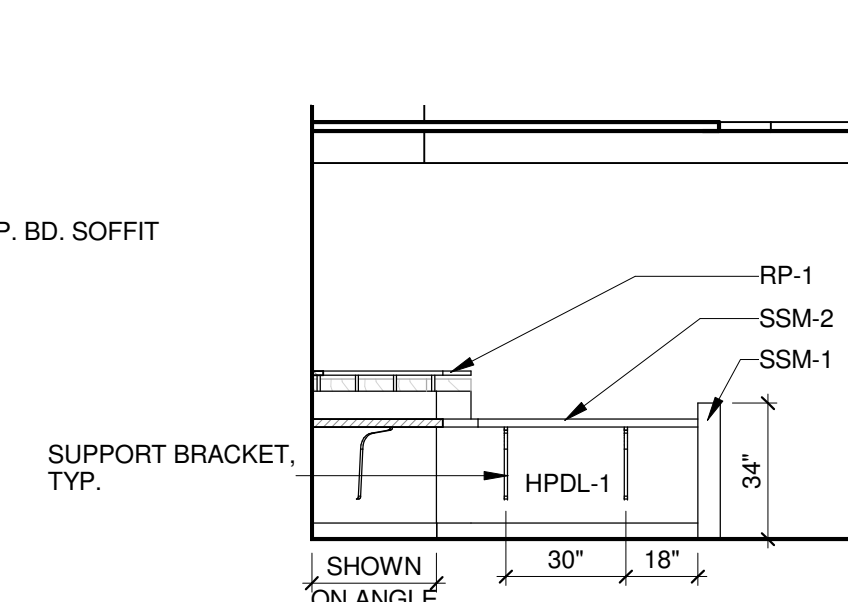

18 CHARTING
SCALE: 1/4" = 1'-0"

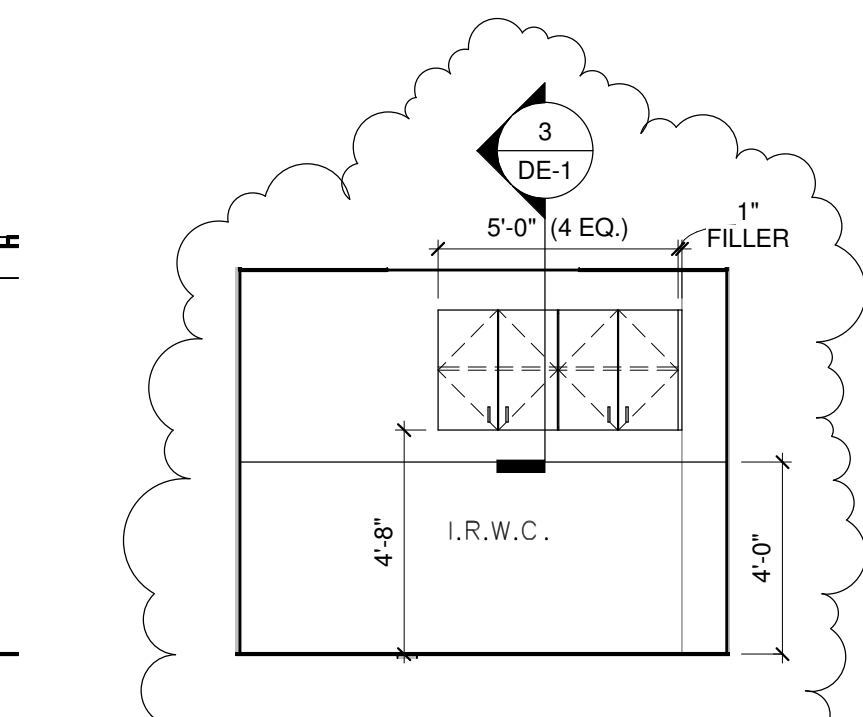

19 EXISTING HAC 4N-033
SCALE: 1/4" = 1'-0"

CONSULTANTS:

ARCHITECTS/ENGINEERS:

ARCHITECTURAL PROJECT # 18101

Drawing Title
INTERIOR ELEVATIONS

Project Title
RENOVATE PATIENT WARDS FOR
PRIVACY, 3RD AND 4TH FLOOR, B-330

Project Number
552-13-202
Building Number
B-330

Office of
Construction
and Facilities
Management

Location
4100 WEST THIRD STREET, DAYTON, OH, 45428

Date
January 25, 2013
Checked
NS/K/ML/TH
Drawn
APOB

Drawing Number
A-19
Dwg. 25 of 87

Department of
Veterans Affairs

AMENDMENT NO. 1	07/30/2013
100% SUBMISSION	12/14/2012
75% SUBMISSION	10/19/2012
Revisions	Date

