


6 APRIL 2012
Sketch GSK-generator

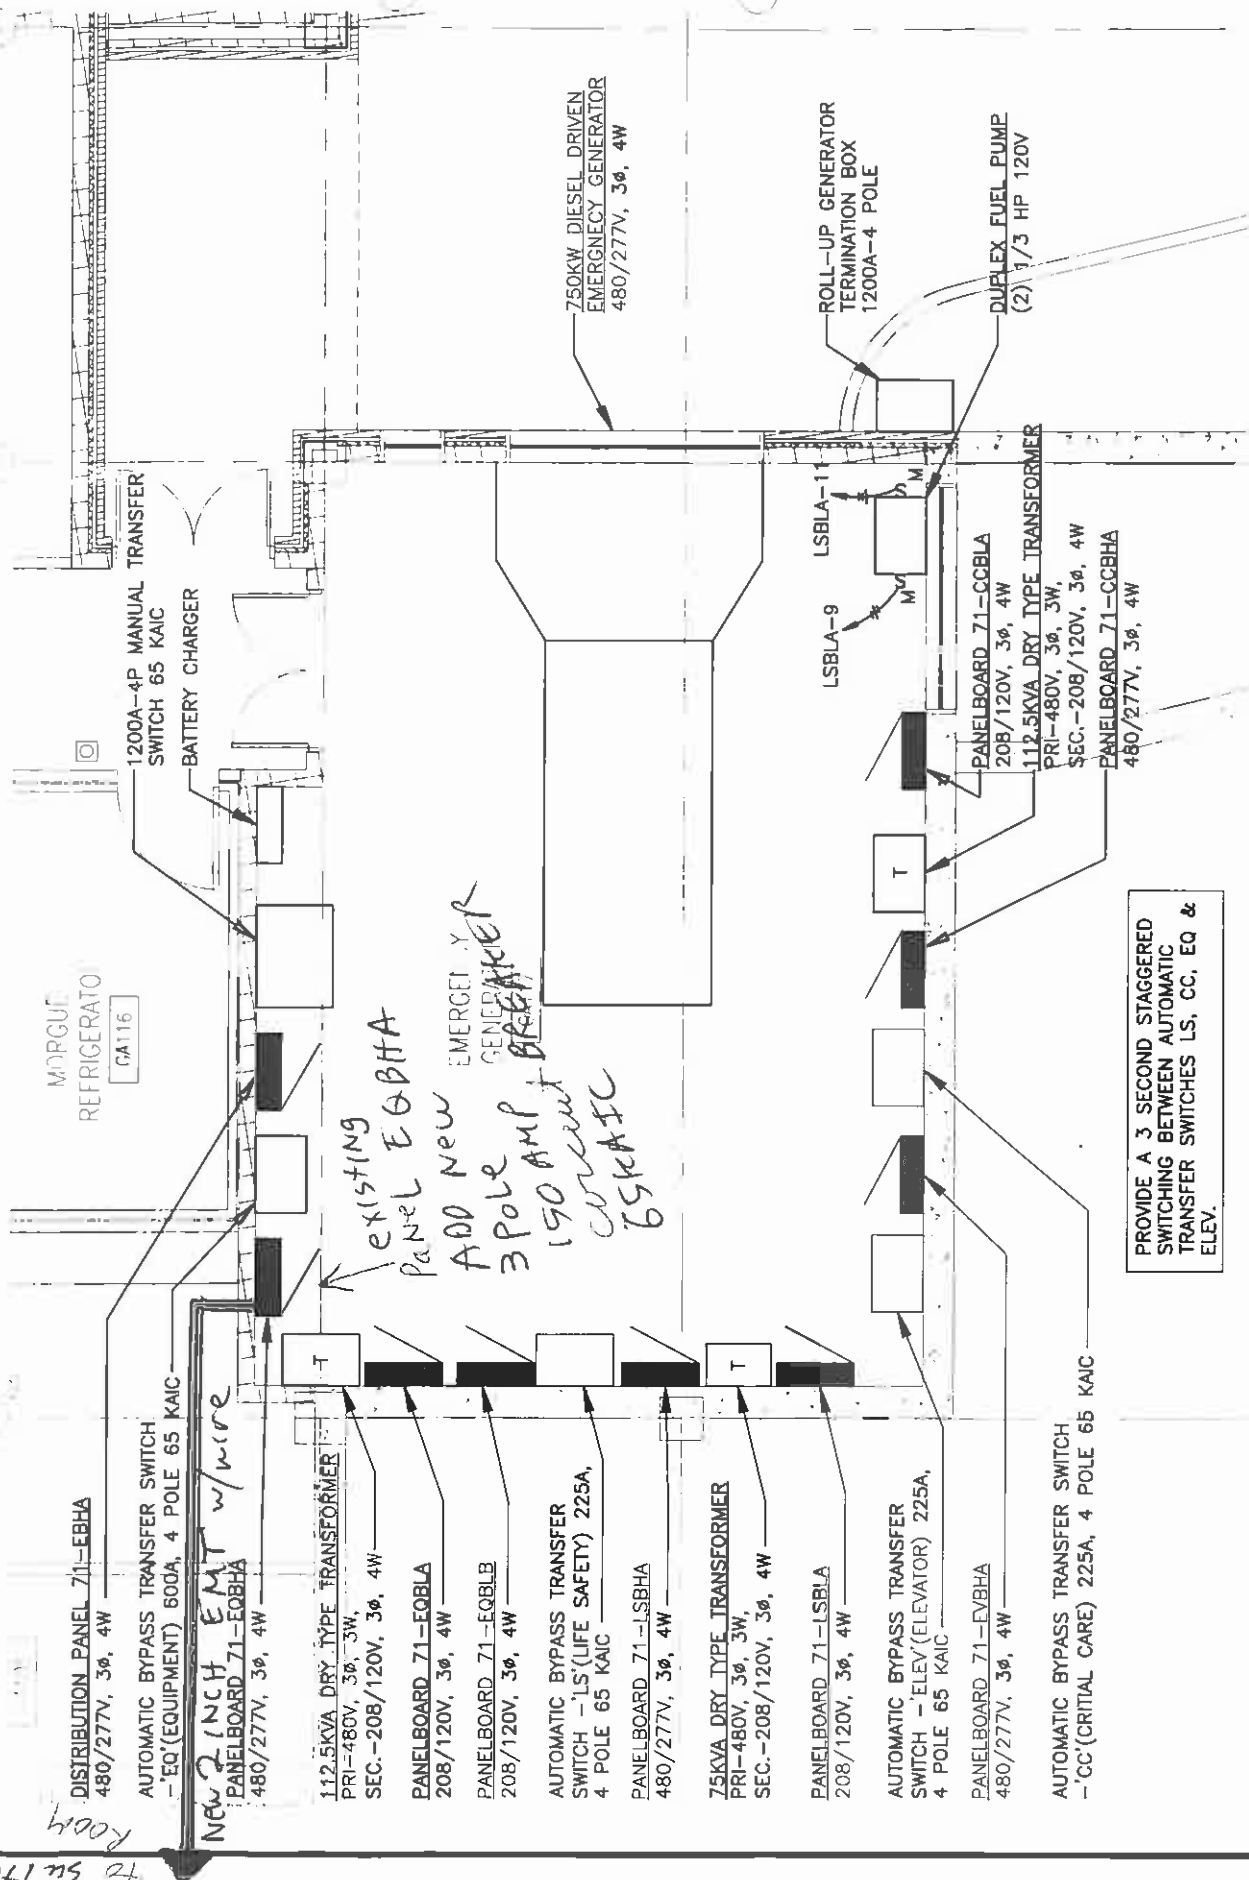

2 Power Emergency Generator Room

SCALE: 1/4"=1'-0"