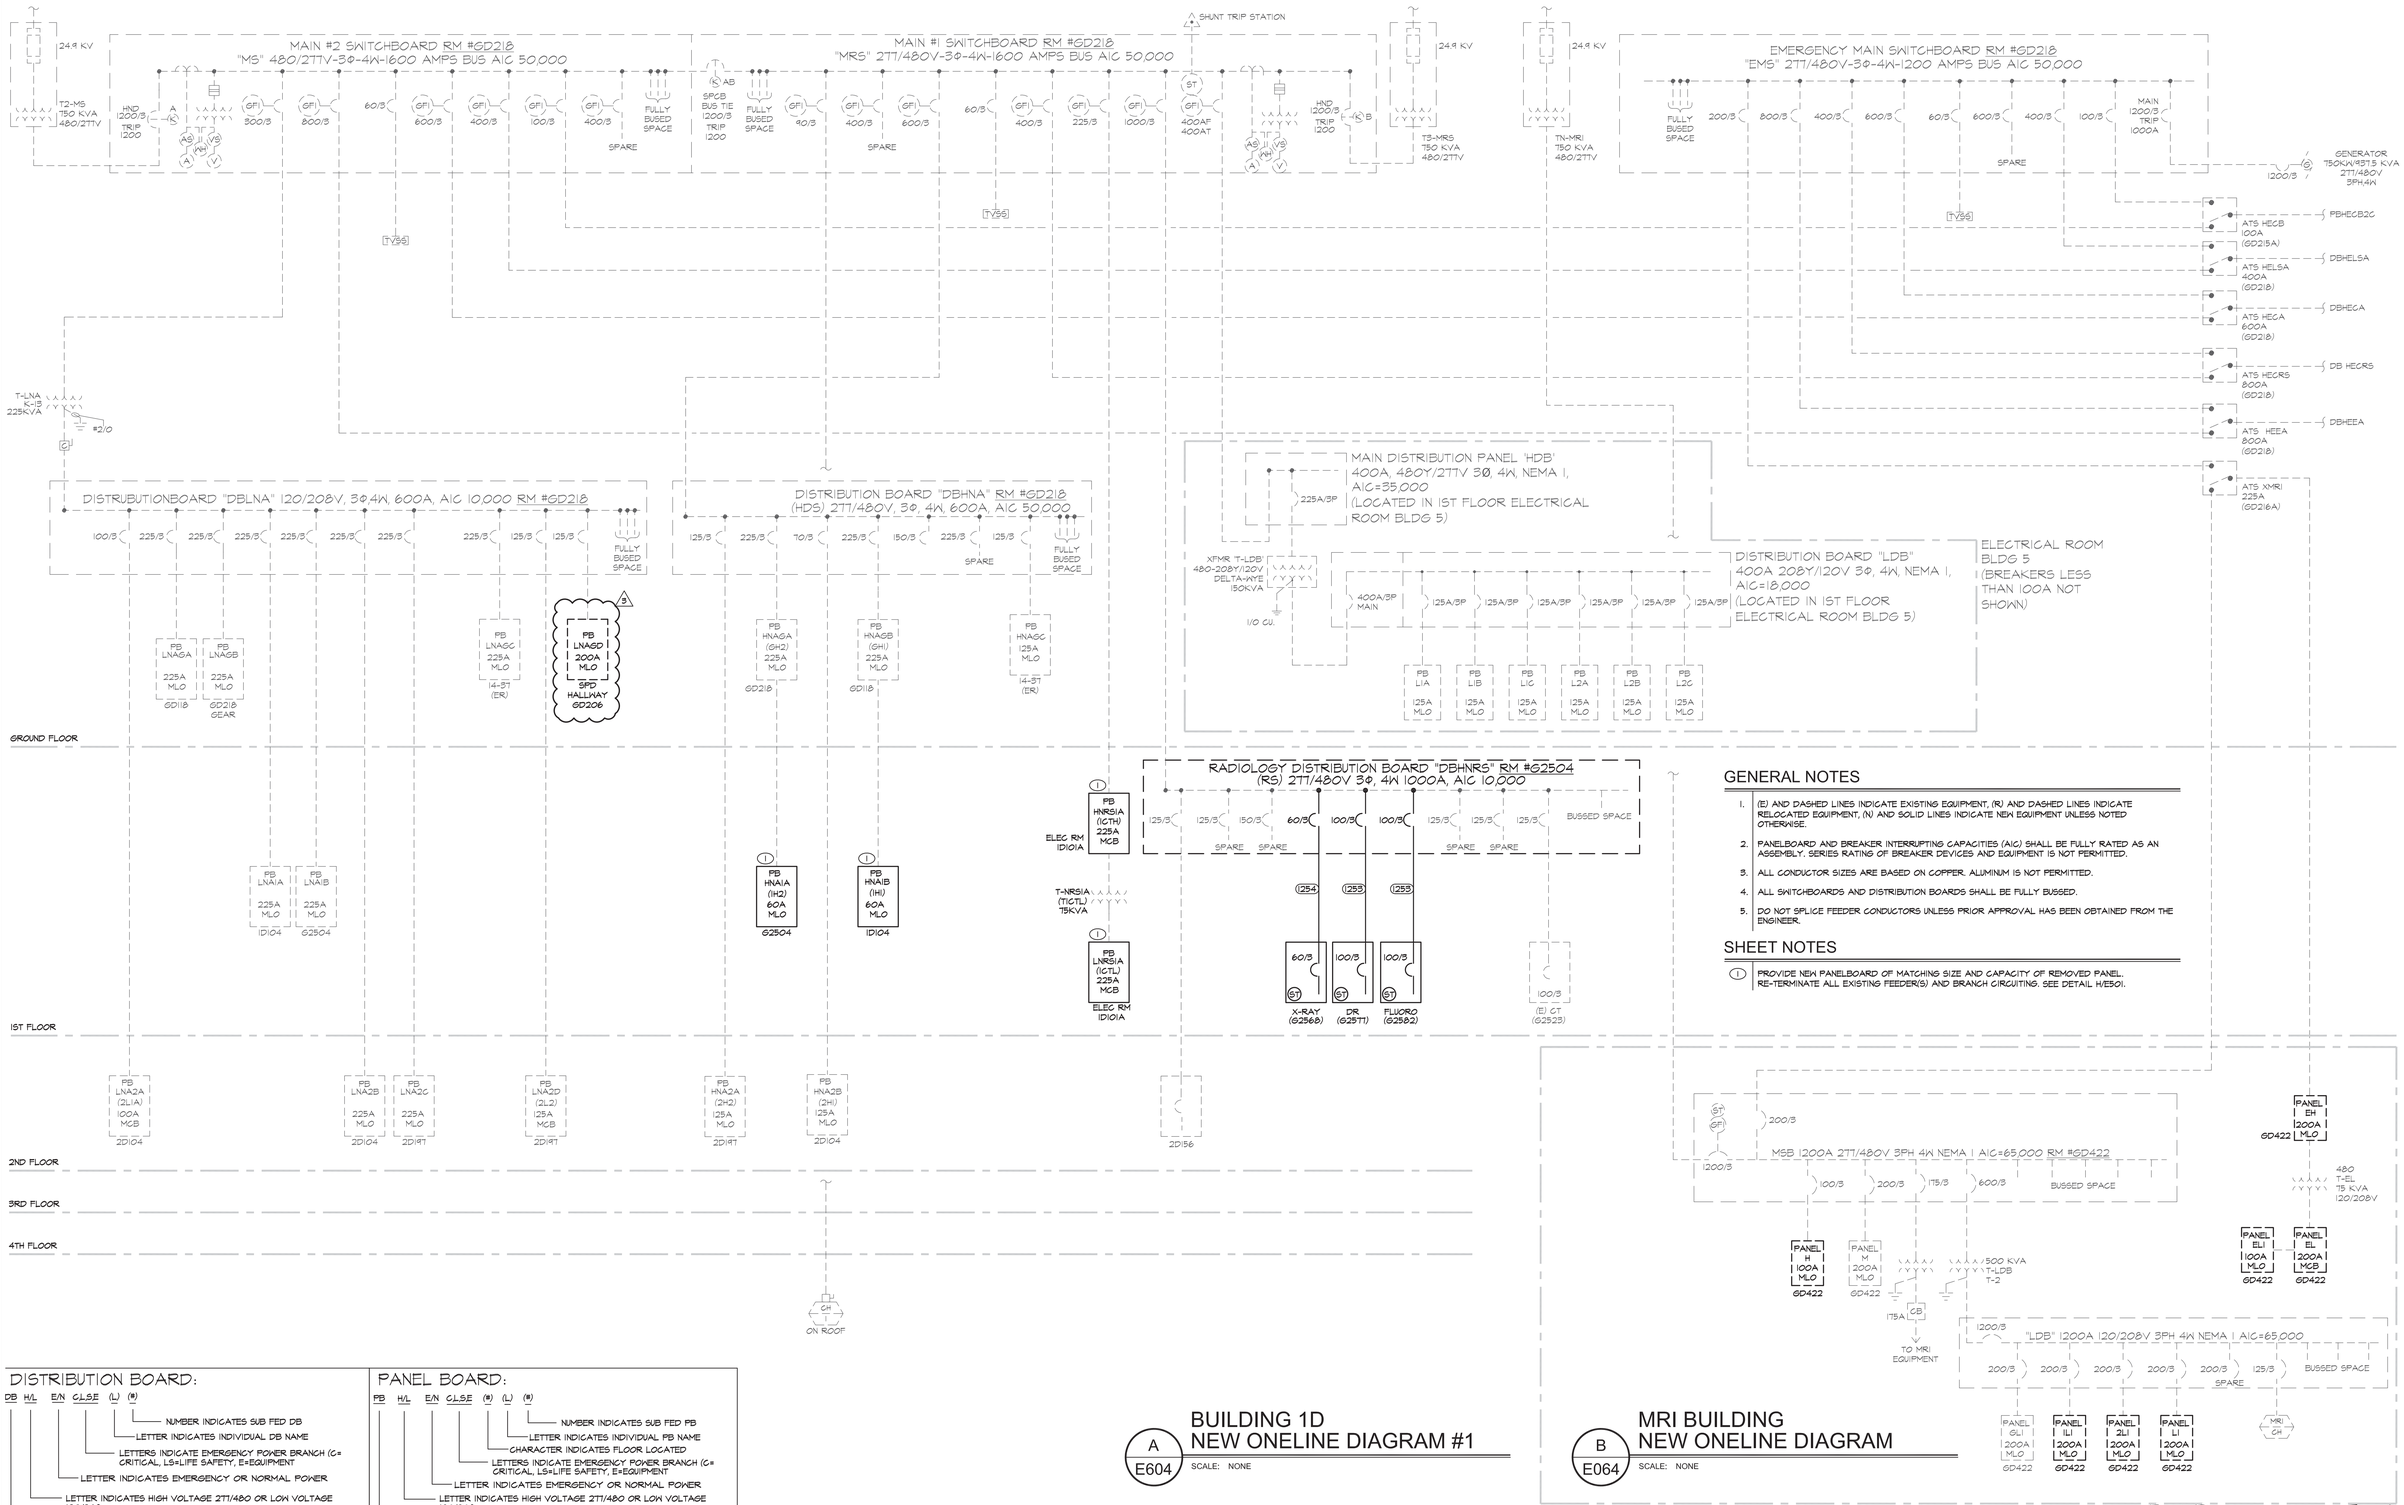

GENERAL NOTES

1. (E) AND DASHED LINES INDICATE EXISTING EQUIPMENT, (R) AND DASHED LINES INDICATE RELOCATED EQUIPMENT, (N) AND SOLID LINES INDICATE NEW EQUIPMENT UNLESS NOTED OTHERWISE.
2. PANELBOARD AND BREAKER INTERRUPTING CAPACITIES (AIC) SHALL BE FULLY RATED AS AN ASSEMBLY. SERIES RATING OF BREAKER DEVICES AND EQUIPMENT IS NOT PERMITTED.
3. ALL CONDUCTOR SIZES ARE BASED ON COPPER. ALUMINUM IS NOT PERMITTED.
4. ALL SWITCHBOARDS AND DISTRIBUTION BOARDS SHALL BE FULLY BUSSED.
5. DO NOT SPLICE FEEDER CONDUCTORS UNLESS PRIOR APPROVAL HAS BEEN OBTAINED FROM THE ENGINEER.

SHEET NOTES

(1) PROVIDE NEW PANELBOARD OF MATCHING SIZE AND CAPACITY OF REMOVED PANEL. RE-TERMINATE ALL EXISTING FEEDER(S) AND BRANCH CIRCUITING. SEE DETAIL H/ESOI.

DISTRIBUTION BOARD:

DB H/L E/N CLSE (L) (#)

- (#): NUMBER INDICATES SUB FED DB
- (L): LETTER INDICATES INDIVIDUAL DB NAME
- CLSE: LETTERS INDICATE EMERGENCY POWER BRANCH (C= CRITICAL, LS=LIFE SAFETY, E=EQUIPMENT
- E/N: LETTER INDICATES EMERGENCY OR NORMAL POWER
- H/L: LETTER INDICATES HIGH VOLTAGE 277/480 OR LOW VOLTAGE 120/208
- DB: DISTRIBUTION BOARD

PANEL BOARD:

PB H/L E/N CLSE (#) (L) (#)

- (#): NUMBER INDICATES SUB FED PB
- (L): LETTER INDICATES INDIVIDUAL PB NAME
- (#): CHARACTER INDICATES FLOOR LOCATED
- CLSE: LETTERS INDICATES EMERGENCY POWER BRANCH (C= CRITICAL, LS=LIFE SAFETY, E=EQUIPMENT
- E/N: LETTER INDICATES EMERGENCY OR NORMAL POWER
- H/L: LETTER INDICATES HIGH VOLTAGE 277/480 OR LOW VOLTAGE 120/208
- PB: PANEL BOARD

A E604 — BUILDING 1D NEW ONELINE DIAGRAM #1
SCALE: NONE

B E064 — MRI BUILDING NEW ONELINE DIAGRAM
SCALE: NONE

Bid Documents - Final

Revisions:	Date

CONSULTANTS:

PROFESSIONAL ENGINEER - STATE OF NEVADA — JOSEPH E. GANSER — EXP: 06/30/15 — ELECTRICAL — No.21011

PK Electrical, Inc.
681 Sierra Rose Dr., Ste. B • Reno, Nevada 89511
p. 775.826.9010 • f. 775.826.9030 • pkelectrical.com
11022

Professional Seal

ARCHITECT/ENGINEERS:
H+K ARCHITECTS
5485 Reno Corporate Drive, Suite 100
Reno, Nevada 89511-2262
P 775+332+6640
F 775+332+6642
hkarchitects.com

Drawings Title	Building 1D New Oneline Diagram #1
Approved: Project Director	
Project Title	Remodel and Expansion of DICE Services
Location	975 Kirman Avenue, Reno, NV. 89502
Date	4/4/2013
Checked	JEG
Drawn	SG
Project Number	654-777
Building Number	1D
Drawing Number	E604

Office of Construction and Facilities Management
Department of Veterans Affairs

12/17/2007 12:01:54 PM File Path

VA FORM 08-6231