
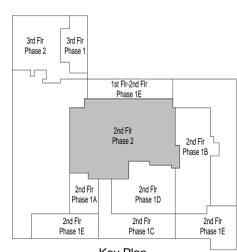


Sheet Notes

- All door locations in gypsum board partitions not dimensioned will be 4" from the studs of perpendicular wall to door edge (U.N.O.).
- All dimensions are from face-of-stud, face of concrete, or center of framed opening, unless noted otherwise.
- For dimensions of masonry walls and rough openings, see the Structural drawings. Masonry dimensions shown on this plan are for reference only. Any discrepancies found between the dimensions on this sheet and the Structural drawings shall be brought to the immediate attention of the Architect.
- Provide 6" wide, 24 gage flat strap blocking behind all fixtures and wall mounted accessories. This includes cabinets and any other items that are wall mounted. Blocking shall span a minimum of three studs and be connected to each stud with a minimum of two screws.
- Refer to Mechanical and Electrical plans for equipment related to those disciplines. All required equipment not necessarily noted on this sheet.
- Room Signage: Provide signs adjacent to doors where indicated on interior elevations. Signs will be ADA compliant and the text will be that indicated on the Room Signage Schedule.
- Openings, pockets, etc. shall not be placed in slabs, beams, columns, walls, etc., unless specifically detailed on the drawings.
- Cap all open ends in structural steel components, typical.
- The exposed concrete floors will have all exposed construction and control joints sealed with a polyurethane sealant bead (backer rod where required).
- Provide a rubber-vinyl reducer or transition trim at all intersections of carpet and resilient tile, carpet and vinyl sheet goods, or at all edges of carpet that abut a raised or lowered surface of dissimilar material. Note: Provide replacement transitions or reducers only where removal of existing flooring is not required for transition of reducer trim replacement.
- Refer to the Site Plan for concrete stoops and walkways.
- Equipment is shown for reference only. Equipment to be provided by Owner and installed under separate contract.
- Kitchen equipment is Owner supplied and Contractor installed. Contractor is to provide rough-ins for Plumbing and Electrical. The Contractor shall also provide the Mechanical exhaust, exhaust hood and make-up air. The Contractor shall complete the final hookup and installation of the kitchen equipment as provided by the Owner. Coordinate exact locations of rough-ins with the owner's kitchen consultant prior to construction. See Food Service, Mechanical, Plumbing and Electrical Drawings.
- There should be no surface mounted conduit. All conduit to be concealed.
- See Code Analysis Plans, sheets G211, G212 and G213, for fire rated construction, rated enclosures, and occupancy classifications.
- The Contractor shall install one (1) recess mounted "Knob Box" #3270 (Black) #3273 (Aluminum) or surface mounted "Knob Box" #3261 (Black) #3263 (Aluminum) in an exterior wall location selected by the Owner and installed 6'-0" A.F.F. The Contractor shall include the cost of the "Knob Box" in his bid and shall acquire "Knob Box" in association with the local fire agency. Contractor shall include all labor for installation in his bid.
- Sand, grind, or patch (e) concrete floor as required to accommodate new construction. Install leveling compound as required. See Structural drawings for additional information.
- Where new gypsum board walls abut existing concrete scribe to fit tightly and caulk. Rated walls shall receive fire rated sealant where required to maintain rating.
- Repair and repaint the entire wall where alteration work is performed, U.N.O. Paint color to match (e) walls and areas adjacent.
- All touch up and new painting will be as follows:
Bottom coat: Latex primer
Intermediate coat and top coat: Acrylic Latex Enamel
Shen shall match existing adjacent surfaces. Contractor to coordinate paint manufacturer with Owner to match (e) maintenance paint stock.
- Texture all existing gypsum board walls to match texture of new walls where noted.
- Where plumbing fixtures are to be removed and no new fixture is to be installed, patch water supply hole with gypsum board, texture and paint to match wall. At waste opening, provide new chrome clean out cover plate with vandal resistant screw. Plate to be attached to cap inside chase. Provide interior sealant around perimeter of new cover plate.
- The Contractor shall clean all existing ceramic tile prior to installing any new fixtures and toilet partitions.
- Temporary construction walls and other measures must conform to Infection Prevention Measures as prescribed in Division 01 - General Requirements and reviewed with the VASNHC's Infection Control Risk Assessment (ICRA) team.
- All construction activities need to be coordinated with the schedule of operations of the areas adjacent to construction including any areas above or below that may be impacted.
- The contractor shall be responsible for coordinating support systems for medical equipment, to be supplied and installed by others. Due to the technical nature of the medical equipment, it is imperative the contractor request and obtain product information from the resident engineer prior to system rough-in. If the equipment to be installed differs in model, model or location from that shown on the construction drawings, the contractor shall notify the architect immediately. The rough-in work may not proceed until the architect and the design team has reviewed the MPPE systems, structural support and radiation shielding for compatibility with the construction drawings.

Wall Legend

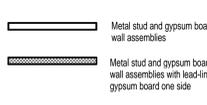

Bid Documents - Final

Office of Construction and Facilities Management



Project Number
654-777

Building Number
1D

Drawing Number
AE125

Project Title
Remodel and Expansion of DICE Services

Location
975 Kirman Avenue, Reno, NV 89502


Date
4/4/2013

Checked
LM

Drawn
DG

Drawings Title
Second Floor Phase 2 Floor Plan

Approved: Project Director

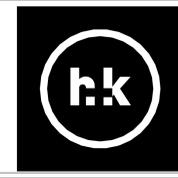

ARCHITECT/ENGINEERS:
H+K ARCHITECTS
5485 Reno Corporate Drive, Suite 100
Reno, Nevada 89511-2262
P 775-332-6640
F 775-332-6642
hkarchitects.com




CONSULTANTS:

Number	Revision	Date
3	Revision 3	7/22/13
4	Revision 4	8/5/13

1 Second Floor Phase 2 Plan

1/4" = 1'-0"

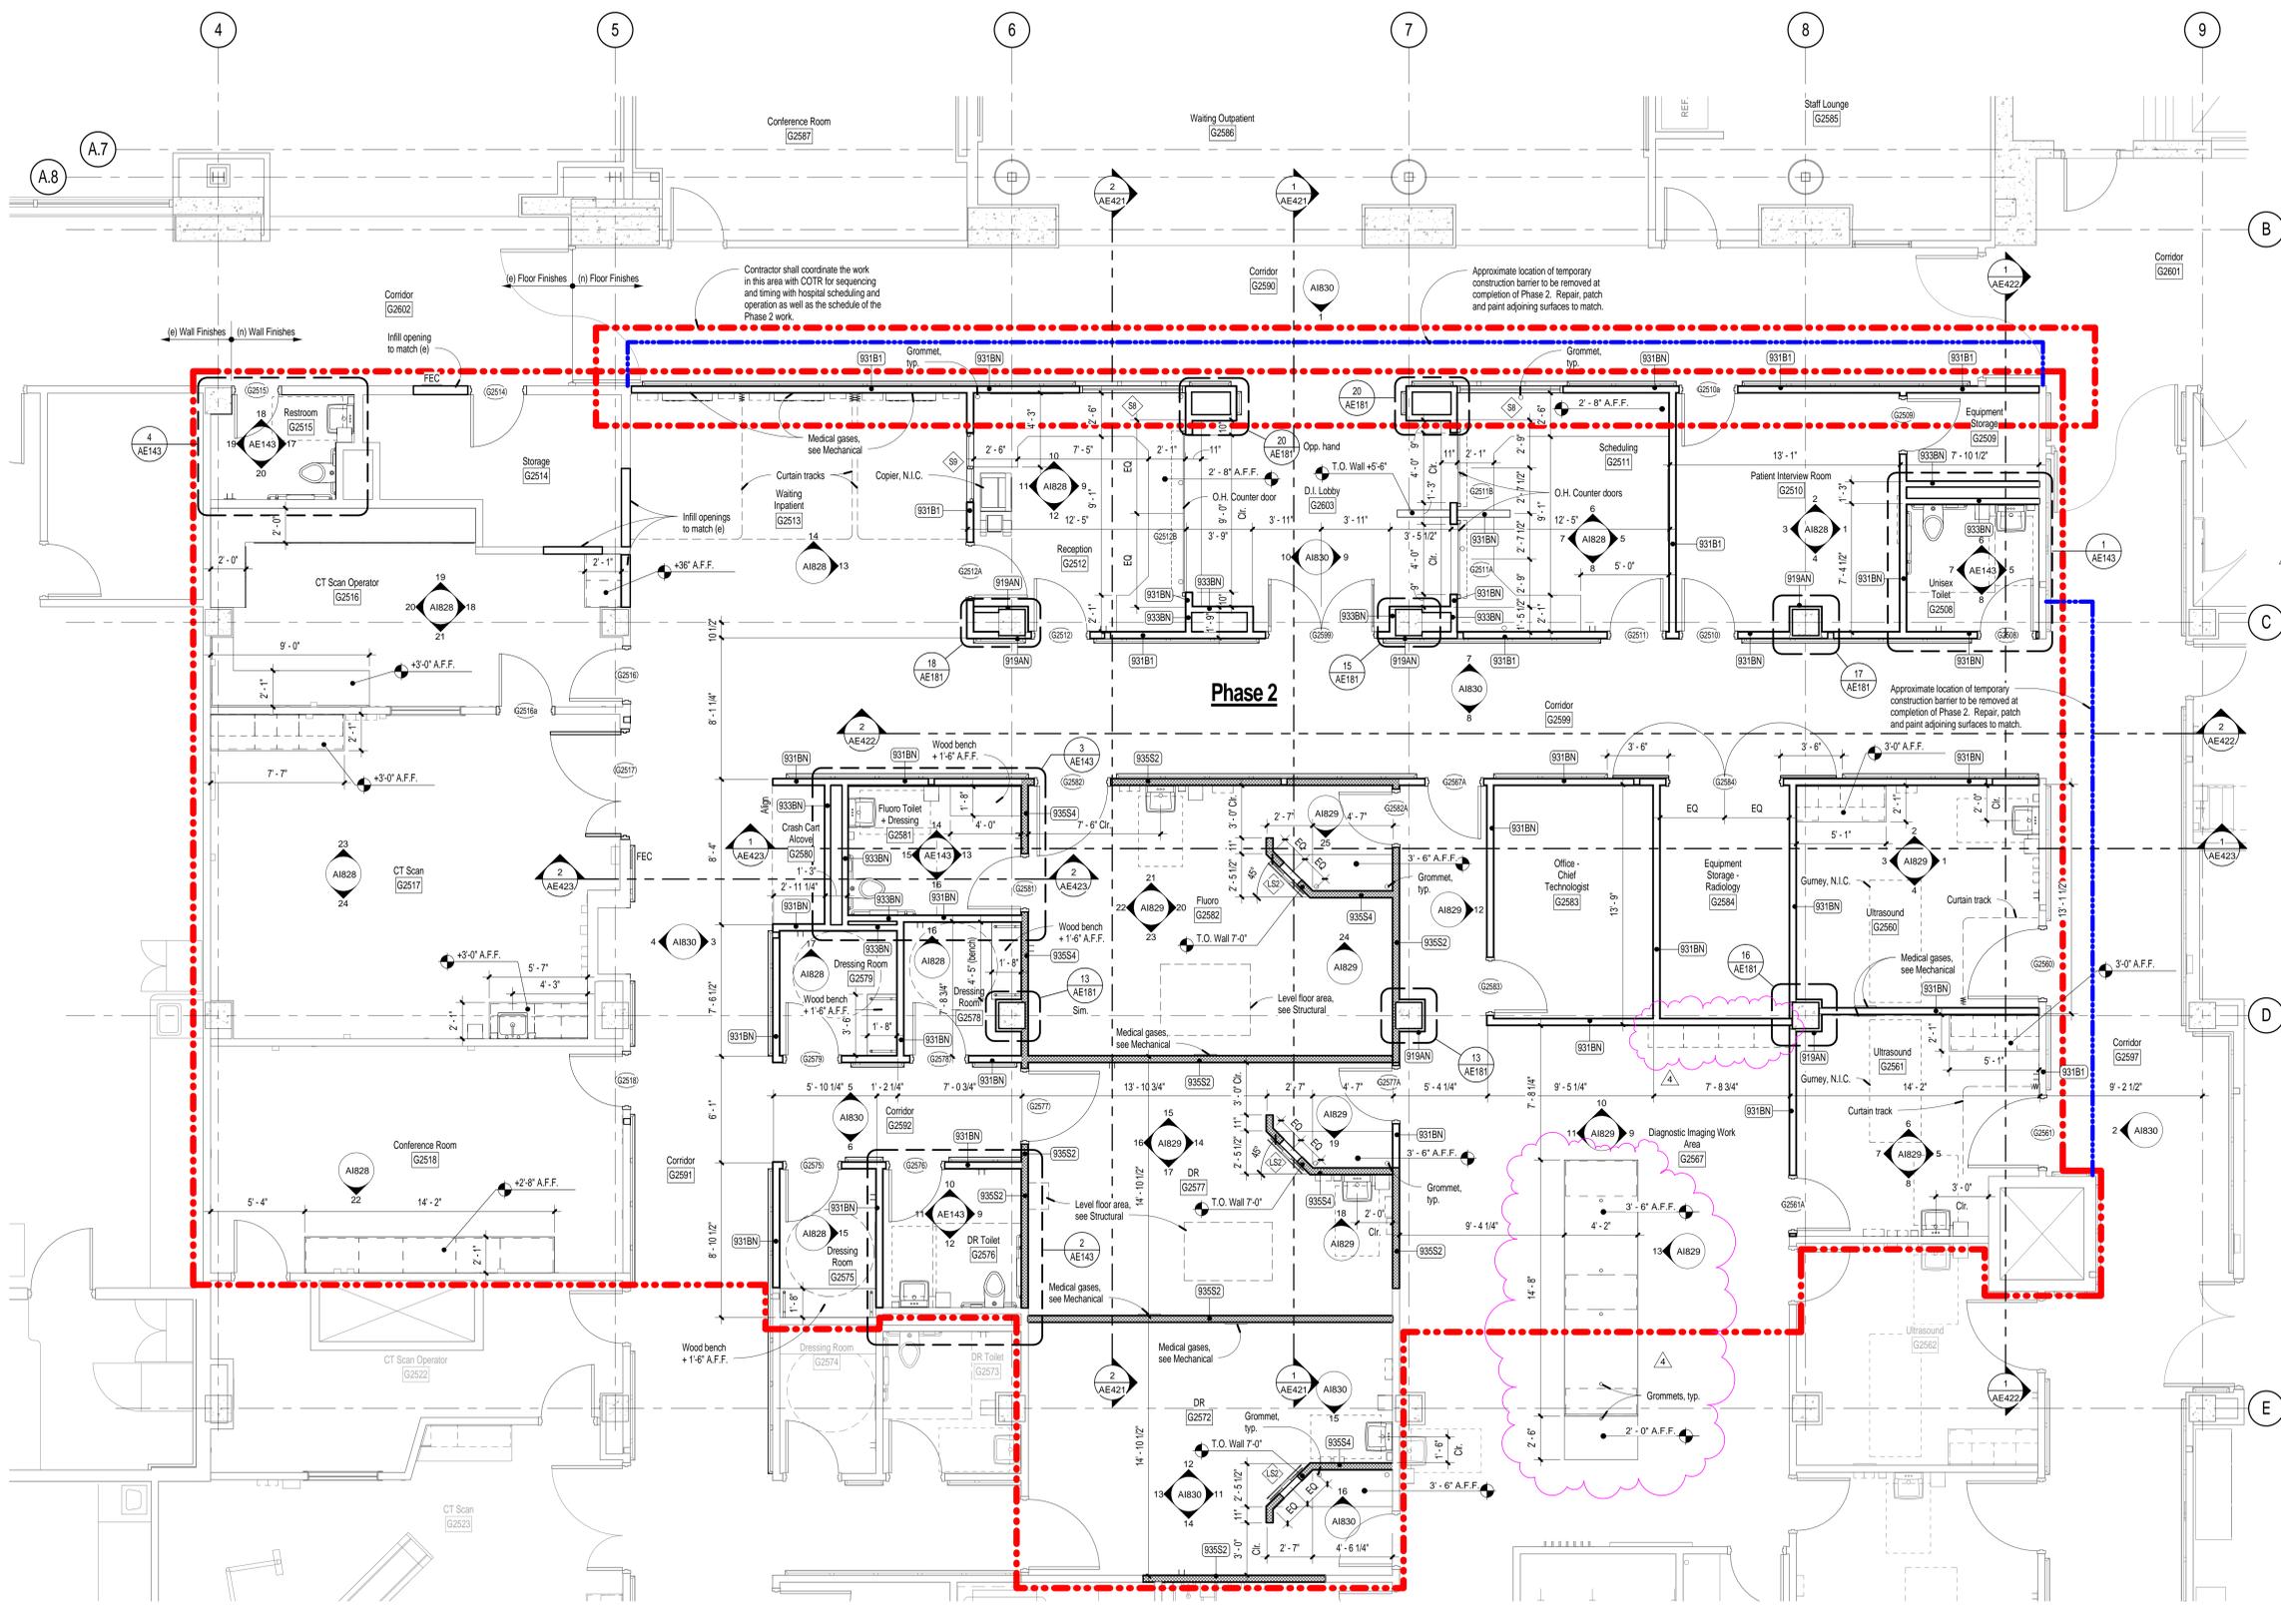


three inches = one foot.
 one and one half inches = one foot.
 three quarters inch = one foot.
 one half inch = one foot.
 three eighths inch = one foot.
 one quarter inch = one foot.
 one eighth inch = one foot.
 8/20/13 10:31:52 AM CHH Local Project 0301030 VA DICE Local Drawn

31 CT Scan G2523 North
1/4" = 1'-0"

30 CT Scan G2523 East
1/4" = 1'-0"

29 Corridor G2598 South
1/4" = 1'-0"

28 Corridor G2598 West
1/4" = 1'-0"

27 Corridor G2598 East
1/4" = 1'-0"

26 Office - Staff Radiologist South
1/4" = 1'-0"

25 Office - Staff Radiologist East
1/4" = 1'-0"

24 Patient Prep G2544 West
1/4" = 1'-0"

23 Patient Prep G2544 South
1/4" = 1'-0"

22 Patient Prep G2544 East
1/4" = 1'-0"

21 Staff Lockers-Womens G2533 South
1/4" = 1'-0"

20 Staff Lockers-Womens G2533 West
1/4" = 1'-0"

19 Staff Lockers-Womens G2533 North
1/4" = 1'-0"

18 Staff Lockers-Womens G2533 East
1/4" = 1'-0"

17 Staff Lockers-Mens G2529 South
1/4" = 1'-0"

16 Staff Lockers-Mens G2529 West
1/4" = 1'-0"

15 Staff Lockers-Mens G2529 North
1/4" = 1'-0"

14 Staff Lockers-Mens G2529 East
1/4" = 1'-0"

13 IR Viewing/Consultation Room G2525 South
1/4" = 1'-0"

12 IR Viewing/Consultation Room G2525 West
1/4" = 1'-0"

11 IR Viewing/Consultation Room G2525 North
1/4" = 1'-0"

10 IR Viewing/Consultation Room G2525 East
1/4" = 1'-0"

9 IR Control Room G2540
1/4" = 1'-0"

8 IR Control Room G2540 South
1/4" = 1'-0"

7 IR Control Room G2540 West
1/4" = 1'-0"

6 IR Control Room G2540 North
1/4" = 1'-0"


5 IR Control Room G2540 East
1/4" = 1'-0"

4 TEE/Bronchoscopy G2545 South
1/4" = 1'-0"

3 TEE/Bronchoscopy G2545 West
1/4" = 1'-0"

2 TEE/Bronchoscopy G2545 North
1/4" = 1'-0"

1 TEE/Bronchoscopy G2545 East
1/4" = 1'-0"

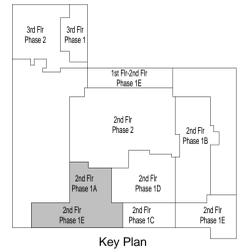

Number	Revision	Date
3	Revision 3	7/22/13
4	Revision 4	8/5/13

CONSULTANTS:



ARCHITECT/ENGINEERS:
H+K ARCHITECTS
 5485 Reno Corporate Drive, Suite 100
 Reno, Nevada 89511-2262
 P 775-332-6640
 F 775-332-6642
 hkarchitects.com



Drawings Title
Second Floor Phase 1A, 1C, 1E East & 1E West Interior Elevations

Approved: Project Director

Project Title
 Remodel and Expansion of
 DICE Services

Location
 975 Kirman Avenue, Reno, NV 89502

Date
 4/4/2013

Checked
 LM

Drawn
 DG

Project Number
 654-777


Building Number
 1D

Drawing Number
A1822


Office of
 Construction
 and Facilities
 Management

Department of
 Veterans Affairs


three inches = one foot.
 one and one half inches = one foot.
 one inch = one foot.
 three quarters inch = one foot.
 one half inch = one foot.
 three eighths inch = one foot.
 one quarter inch = one foot.
 one eighth inch = one foot.

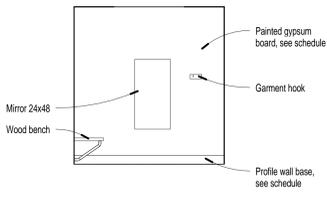


25 Dressing Room G2574 East
 1/4" = 1'-0"

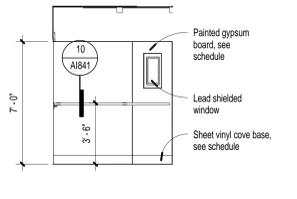


24 X-Ray, Chest and Skull Control G2568 South
 1/4" = 1'-0"

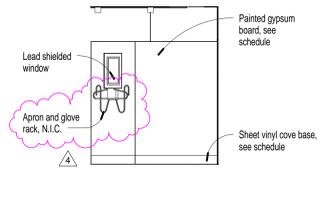


23 X-Ray, Chest and Skull G2568 Partial North
 1/4" = 1'-0"

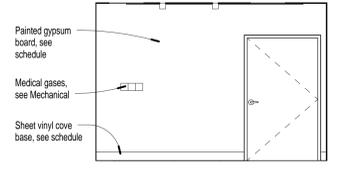


22 X-Ray, Chest and Skull G2568 South
 1/4" = 1'-0"

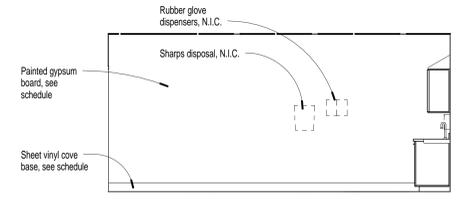


21 X-Ray, Chest and Skull G2568 West
 1/4" = 1'-0"

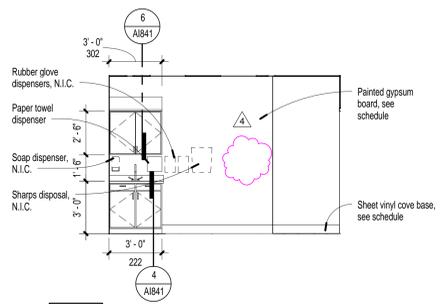


20 X-Ray, Chest and Skull G2568 North
 1/4" = 1'-0"

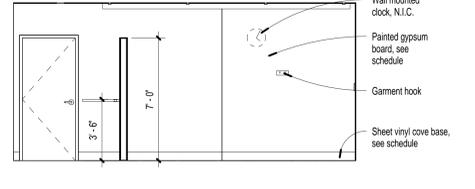


19 X-Ray, Chest and Skull G2568 East
 1/4" = 1'-0"

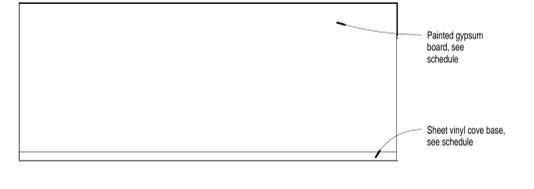


18 Diagnostic Imaging Work Area G2567 Partial East
 1/4" = 1'-0"

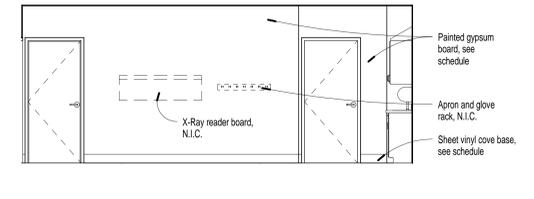


17 Diagnostic Imaging Work Area G2567 South
 1/4" = 1'-0"

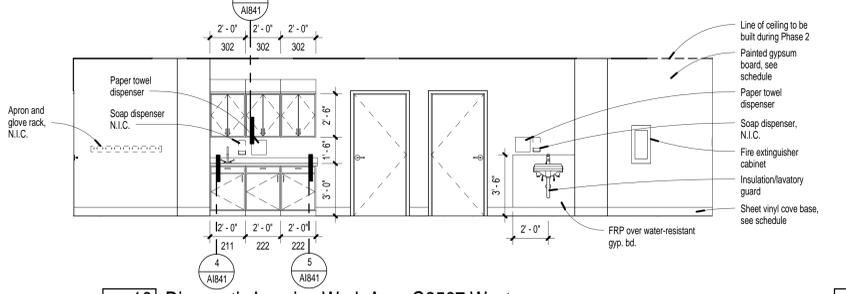


16 Diagnostic Imaging Work Area G2567 West
 1/4" = 1'-0"

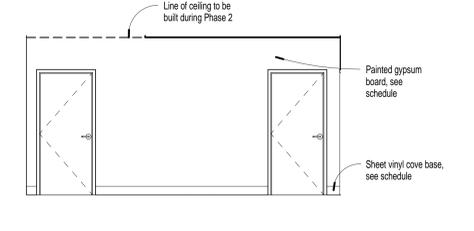


15 Diagnostic Imaging Work Area G2567 East
 1/4" = 1'-0"

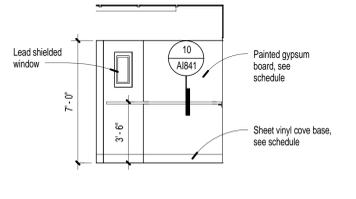


14 Fluoro Control G2566 West
 1/4" = 1'-0"

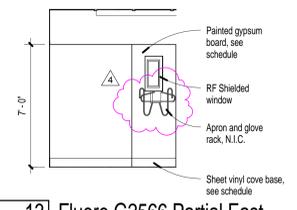


13 Fluoro G2566 Partial East
 1/4" = 1'-0"

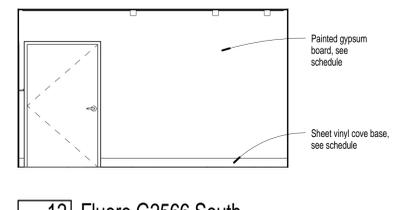


12 Fluoro G2566 South
 1/4" = 1'-0"

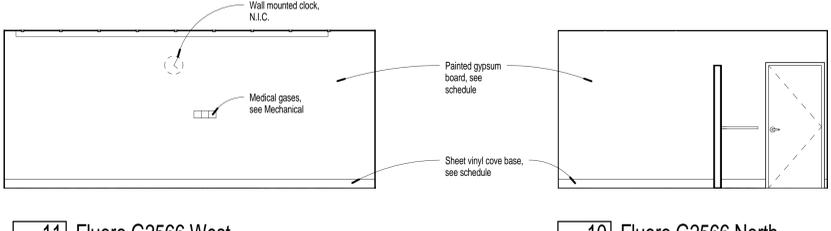


11 Fluoro G2566 West
 1/4" = 1'-0"

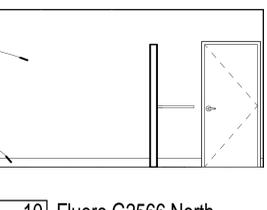


10 Fluoro G2566 North
 1/4" = 1'-0"

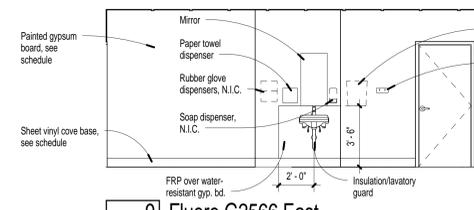


9 Fluoro G2566 East
 1/4" = 1'-0"

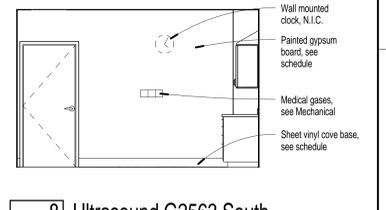


8 Ultrasound G2563 South
 1/4" = 1'-0"

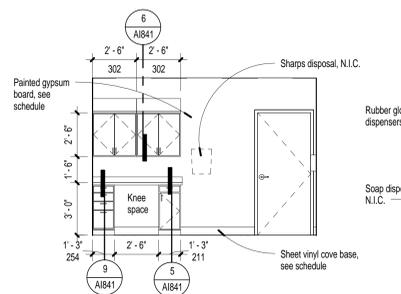


7 Ultrasound G2563 West
 1/4" = 1'-0"

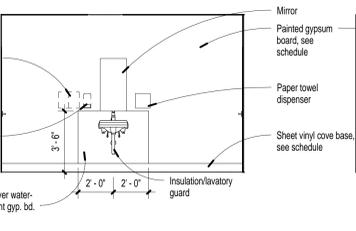


6 Ultrasound G2563 North
 1/4" = 1'-0"

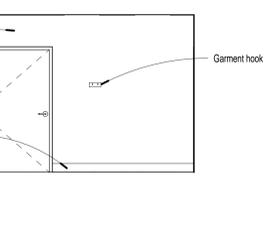


5 Ultrasound G2563 East
 1/4" = 1'-0"

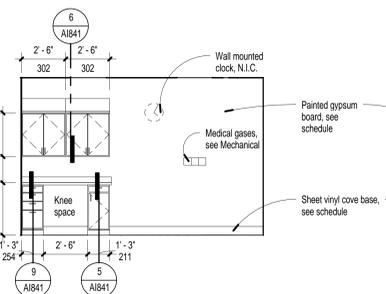


4 Ultrasound G2562 South
 1/4" = 1'-0"

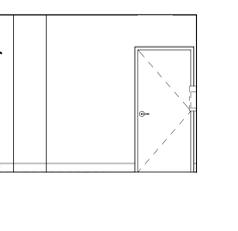


3 Ultrasound G2562 West
 1/4" = 1'-0"

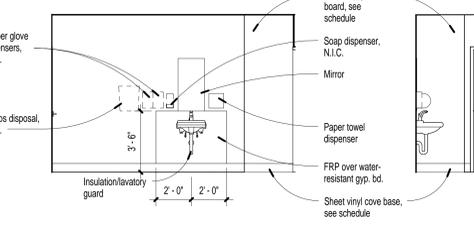

2 Ultrasound G2562 North
 1/4" = 1'-0"

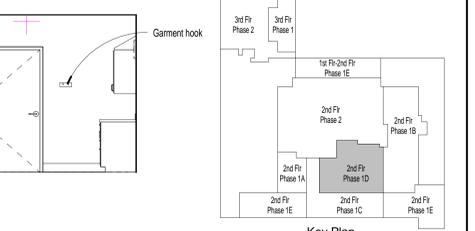

1 Ultrasound G2562 East
 1/4" = 1'-0"

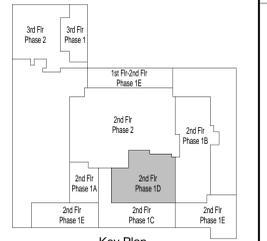

Key Plan

Number	Revision	Date
4	Revision 4	8/5/13

CONSULTANTS:



ARCHITECT/ENGINEERS:
H+K ARCHITECTS
 5485 Reno Corporate Drive, Suite 100
 Reno, Nevada 89511-2262
 P 775+332+6640
 F 775+332+6642
 hkarchitects.com



Drawings Title
Second Floor Phase 1D Interior Elevations
 Approved: Project Director







Project Title
 Remodel and Expansion of
 DICE Services
 Location
 975 Kirman Avenue, Reno, NV 89502
 Date
 4/4/2013
 Checked
 LM
 Drawn
 DG

Project Number
 654-777
 Building Number
 1D
 Drawing Number
A1825

Office of
 Construction
 and Facilities
 Management
 Department of
 Veterans Affairs

Bid Documents - Final

three inches = one foot.
 one and one half inches = one foot.
 one inch = one foot.
 three quarters inch = one foot.
 one half inch = one foot.
 three eighths inch = one foot.
 one quarter inch = one foot.
 one eighth inch = one foot.
 8/2013 10:28:59 AM CHH Local Project 03010302 VA DICE Local 08/13

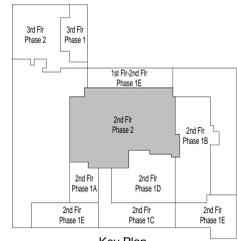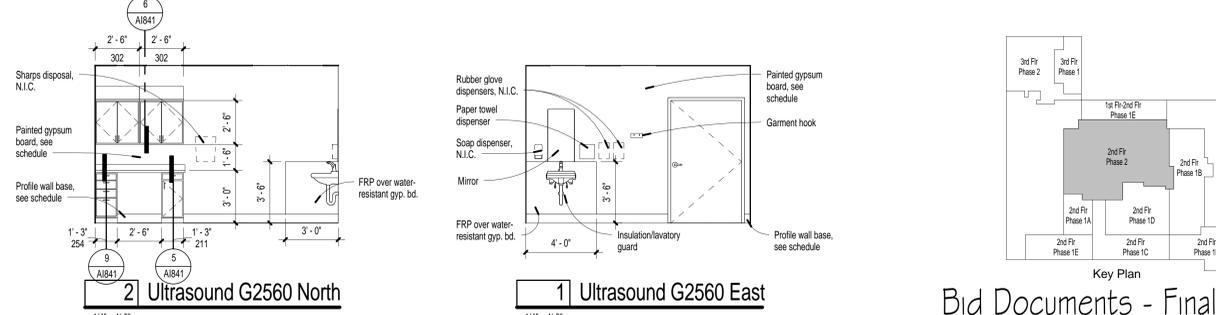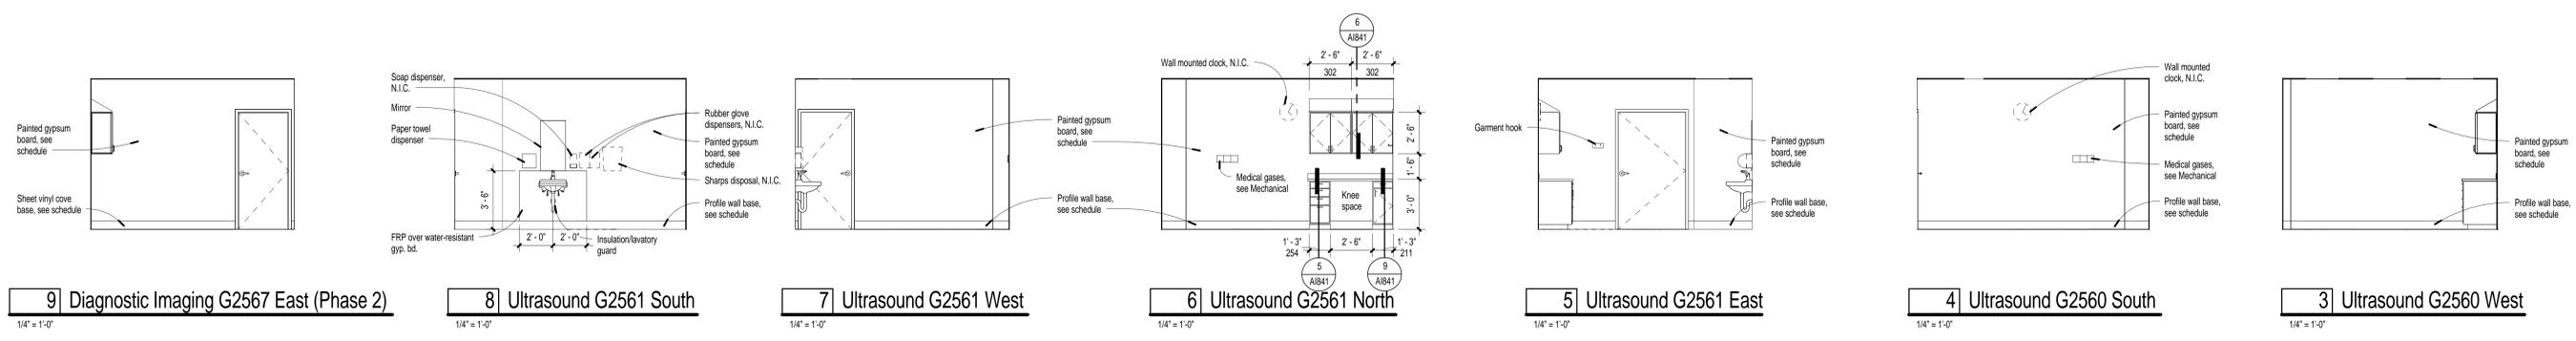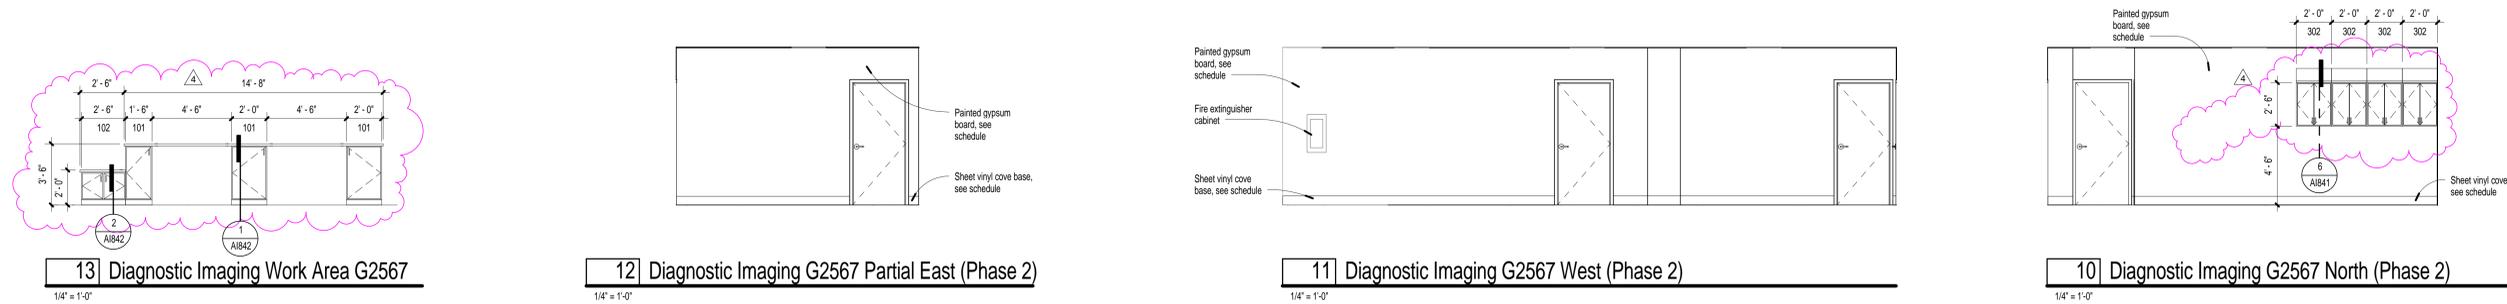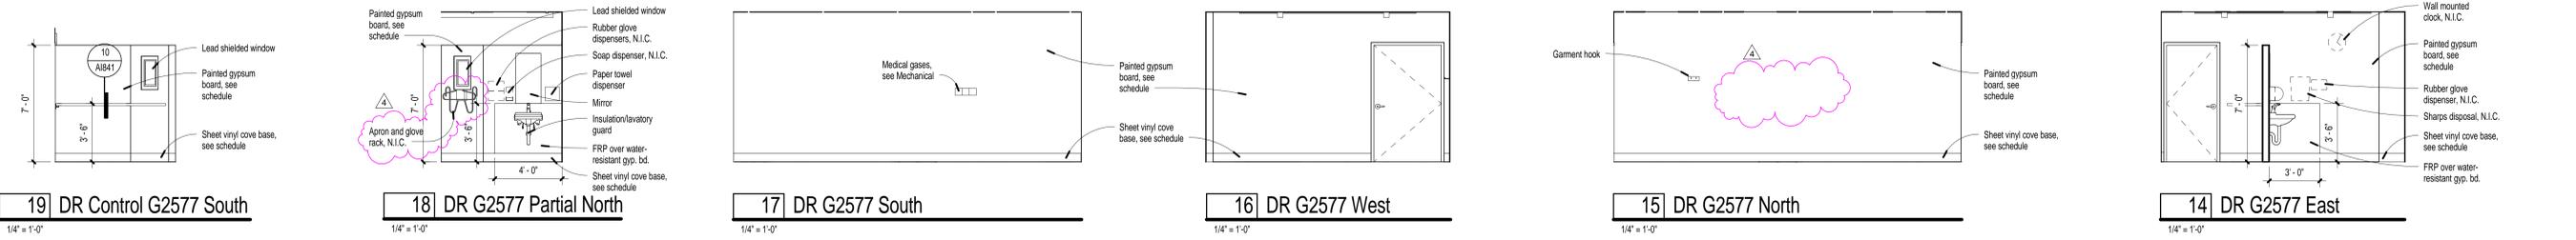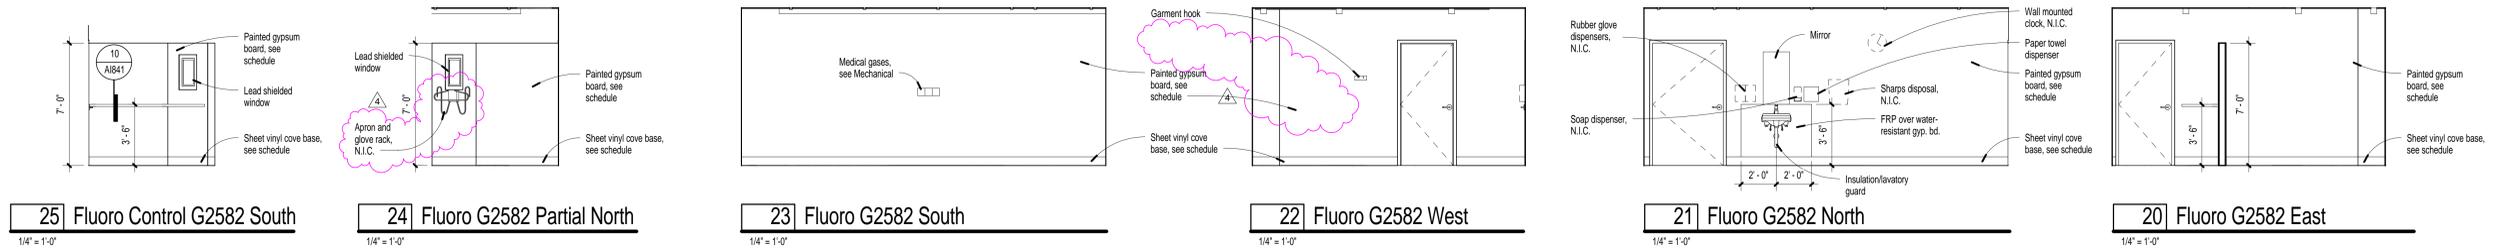

Number	Revision	Date
4	Revision 4	8/5/13

CONSULTANTS:



ARCHITECT/ENGINEERS:
H+K ARCHITECTS
 5485 Reno Corporate Drive, Suite 100
 Reno, Nevada 89511-2262
 P 775+332+6640
 F 775+332+6642
 hkarchitects.com



Drawings Title
Second Floor Phase 2 Interior Elevations
 Approved: Project Director


Project Title
 Remodel and Expansion of DICE Services
 Location
 975 Kirman Avenue, Reno, NV 89502
 Date
 4/4/2013
 Checked
 LM
 Drawn
 DG

Project Number
 654-777
 Building Number
 1D
 Drawing Number
A1829


Office of Construction and Facilities Management
 Department of Veterans Affairs

Bid Documents - Final


three inches = one foot.
 one and one half inches = one foot.
 one inch = one foot.
 three quarters inch = one foot.
 one half inch = one foot.
 three eighths inch = one foot.
 one quarter inch = one foot.
 one eighth inch = one foot.
 8/2013 10:28:09 AM CHH Local Project 0301030 VA DDC Local Dwg.rvt

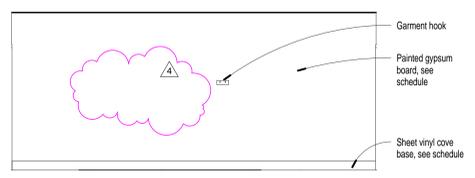


14 DR G2572 South
1/4" = 1'-0"

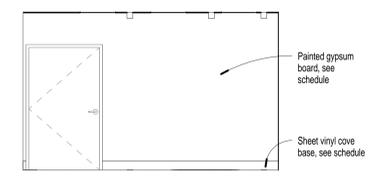


13 DR G2572 West
1/4" = 1'-0"

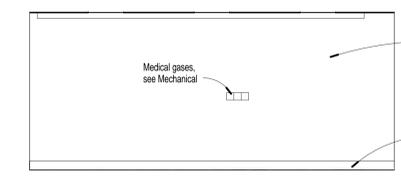


12 DR G2572 North
1/4" = 1'-0"

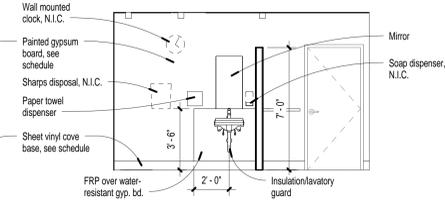


11 DR G2572 East
1/4" = 1'-0"

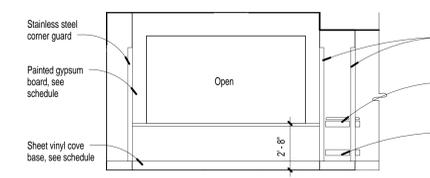


10 Corridor G2599 West at Door G2599
1/4" = 1'-0"

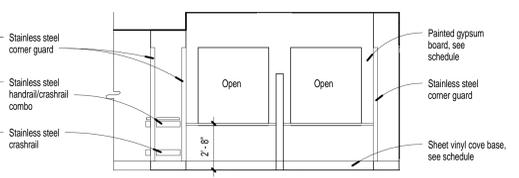


9 Corridor G2599 East at Door G2599
1/4" = 1'-0"

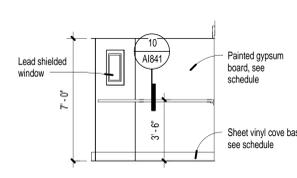


16 DR Control G2572 North
1/4" = 1'-0"

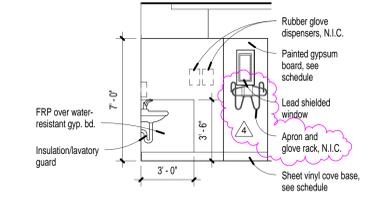


15 DR G2572 Partial South
1/4" = 1'-0"

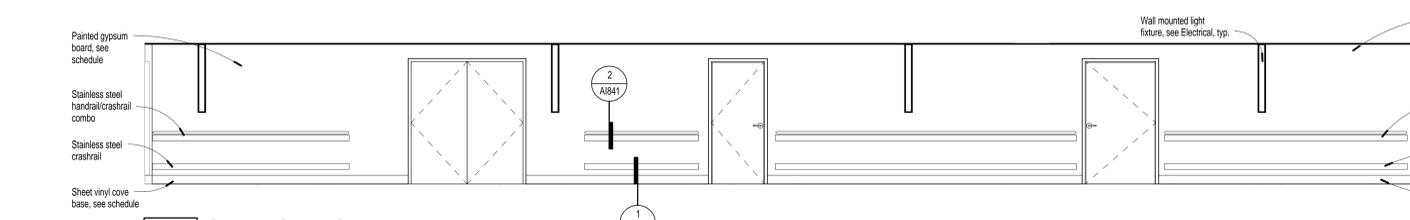


8 Corridor G2599 South
1/4" = 1'-0"

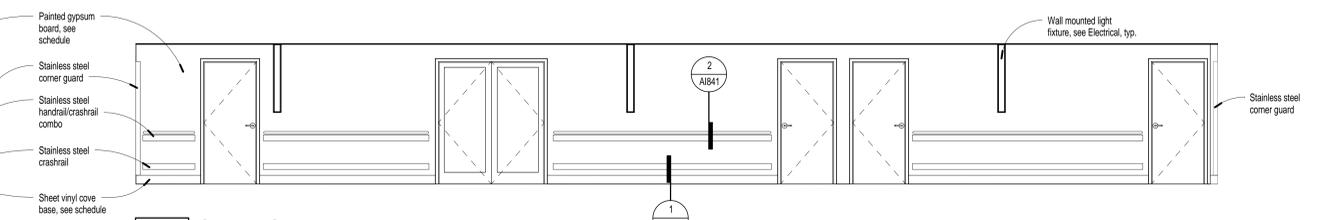


7 Corridor G2599 North
1/4" = 1'-0"

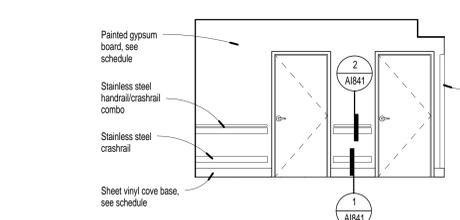


6 Corridor G2592 South
1/4" = 1'-0"

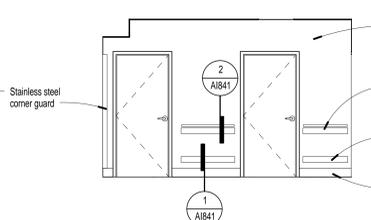


5 Corridor G2592 North
1/4" = 1'-0"

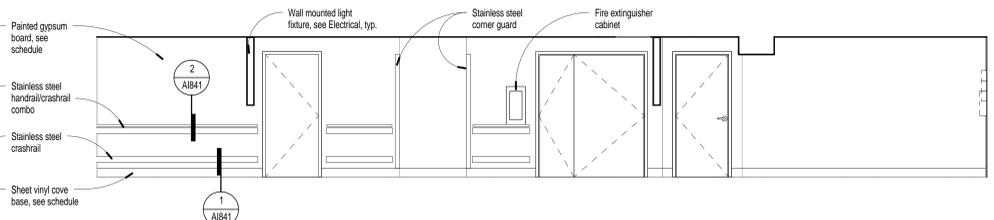


4 Corridor G2591 West (Phase 2)
1/4" = 1'-0"

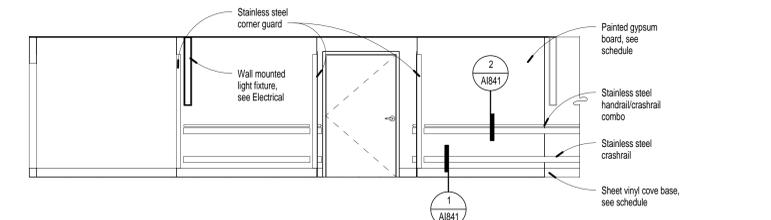


3 Corridor G2591 East (Phase 2)
1/4" = 1'-0"

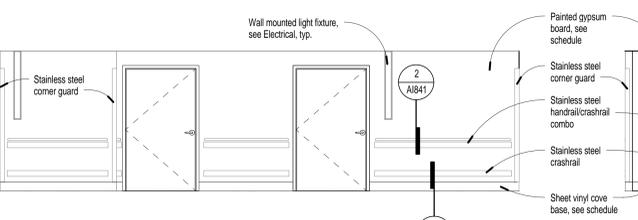

2 Corridor G2597 West (Phase 2)
1/4" = 1'-0"

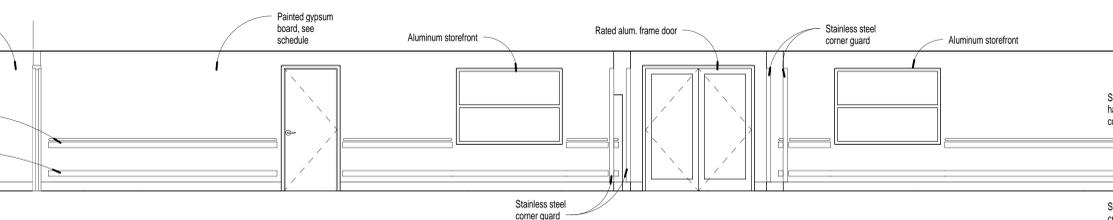

1 Corridor G2590 South
1/4" = 1'-0"

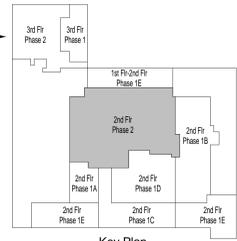

Key Plan

Number	Revision	Date
4	Revision 4	8/5/13

CONSULTANTS:



ARCHITECT/ENGINEERS:
H+K ARCHITECTS
 5485 Reno Corporate Drive, Suite 100
 Reno, Nevada 89511-2262
 P 775+332+6640
 F 775+332+6642
 hkarchitects.com



Drawings Title
Second Floor Phase 2 Interior Elevations
 Approved: Project Director

Project Title
 Remodel and Expansion of
 DICE Services
 Location
 975 Kirman Avenue, Reno, NV 89502
 Date
 4/4/2013
 Checked
 LM
 Drawn
 DG

Project Number
 654-777
 Building Number
 1D
 Drawing Number
A1830

Office of
 Construction
 and Facilities
 Management
 Department of
 Veterans Affairs

