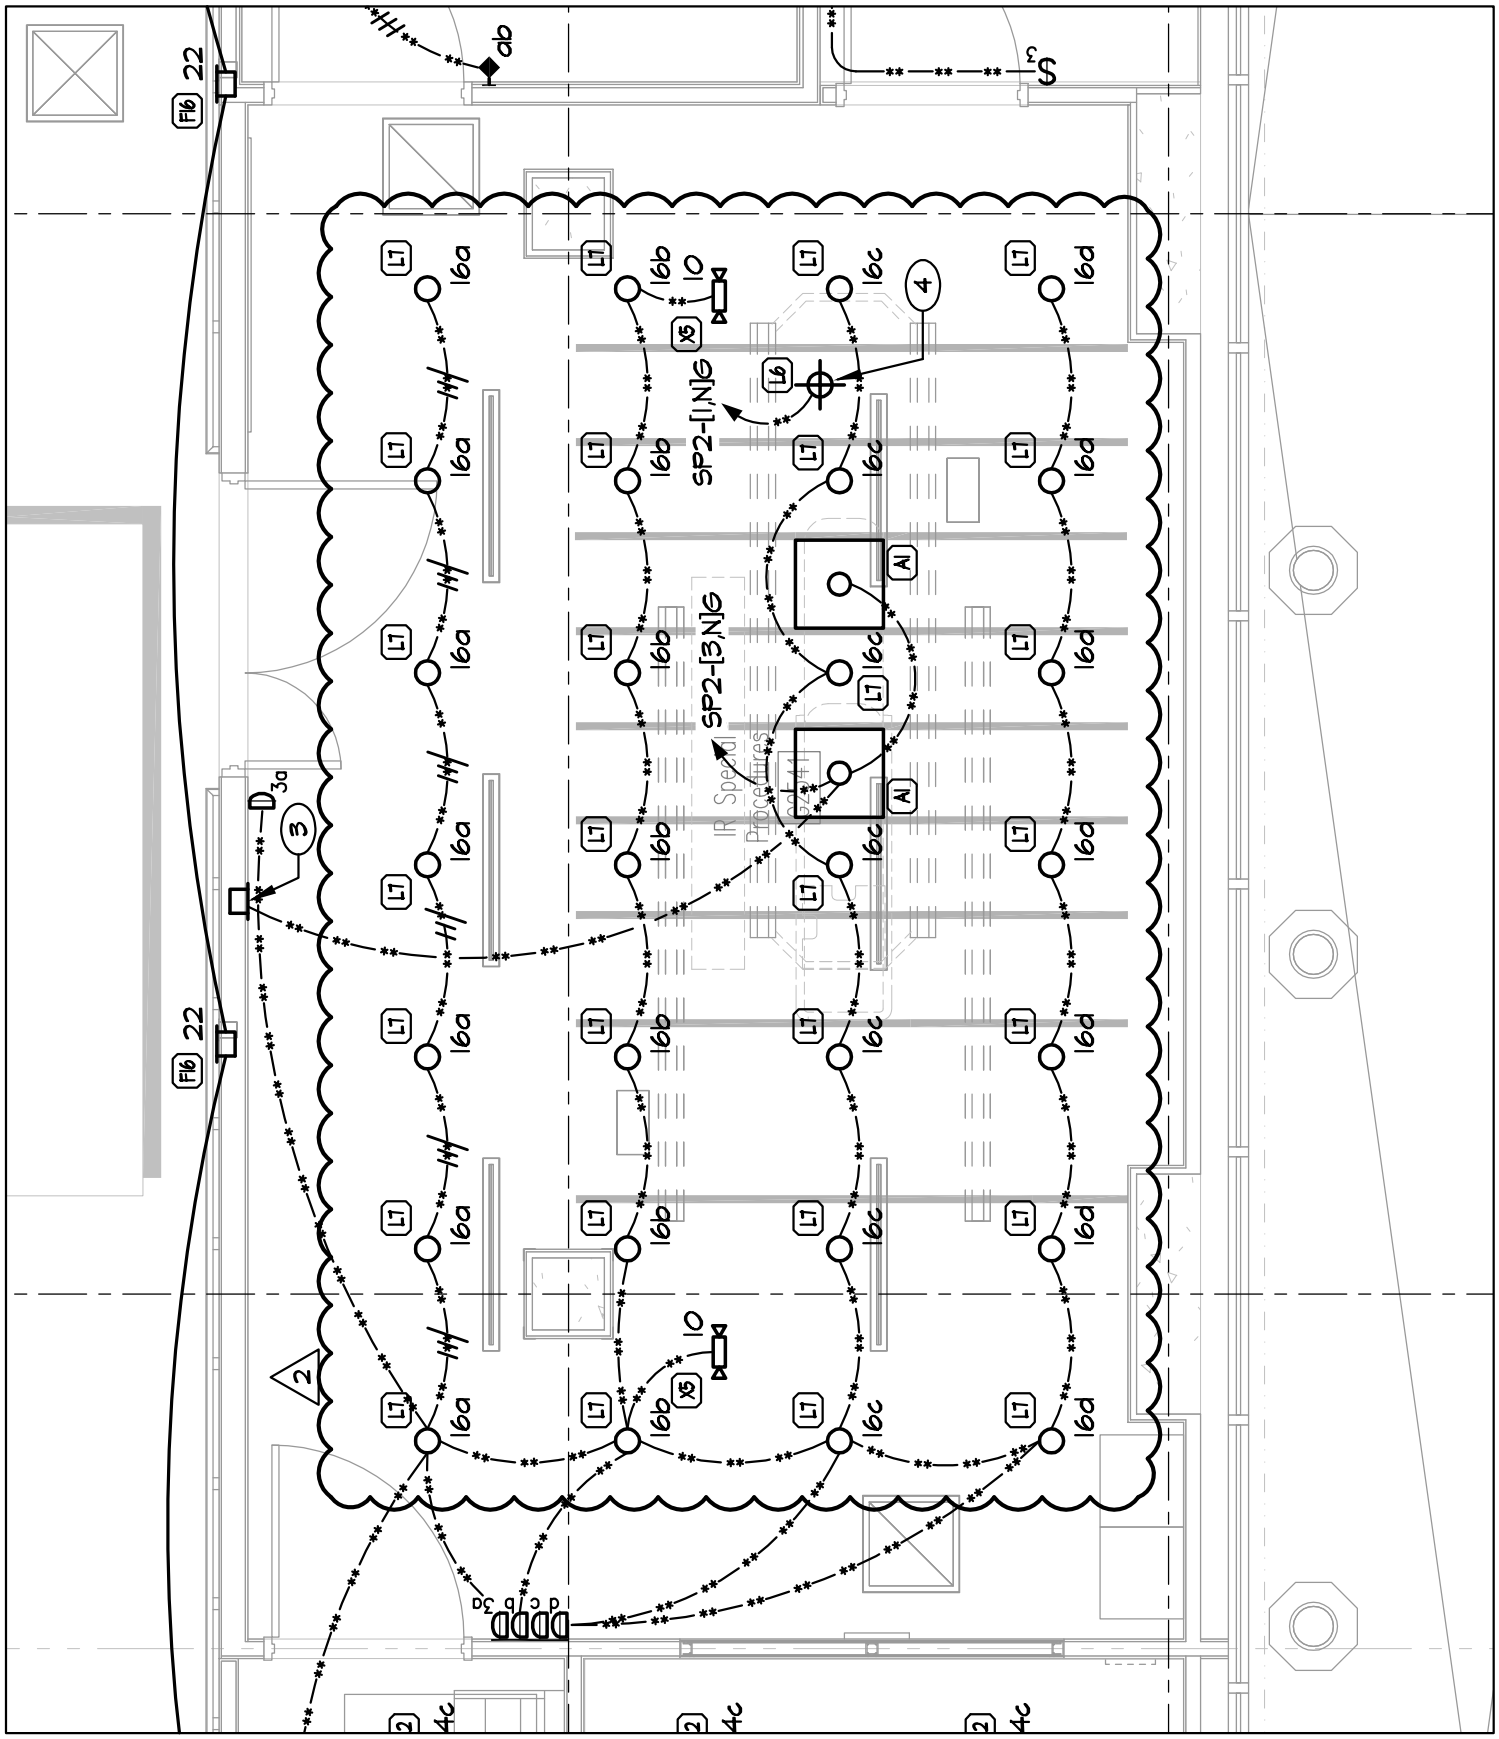

PK Electrical, Inc.	ISSUE: Addendum 2	REFERENCE: EL122	DATE: 7/27/13
	PROJECT: Remodel & Expansion of DICE		PROJECT No: 11022
	SHEET TITLE: Partial 2ND Floor Ph 1C & 1E Lighting		DWG No: A2.2