



A  
three inches = one foot  
1  
one and one half inches = one foot  
6  
2  
one inch = one foot  
6  
0  
three quarters inch = one foot  
6  
2  
one half inch = one foot  
6  
4  
three eighths inch = one foot  
6  
8  
one quarter inch = one foot  
6  
16  
one eighth inch = one foot  
6

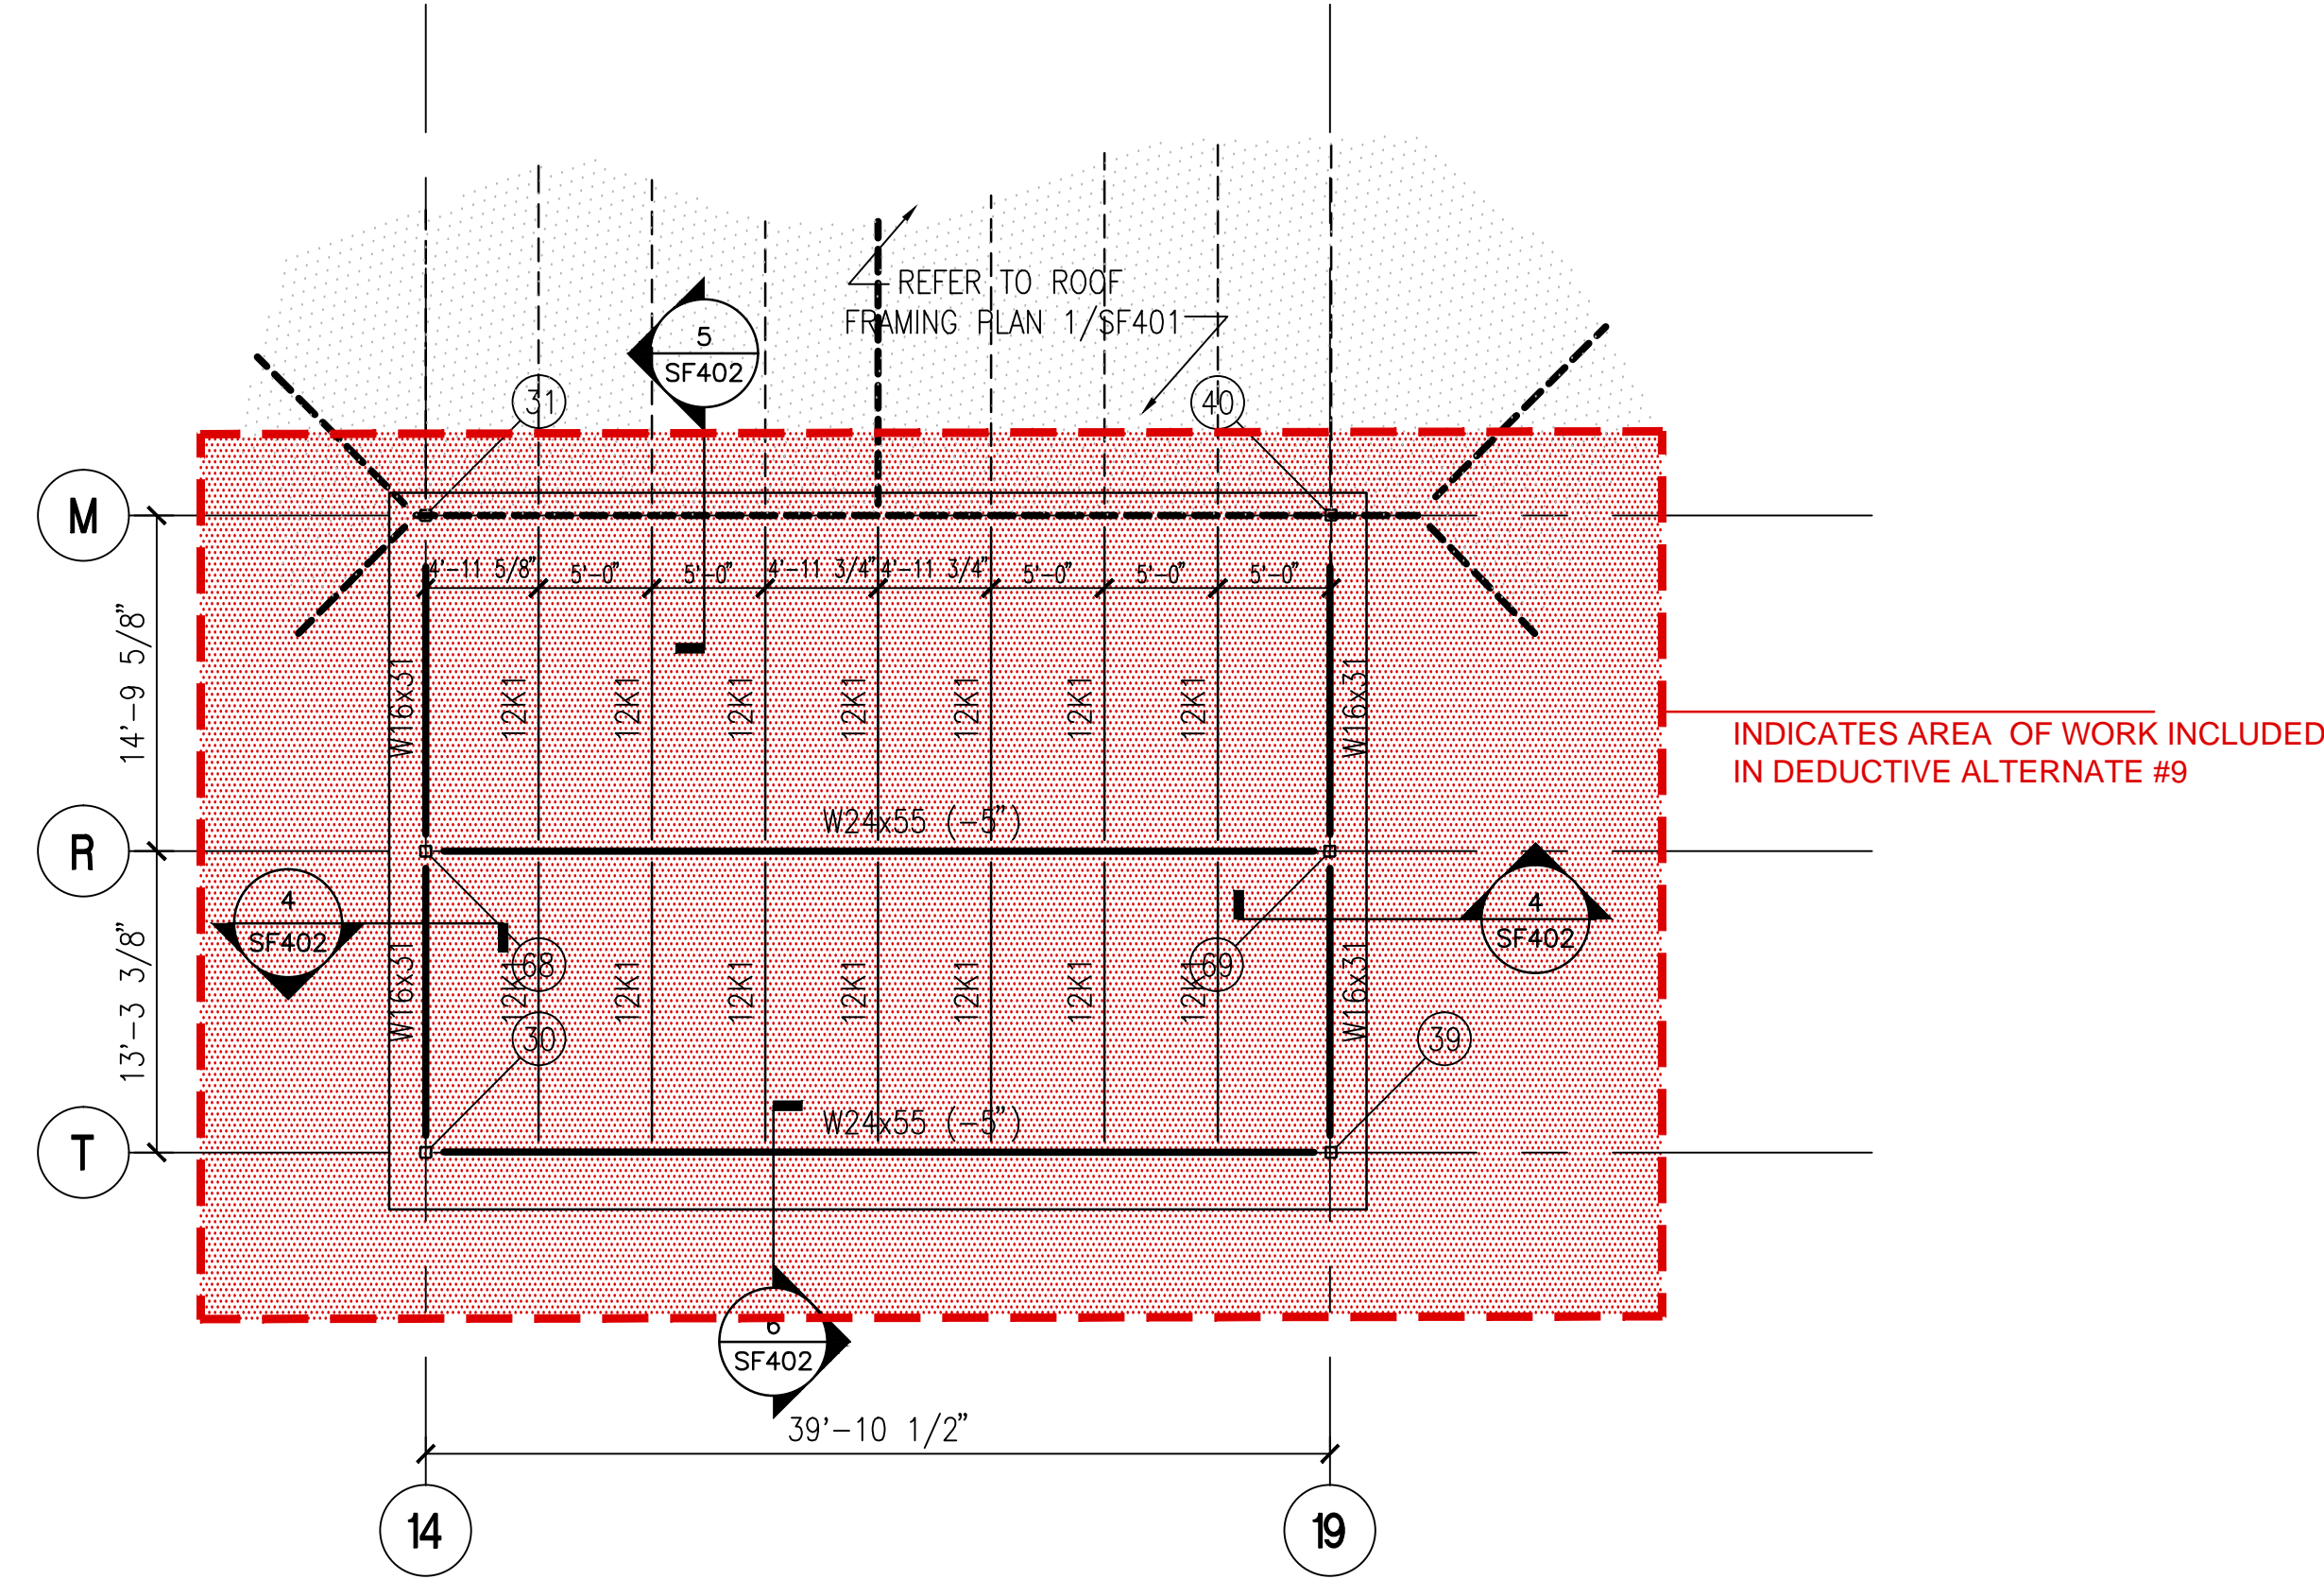

1 CLERESTORY ROOF FRAMING PLAN  
SCALE: 1/8"=1'-0"

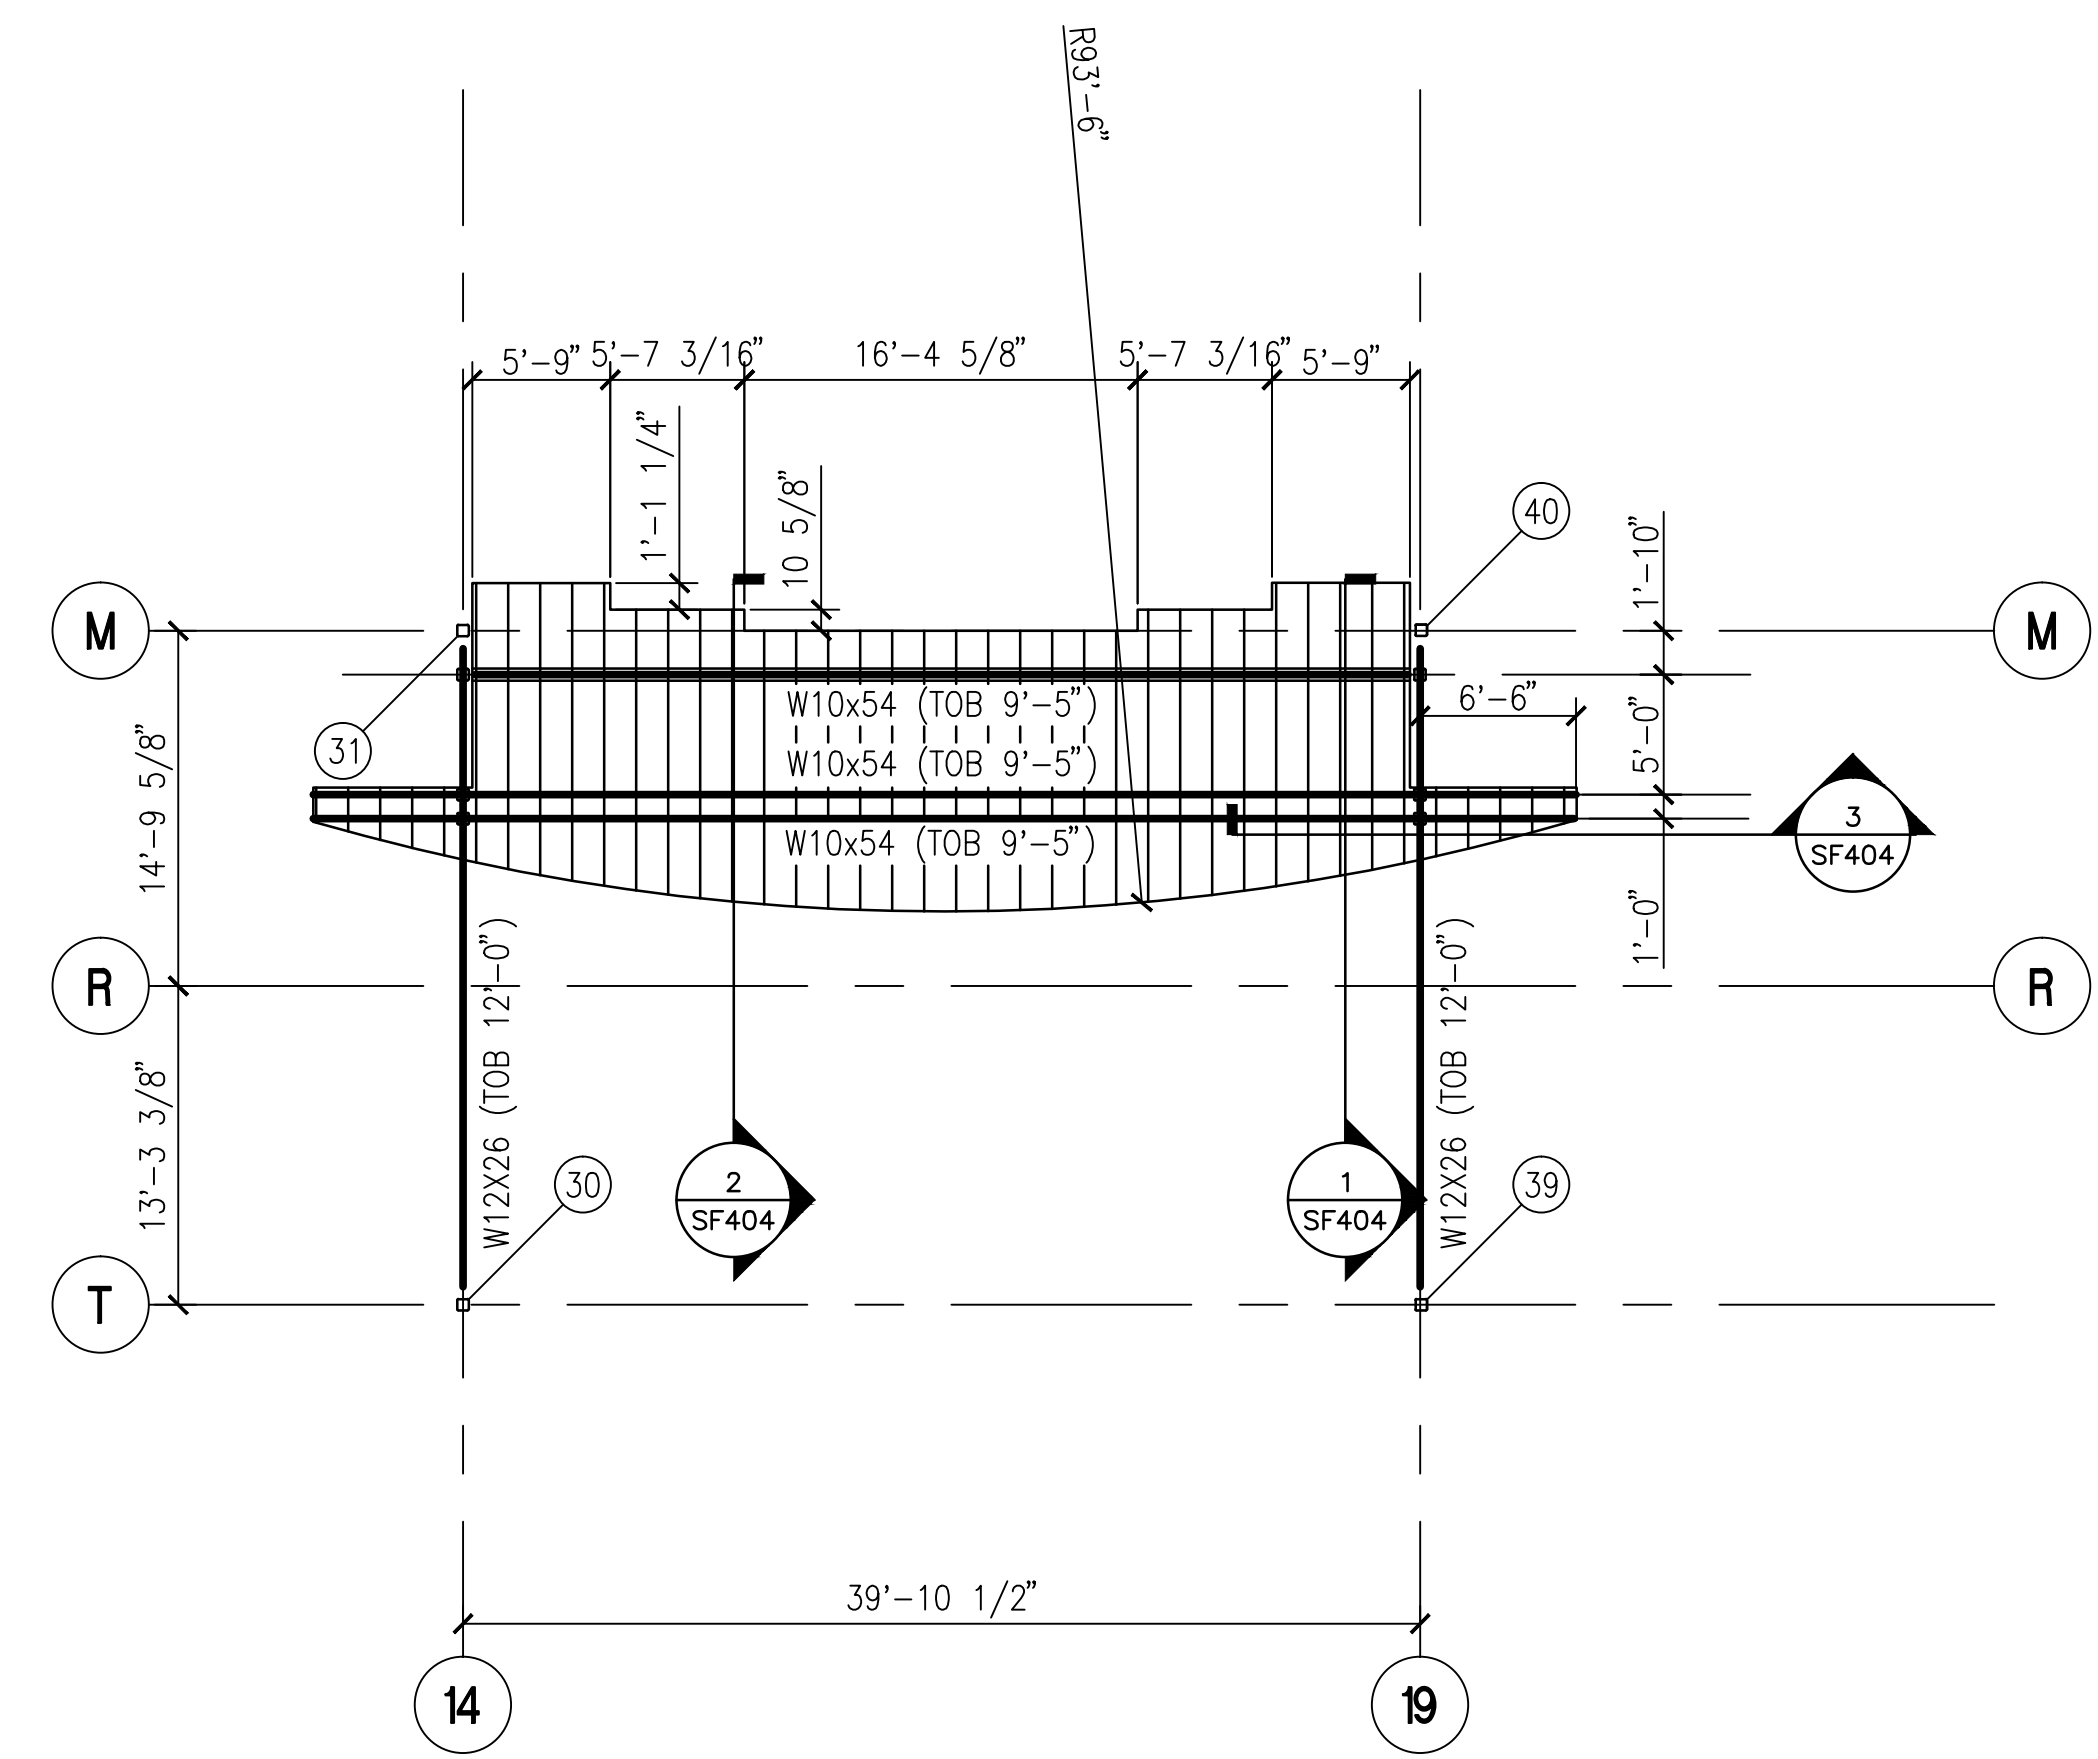


2 RECEPTION AREA CEILING FRAMING PLAN  
SCALE: 1/8"=1'-0"

CLERESTORY ROOF FRAMING PLAN NOTES:

1. TYPICAL ROOF FRAMING CONSISTS OF 1 1/2" X 22 ga TYPE B METAL ROOF DECK OVER STEEL JOISTS AND BEAMS. STRUCTURAL STEEL SYSTEM SHALL SLOPE TO FORM HIP AND CABLE ROOF.
2. TOP OF STEEL AT EACH COLUMN IS NOTED ON COLUMN SCHEDULE, SHEET SF600, THUS: T.O.S.
- TOP OF STEEL REFERS TO BOTTOM OF METAL DECK AND IS MEASURED FROM DATUM 0'-0".
3. STEEL BEAMS PLACED BELOW TOP OF STEEL SUPPORT COLUMNS ARE NOTED THUS: (-X").
4. TOP OF STEEL BEAMS LOCATED BELOW MAIN ROOF FRAMING ARE NOTED THUS: TOB = X'-X" AND MEASURED FROM DATUM 0'-0".

RECEPTION AREA CEILING FRAMING PLAN NOTES:

1. TYPICAL CEILING FRAMING CONSISTS OF 3/4" WOOD STRUCTURAL PANELS OVER COLD FORMED STEEL JOISTS AND BEAMS.
2. ALL FRAMING IS DESIGNED TO SUPPORT THE FOLLOWING LOADS:  
LIVE LOAD: 20 PSF  
DEAD LOAD: 5 PSF + SELF WEIGHT
3. TOP OF STEEL BEAMS ARE NOTED THUS: TOB = X'-X" AND MEASURED FROM DATUM 0'-0".

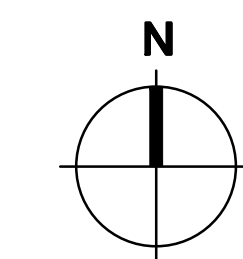

GRAPHIC SCALE  
5' 0' 5' 15' 20'  
1/8"=1'-0"  
SCALE IN FEET

--	--	