



SUPPLY PLAN
SCALE: 1/8" = 1'-0"

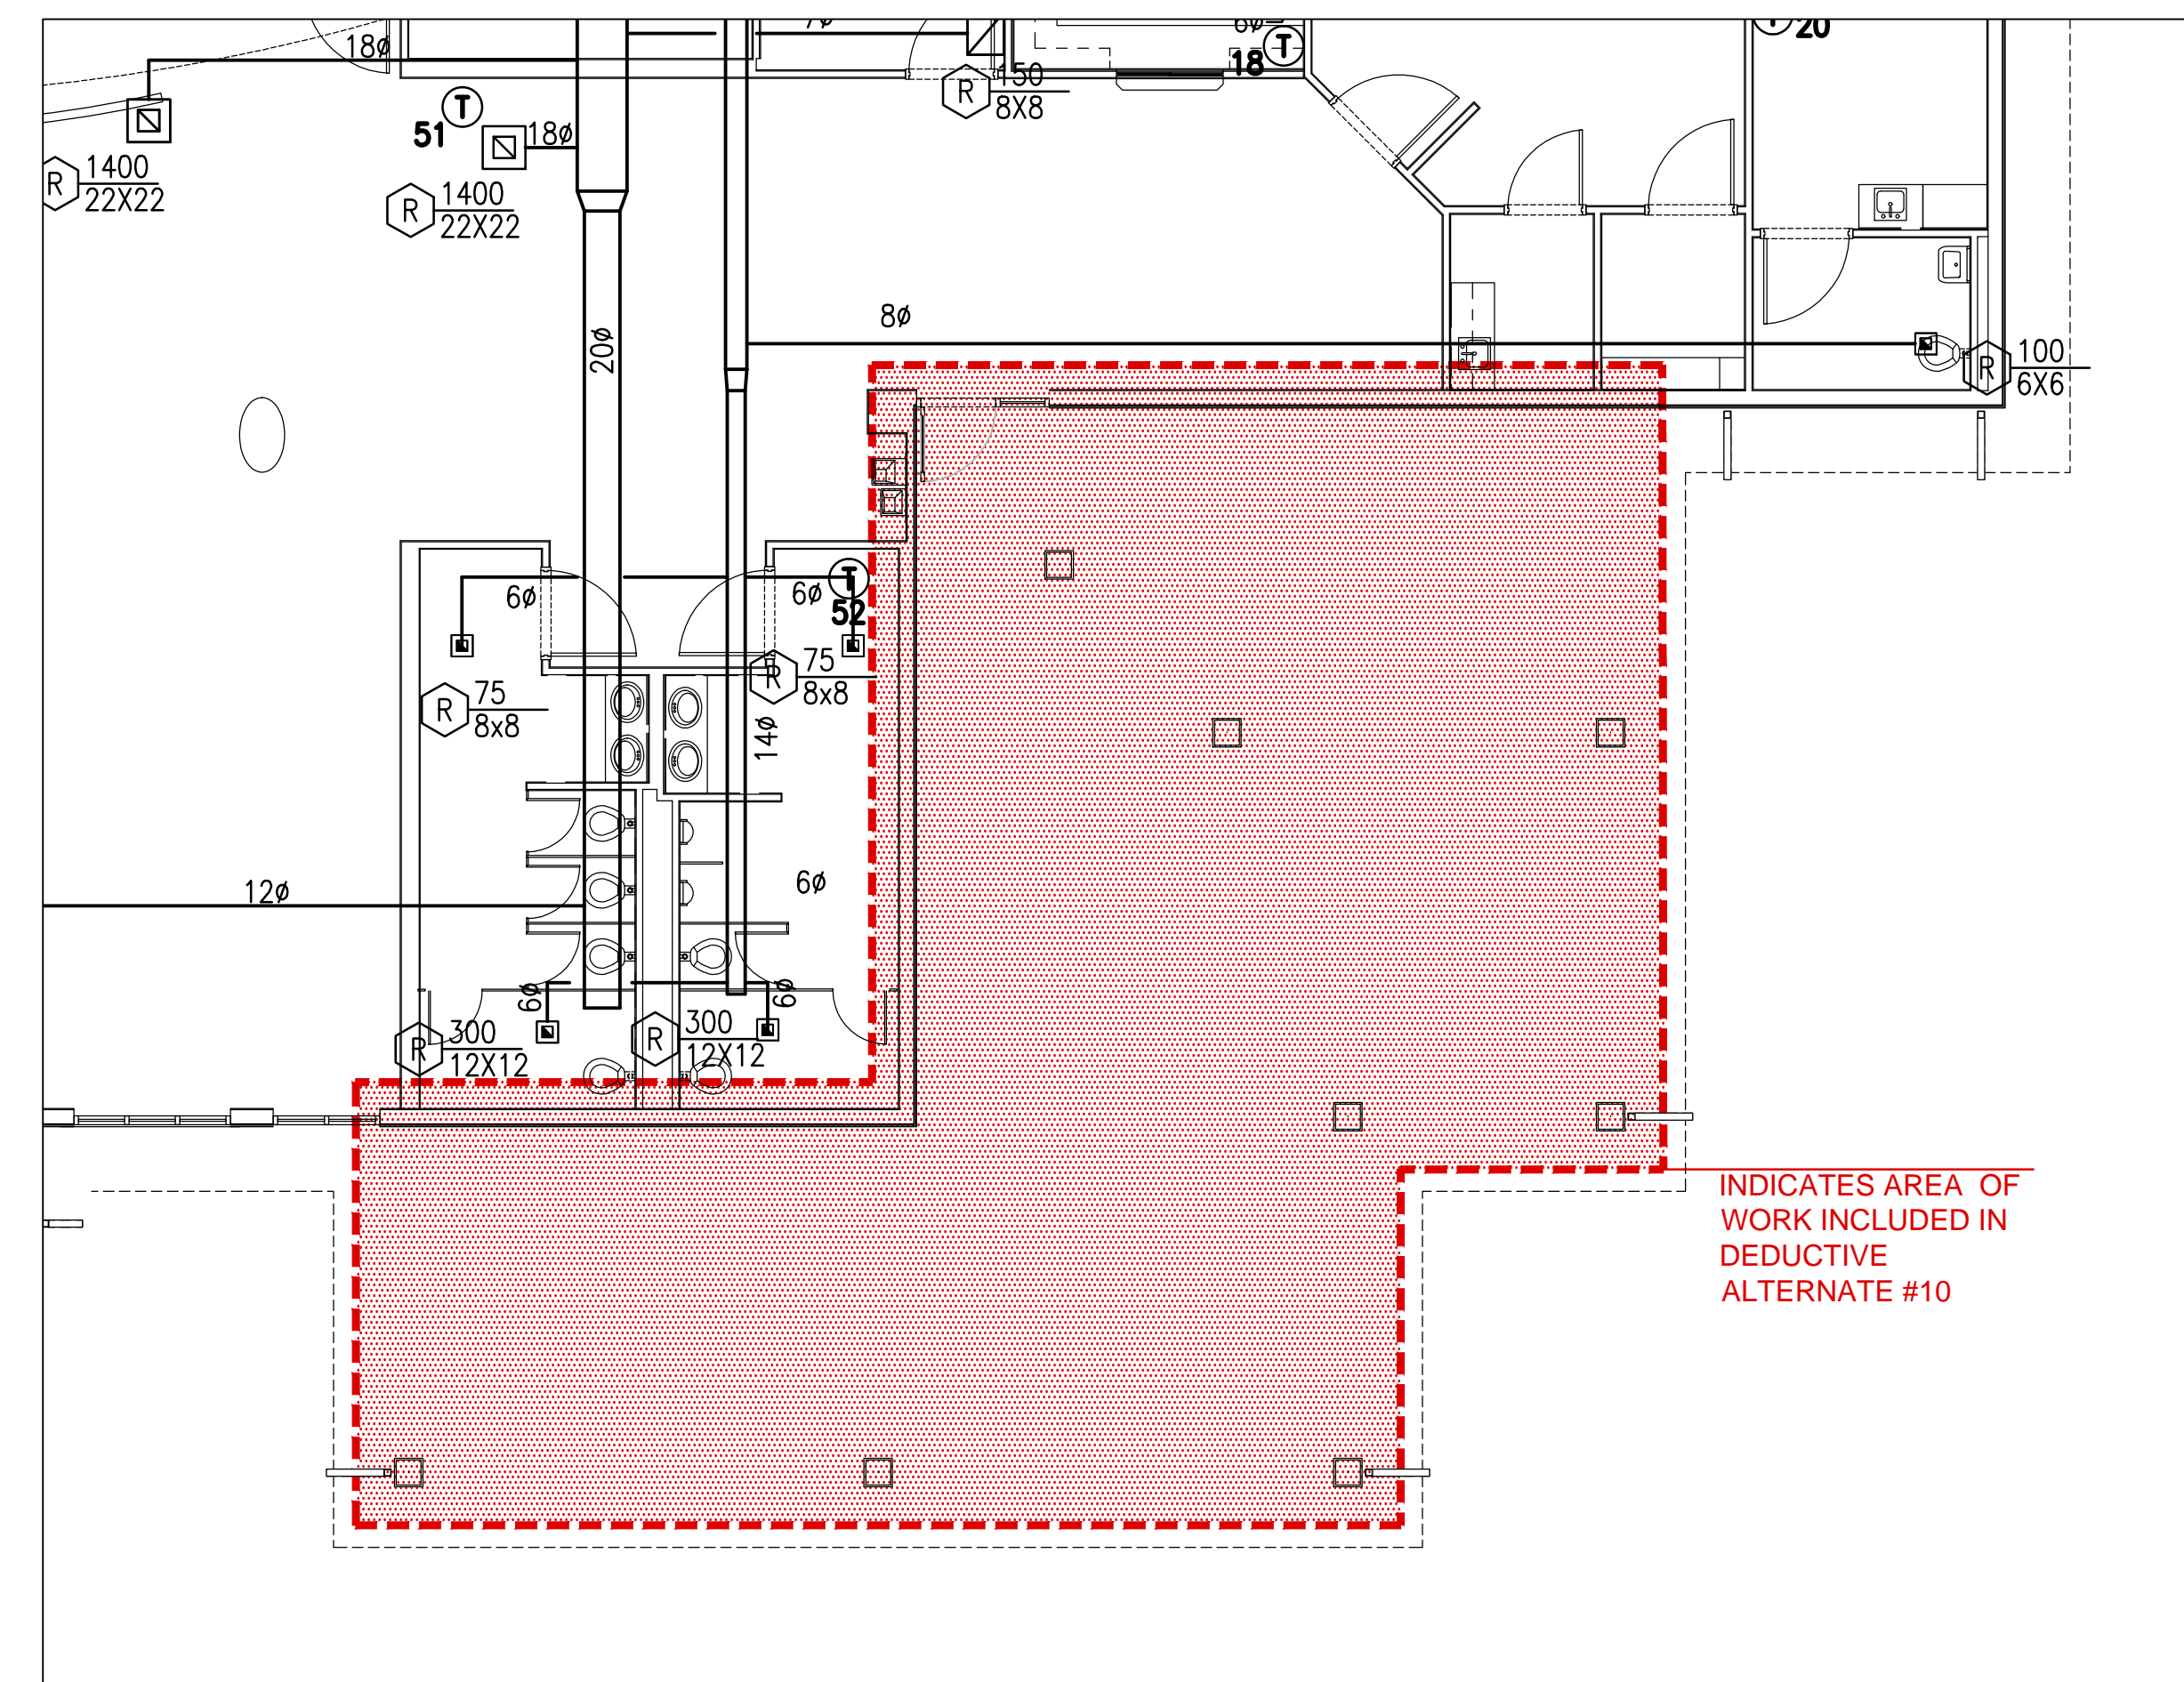

RETURN/EXHAUST PLAN


- NOTES:

1. SHEET MH001A110 IS FOR DEDUCTIVE ALTERNATE #10 WHICH REPLACES ADMIN AREAS WITH A COVERED PORCH.
2. AHU SUPPLY SUPPLY PLENUM SHALL BE FITTED WITH MERV 14 AIR FILTER SYSTEM.
3. ABOVE CEILING SPACES ARE DESIGNED TO PROVIDE AMPLE SPACE FOR DUCTWORK AND PIPING. HVAC CONTRACTOR TO COORDINATE DUCT AND PIPING LOCATIONS WITH OTHER TRADES.
4. ALL HOT WATER VALVES ARE TO BE 2 WAY EXCEPT 3-WAY FOR VAV-3, 20, 33, 44, 48.

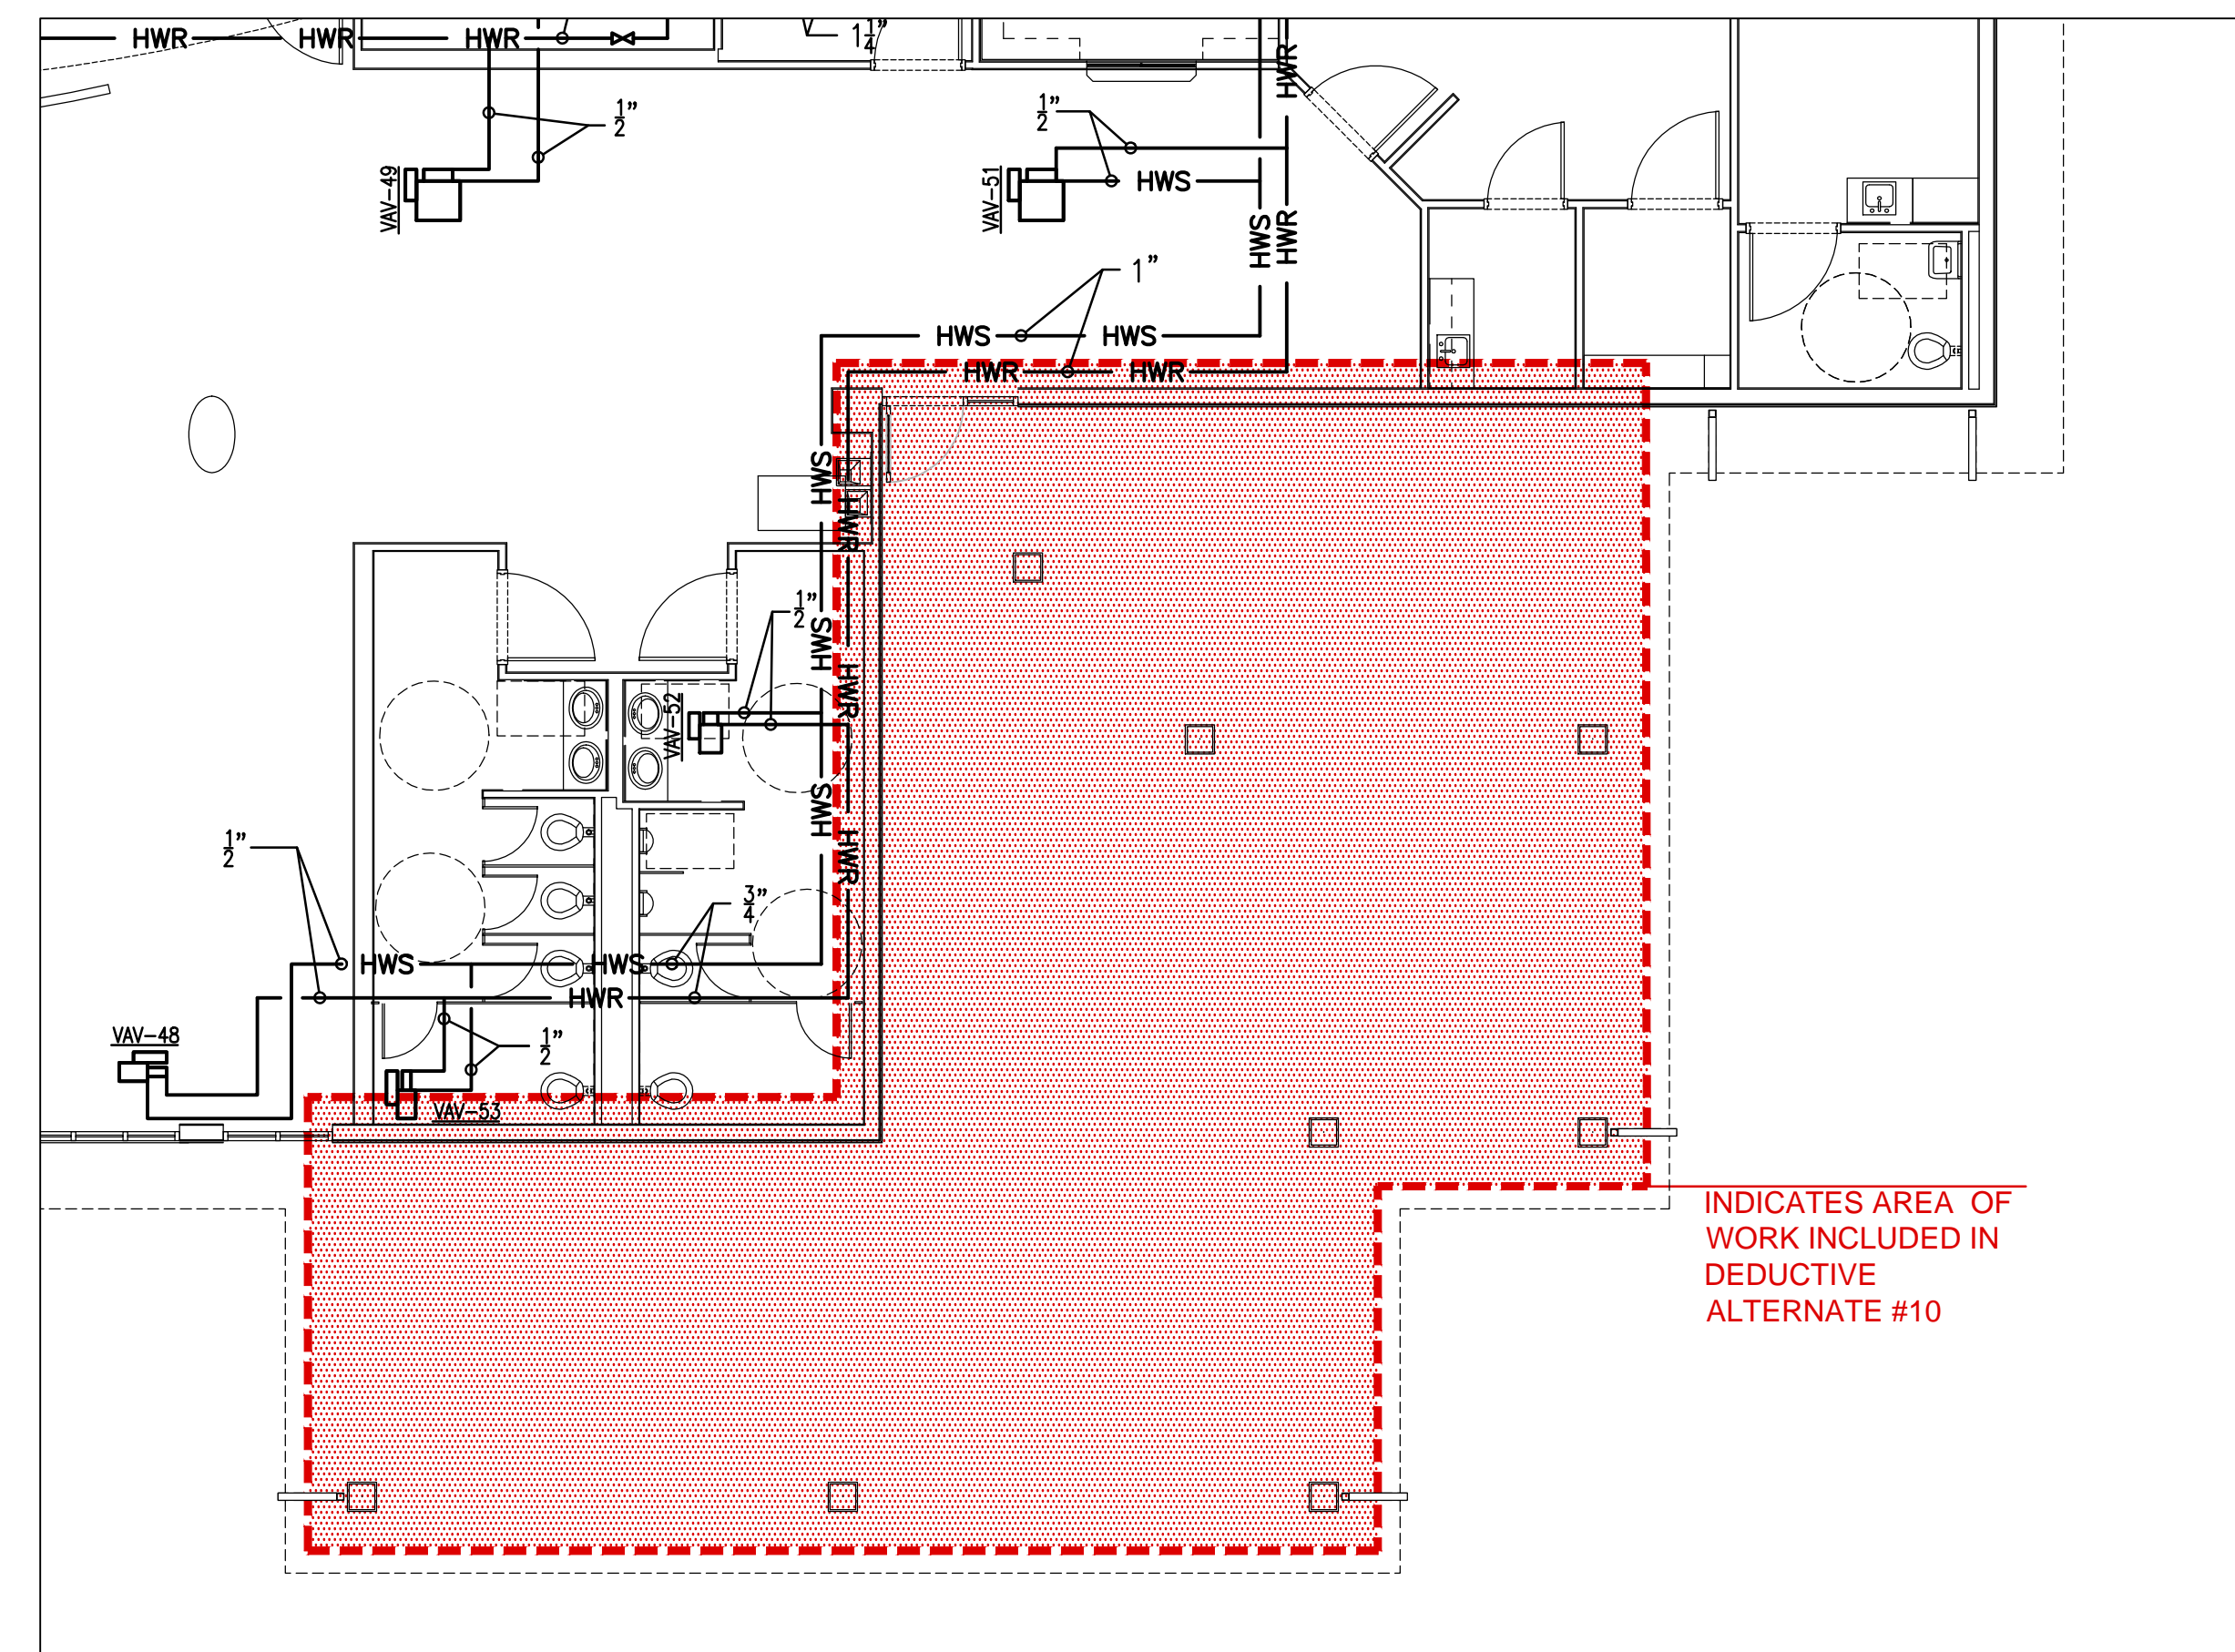

HYDRONIC PLAN

SCALE: 1/8" = 1'-0"

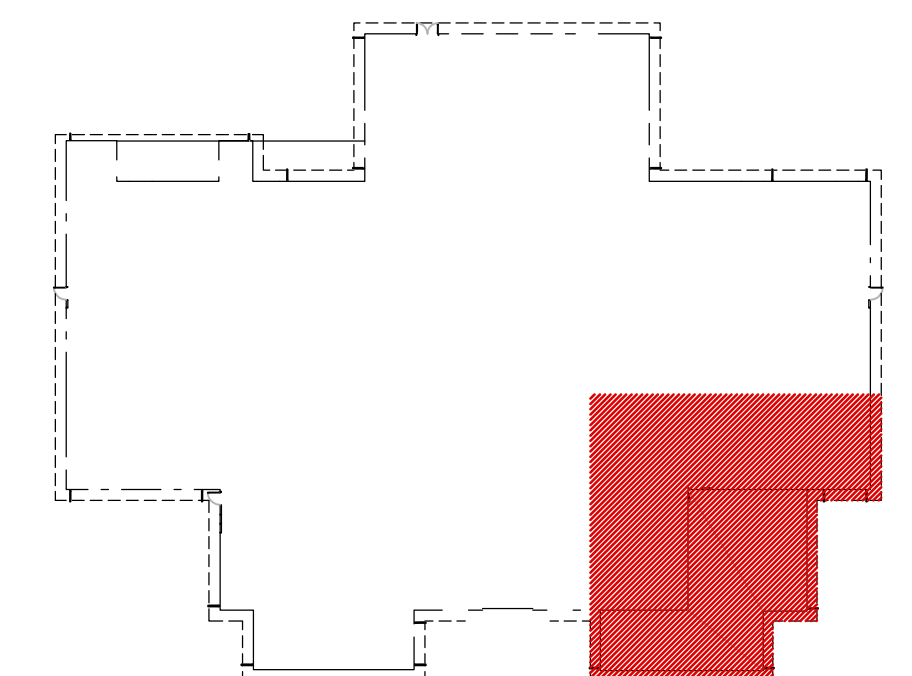

KEY PLAN

[illegible]