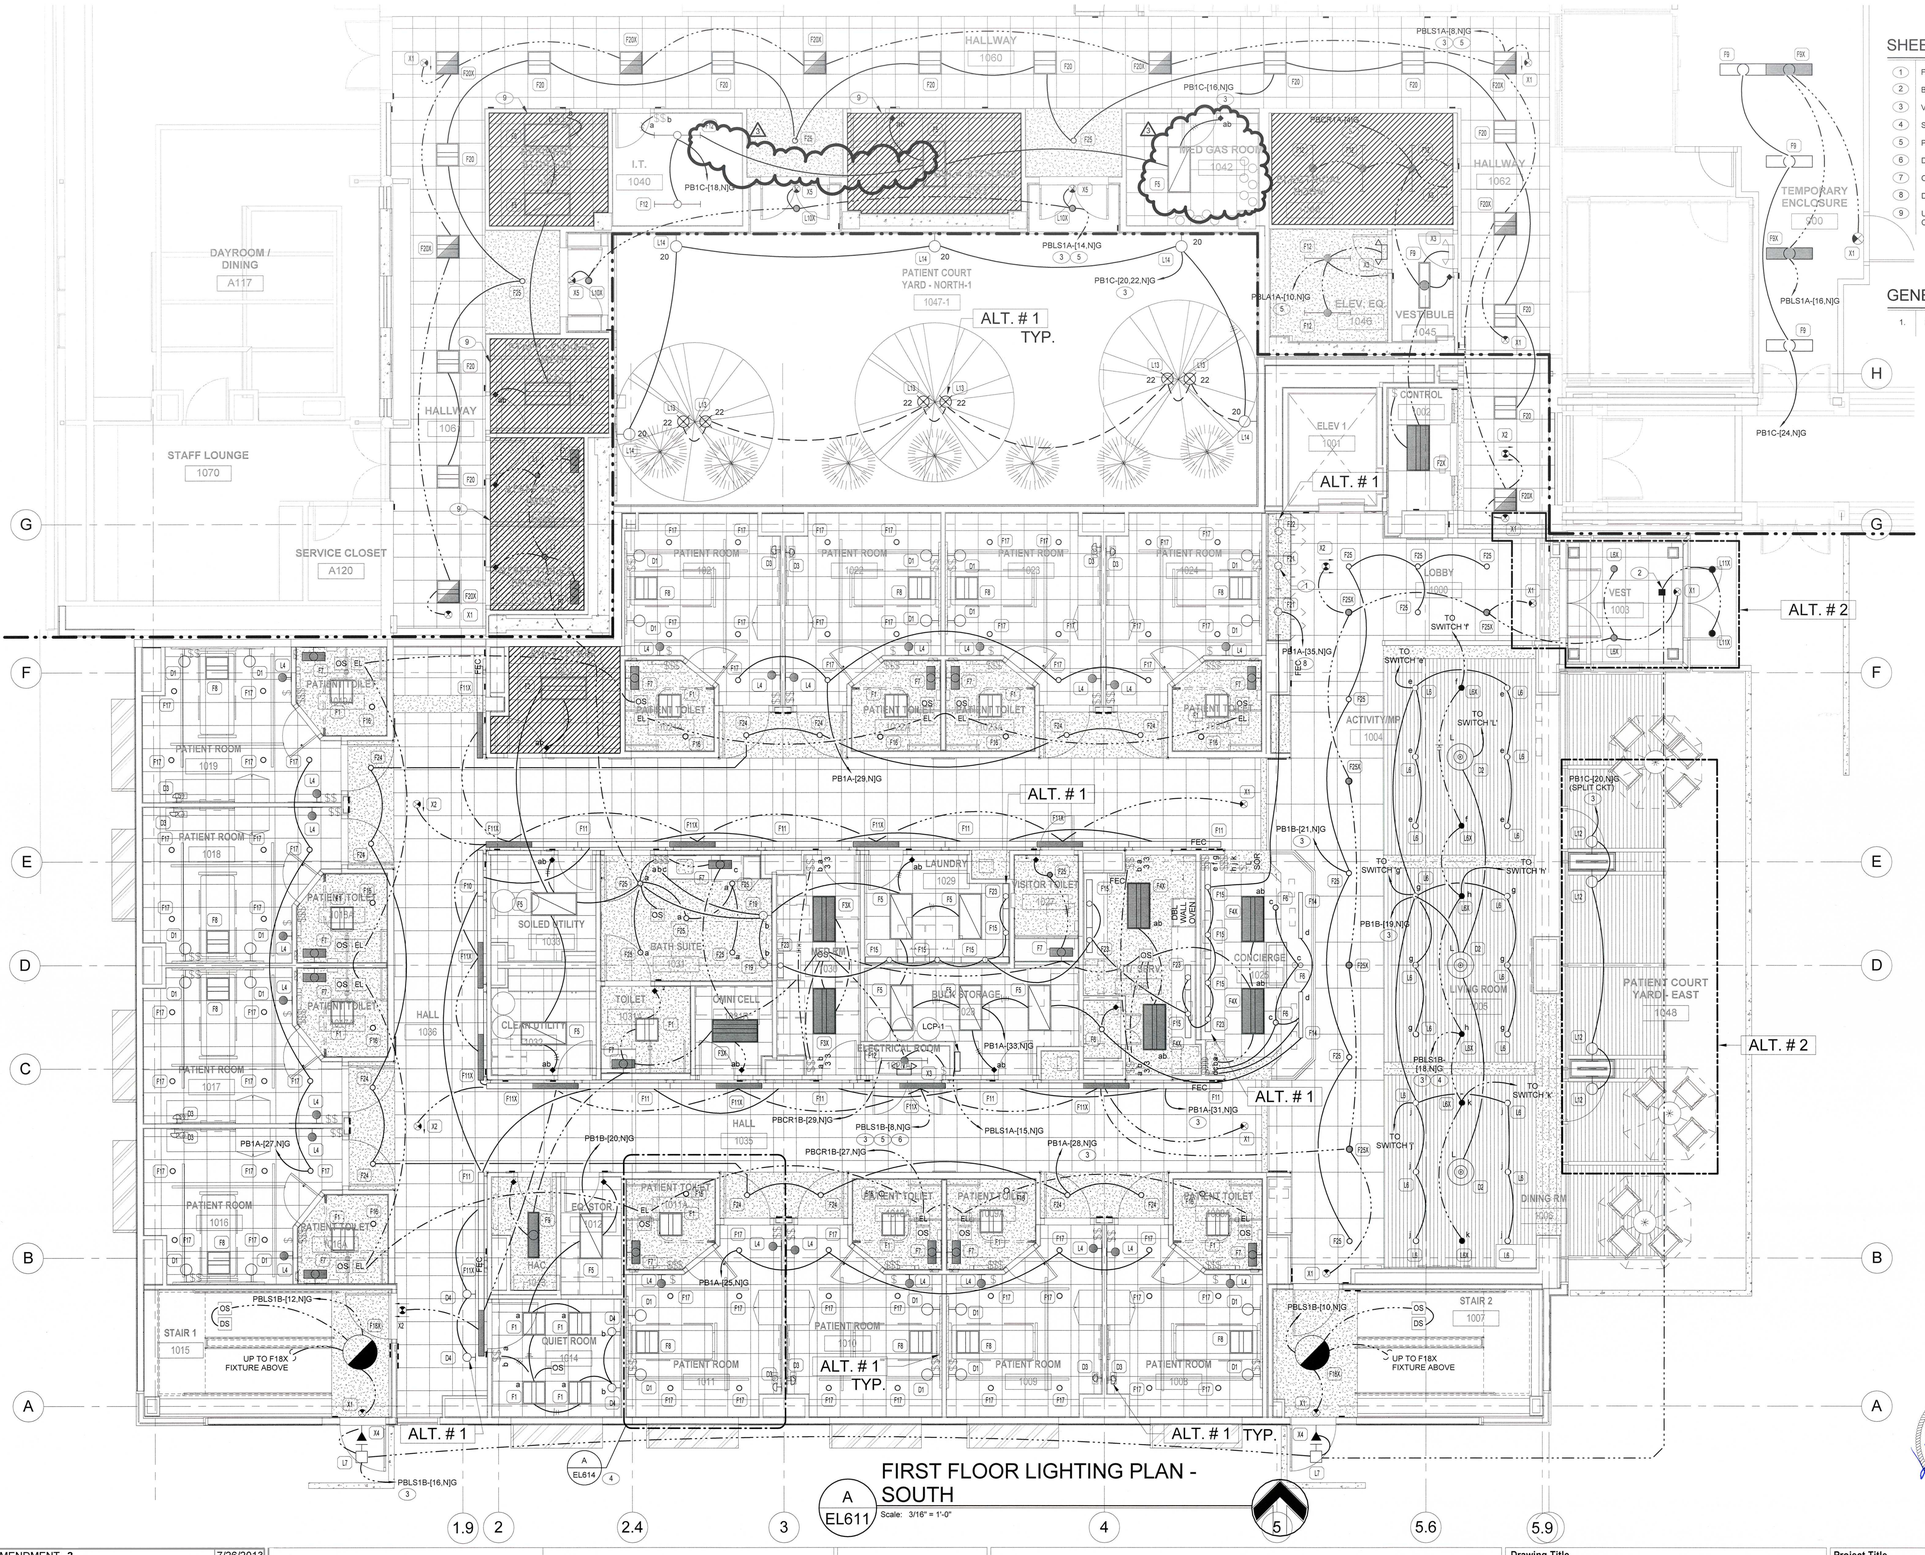

SHEET NOTES

1. FIXTURES MOUNTED IN DISPLAY CASE. SEE ARCHITECTURAL DETAILS.
2. BODINE EL1-100-SD EMERGENCY LIGHTING INVERTER. MOUNT ABOVE CEILING ON INTERIOR OF BUILDING.
3. VIA LCP-1.
4. SEE A/EL614 FOR CIRCUITING IN PATIENT ROOMS AND PATIENT BATHROOMS.
5. PROVIDE EXTRA "HOT" TO ENERGIZE EMERGENCY BATTERY PACKS.
6. DUAL RELAY FOR 2-LEVEL LIGHTING.
7. OVERRIDE SWITCH FOR FIRST FLOOR COORIDOR.
8. DISPLAY CASE LIGHTING VIA LCP-1. UNDERCABINET LIGHTING VIA LOCAL SWITCH.
9. UNDER BASE BID PROVIDE (1) TYPE F26 FIXTURE AND WALL MOUNTED OCCUPANCY SENSOR SWITCH. CONNECT TO CIRCUIT SHOWN IN ROOM.

GENERAL NOTES

1. FOR EXTERIOR WALL MOUNTED LIGHT FIXTURES SEE ARCHITECTURAL PLANS FOR MOUNTING HEIGHT.

MODIFIED WORK SCOPE

FIRST FLOOR LIGHTING PLAN - SOUTH

A EL611

Scale: 3/16" = 1'-0"

PK Electrical, Inc.
681 Sierra Rose Dr., Ste. B • Reno, Nevada 89511
p. 775.826.9010 • f. 775.826.9030 • pkelectrical.com
10165

FULLY SPRINKLED

3	AMENDMENT 3	7/26/2013

Consultants

COLLABORATIVE DESIGN STUDIO architecture of experience and place
www.collaborativedesignstudio.com
T 775.348.7777 F 775.348.0904
9444 DOUBLE R BLVD SUITE B | RENO NV 89521

Reviewing Agency - Fire Protection

AON
Fire Protection Engineering
Aon Fire Protection Engineering Corporation
11770 Bernardo Plaza Court | Suite 116 | San Diego, CA 92128
t +1.858.673.5845 | f + 1.858.673.5849 | www.aonfpe.com
Fire Protection | Code | Risk | Life Safety | Security

LICENSED ARCHITECT ARTHUR E. BORDER 4598 STATE OF NEVADA 12/31/2013

Architects/Engineers

RBB ARCHITECTS INC
10980 Wilshire Boulevard
Los Angeles, California
90024-3905
Telephone 310 473 3555
Facsimile 310 473 3555
www.rbbinc.com

917 7th St. 2nd Floor Ste. 3
Sacramento, California
95814
Telephone 310 473 3555
Facsimile 310 473 3555
www.rbbinc.com

RBB

Drawing Title
First Floor Lighting - South

Scale
3/16" = 1'-0"

Approved Project Director

Project Title
VA RENO HEALTHCARE SYSTEM COMMUNITY LIVING CENTER EXPANSION

Project No. #1017200
VA Contract No. VA261-P-0933

Location
975 KIRMAN AVE., RENO, NEVADA 89502

Date	Checked	Drawn
04/15/2013	KDP	TPT

VA Project No. 654-317
Building No.
Drawing No. EL611

Office of Construction and Facilities Management
Department of Veteran Affairs

BID DOCUMENTS