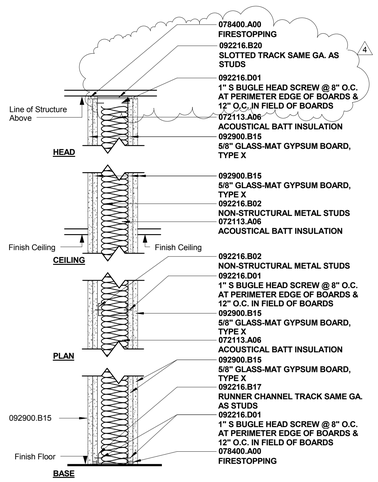

FB-120
C400-I

PARTITION TYPE
WALL TAG AS SHOWN ON PLANS

18 GA. STL. STUDS @ 16" O.C.
SEE SCHEDULE FOR STUD SIZE
SLOTTED TRACK SAME GA. AS STUDS
RUNNER CHANNEL TRACK SAME GA. AS STUDS

FB-120-C400-I | 1 1/2" = 1'-0" | 9

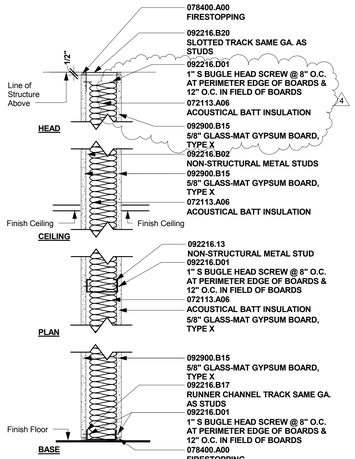

FB-60
C400-I

PARTITION TYPE
WALL TAG AS SHOWN ON PLANS

18 GA. STL. STUDS @ 16" O.C.
SEE SCHEDULE FOR STUD SIZE
SLOTTED TRACK SAME GA. AS STUDS
RUNNER CHANNEL TRACK SAME GA. AS STUDS

FB-60-C400-I | 1 1/2" = 1'-0" | 7

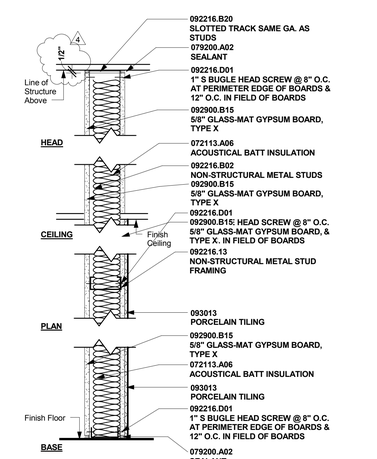

IP-0
C400-IZ

PARTITION TYPE
WALL TAG AS SHOWN ON PLANS

18 GA. STL. STUDS @ 16" O.C.
SEE SCHEDULE FOR STUD SIZE
SLOTTED TRACK SAME GA. AS STUDS
RUNNER CHANNEL TRACK SAME GA. AS STUDS

IP-0-C400-IZ | 1 1/2" = 1'-0" | 5

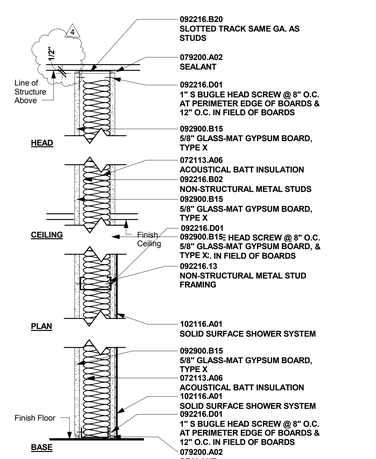

IP-0
C400-IE

PARTITION TYPE
WALL TAG AS SHOWN ON PLANS

18 GA. STL. STUDS @ 16" O.C.
SEE SCHEDULE FOR STUD SIZE
SLOTTED TRACK SAME GA. AS STUDS
RUNNER CHANNEL TRACK SAME GA. AS STUDS

IP-0-C400-IE | 1 1/2" = 1'-0" | 3

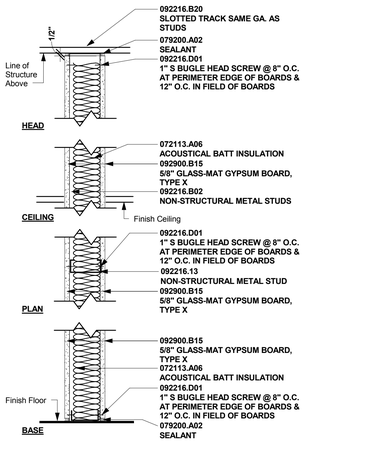

IP-0
C400-I

PARTITION TYPE
WALL TAG AS SHOWN ON PLANS

18 GA. STL. STUDS @ 16" O.C.
SEE SCHEDULE FOR STUD SIZE
SLOTTED TRACK SAME GA. AS STUDS
RUNNER CHANNEL TRACK SAME GA. AS STUDS

IP-0-C400-I | 1 1/2" = 1'-0" | 1

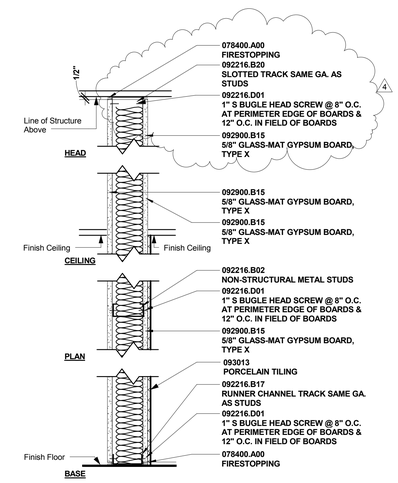

FB-60
C400-IZ

PARTITION TYPE
WALL TAG AS SHOWN ON PLANS

18 GA. STL. STUDS @ 16" O.C.
SEE SCHEDULE FOR STUD SIZE
SLOTTED TRACK SAME GA. AS STUDS
RUNNER CHANNEL TRACK SAME GA. AS STUDS

FB-60-C400-IZ | 1 1/2" = 1'-0" | 8

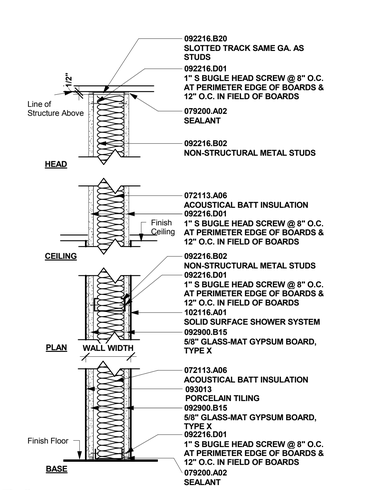

IP-0
C400-IZ3

PARTITION TYPE
WALL TAG AS SHOWN ON PLANS

18 GA. STL. STUDS @ 16" O.C.
SEE SCHEDULE FOR STUD SIZE
SLOTTED TRACK SAME GA. AS STUDS
RUNNER CHANNEL TRACK SAME GA. AS STUDS

IP-0-C400-IZ3 | 1 1/2" = 1'-0" | 6

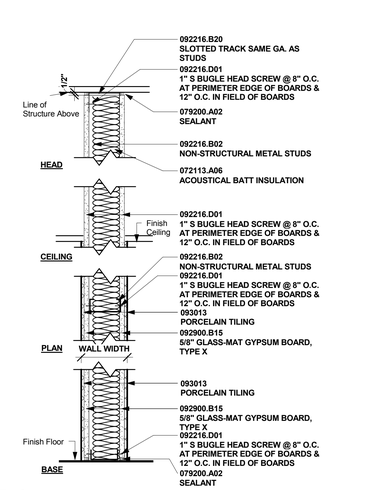

IP-0
C400-IZ2

PARTITION TYPE
WALL TAG AS SHOWN ON PLANS

18 GA. STL. STUDS @ 16" O.C.
SEE SCHEDULE FOR STUD SIZE
SLOTTED TRACK SAME GA. AS STUDS
RUNNER CHANNEL TRACK SAME GA. AS STUDS

IP-0-C400-IZ2 | 1 1/2" = 1'-0" | 4

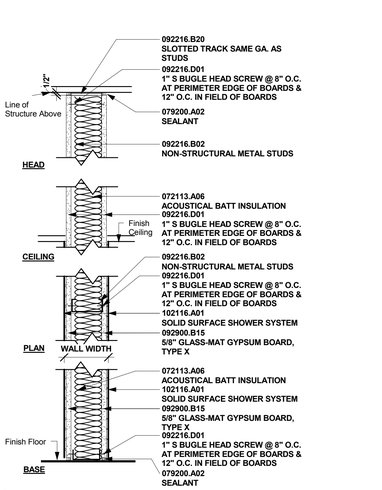

IP-0
C400-IF

PARTITION TYPE
WALL TAG AS SHOWN ON PLANS

18 GA. STL. STUDS @ 16" O.C.
SEE SCHEDULE FOR STUD SIZE
SLOTTED TRACK SAME GA. AS STUDS
RUNNER CHANNEL TRACK SAME GA. AS STUDS

IP-0-C400-IF | 1 1/2" = 1'-0" | 2

Wall Schedule

Name	CBC Nomenclature	IBC Reference	Type	Rating	Construction	Stud Size	Thickness	Height	UL
FB-60 C400-I	Fire Barrier	706	EA	60	C	400	5 1/4"	FULL HT.	U465
FB-60 C400-Z	Fire Partition	706	FB	60	C	400	5 5/8"	FULL HT.	U465
FB-60 CH400	Fire Barrier		FB	60	CH	400	4 5/8"	FULL HT.	U415
FB-120 C400	Fire Barrier	706	FB	120	C	400	6 1/2"	FULL HT.	U411
FB-120 C400-Z	Fire Barrier	706	FB	120	C	400	6 7/8"	FULL HT.	U411
FB-120 CH400	Fire Barrier	706	FB	120	CH	400	5"	FULL HT.	U438
FB-120 CH600	Fire Barrier	706	FB	120	CH	600	7"	FULL HT.	U438
FP-60 C250	Fire Partition	708	FP	60	C	250	3 3/4"		U415
FP-60 C400-I	Fire Partition	708	FP	60	C	400	5 1/4"		U465
FP-60 C400-IZ	Fire Partition	708	FP	60	C	400	5 5/8"	FULL HT.	U465
FP-60 C600-I	Fire Partition	708	FP	60	C	600	7 1/4"	FULL HT.	U465
FP-60 C600-Z	Fire Partition	708	FP	60	C	600	7 5/8"	FULL HT.	U465
FU-0 C250-I	Furred Wall		FU	0	C	250	3 1/8"		
FU-0 C400-I	Furred Wall		FU	0	C	400	4 5/8"		
FU-0 C400-IEW	Furred Wall		FU	0	C	400	5"	6" abv. clng	
FU-0 C400-IZ	Furred Wall		FU	0	C	400	5"	6" abv. clng	
FU-0 FC078-G	Furred Wall		FU	0	FC	078	1 7/8"	6" abv. clng	
IP-0 C400-I	Interior Partition		IP	0	C	400	5 1/4"	FULL HT.	
IP-0 C400-IEW	Interior Partition		IP	0	C	400	5 5/8"	FULL HT.	
IP-0 C400-IFW	Interior Partition		IP	0	C	400	6"	FULL HT.	
IP-0 C400-IZ	Interior Partition		IP	0	C	400	5 5/8"	FULL HT.	
IP-0 C400-Z2	Interior Partition		IP	0	C	400	6"	FULL HT.	
IP-0 C400-Z3	Interior Partition		IP	0	C	400	5 7/8"	FULL HT.	
IP-0 C600	Interior Partition		IP	0	C	600	7 1/4"	FULL HT.	
SB-60 C400	Smoke Barrier	709	SB	60	C	400	5 1/4"	FULL HT.	U465
SB-60 C400-I	Smoke Barrier	709	SB	60	C	400	5 1/4"	FULL HT.	U465
SB-60 C400-IFW	Smoke Barrier	709	SB	60	C	400	6"	FULL HT.	U465
SB-60 C600-IEW	Smoke Barrier	709	FP	60	C	600	7 5/8"	FULL HT.	U465
SR-00 C400-I	Smoke Resistant		FP	0	C	400	5 1/4"		
SR-00 C400-IEW	Smoke Resistant		FP	0	C	400	5 5/8"	FULL HT.	
SR-00 C400-Z	Smoke Resistant		FP	0	C	400	5 5/8"	FULL HT.	
SR-00 C600	Smoke Resistant		FP	0	C	600	7 1/4"	FULL HT.	
SR-00 C600-IEW	Smoke Resistant		FP	0	C	600	7 5/8"	FULL HT.	
SR-00 C600-IZ	Smoke Resistant		FP	0	C	600	7 5/8"	FULL HT.	

NOTE: SEE SHEET AE020 FOR PARTITION TYPE LEGEND

Revisions	Date
4 AMENDMENT 4	08/08/13

Consultants

COLLABORATIVE DESIGN STUDIO architecture of experience and place
www.collaborativedesignstudio.com
T 775.348.7777 F 775.348.0904
9444 DOUBLE R BLVD SUITE B | RENO NV 89521

Reviewing Agency - Fire Protection

AON
Fire Protection Engineering
Aon Fire Protection Engineering Corporation
11770 Bernardo Plaza Court | Suite 116 | San Diego, CA 92128
t +1.858.673.5845 | f +1.858.673.5849 | www.aonfpe.com
Fire Protection | Code | Risk | Life Safety | Security

LICENSED ARCHITECT — ARTHUR E. BONDER — 4556 — 12/31/2013 — STATE OF NEVADA

Architects/Engineers

RBB ARCHITECTS INC
10980 Wilshire Boulevard
Los Angeles, California
90024-3905
Telephone 310 473 3555
Facsimile 310 473 3555
www.rbbinc.com

917 7th St. 2nd Floor Ste. 3
Sacramento, California
95814
Telephone 310 473 3555
Facsimile 310 473 3555
www.rbbinc.com

RBB

Drawing Title
INTERIOR WALL ASSEMBLIES

Scale
1 1/2" = 1'-0"

Approved Project Director

Project Title
VA RENO HEALTHCARE SYSTEM COMMUNITY LIVING CENTER EXPANSION

Project No. #1017200
VA Contract No. VA261-P-0933

Location
975 KIRMAN AVE., RENO, NV

Date 04/15/2013
Checked RP
Drawn VH/TC

VA Project No. 654-317
Building No.
Drawing No. AE760

Office of Construction and Facilities Management
Department of Veteran Affairs

BID DOCUMENTS

three inches = one foot
one and one half inch = one foot
one inch = one foot
three quarters inch = one foot
one half inch = one foot
three eighths inch = one foot
one quarter inch = one foot
one eighth inch = one foot