


- GENERAL DEMOLITION NOTES:**
- EXISTING CONDITIONS SHOWN FROM OWNER'S DRAWINGS, MECHANICAL & ARCHITECTURAL MAY VARY FROM THAT SHOWN. CONTRACTOR MUST FIELD VERIFY AND INCLUDE ALL NECESSARY ALLOWANCES IN HIS BID.
  - PATCH ALL AREAS WHERE DEMOLITION HAS OCCURRED TO MATCH ADJACENT EXISTING CONDITIONS AS REQUIRED.
  - COORDINATE ALL MECHANICAL DEMOLITION WITH ARCHITECTURAL DEMOLITION.

- DEMOLITION KEYED NOTES:**
- REMOVE EXISTING DUCTWORK AND SUPPORTS.
  - REMOVE EXISTING PIPING AND SUPPORTS, CAP AT MAINS.
  - REMOVE EXISTING CONDENSATE PANS AND DRAIN PIPING.
  - REMOVE EXISTING CONDENSATE PANS AND DRAIN PIPING, PATCH AND RECONNECTED TO NEW CONDENSATE PANS.
  - REMOVE EXISTING CONDENSATE PANS AND DRAIN PIPING, PATCH AND RECONNECTED TO NEW CONDENSATE PANS.

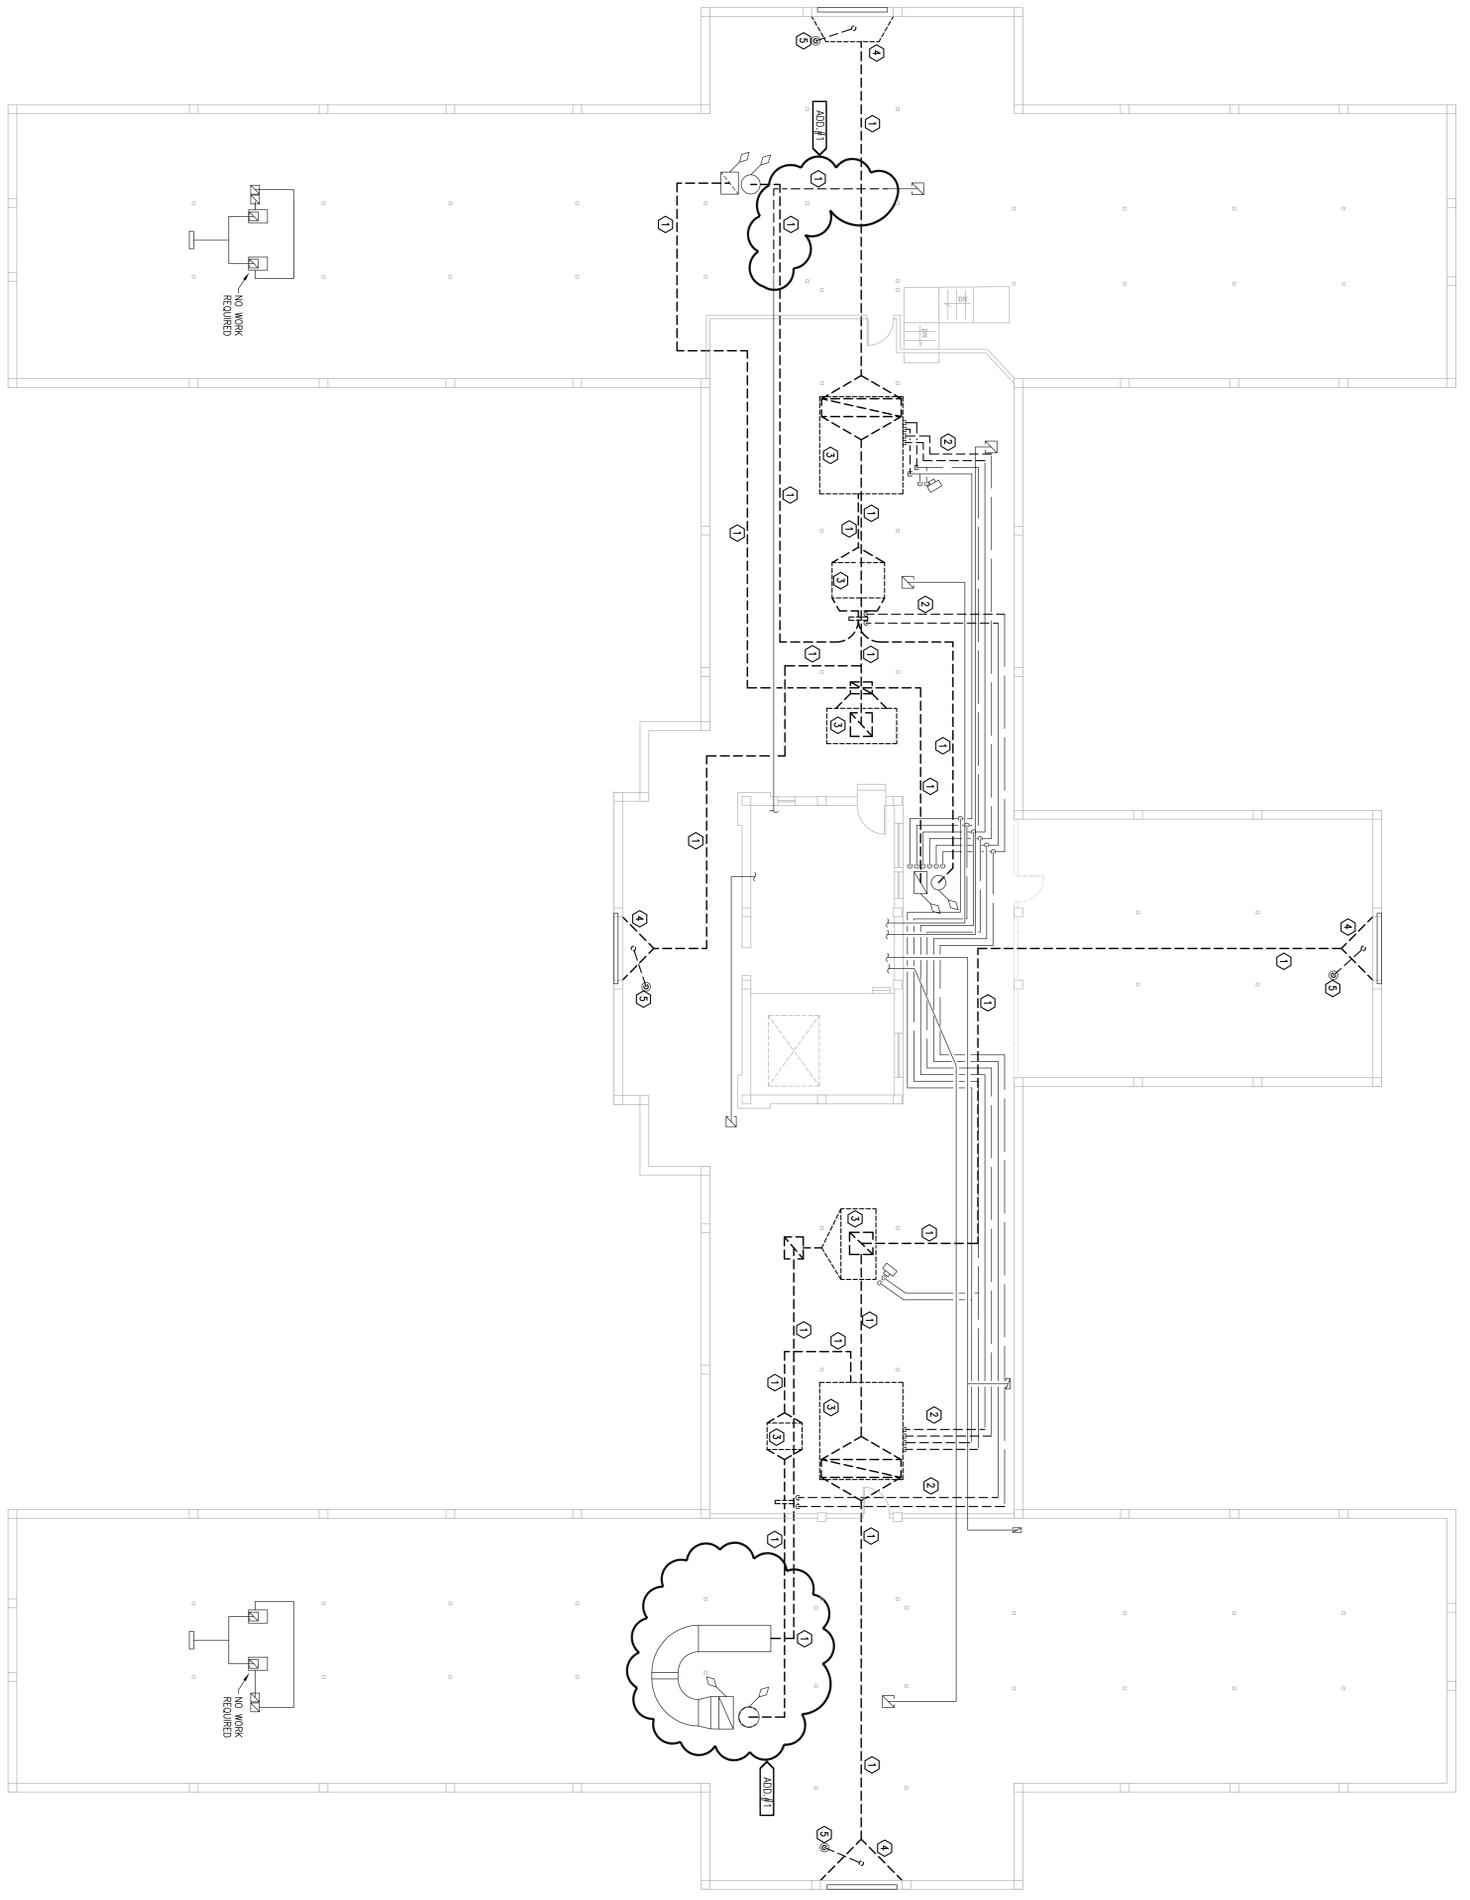

**ATTIC FLOOR PLAN - HVAC DEMOLITION**  
 SCALE: 1/8" = 1'-0"



APPROVAL BY	DATE
DESIGNER	11/23/2011
REVISIONS	DATE

Architect

3860 SPANNS DRIVE, SE  
 GRAND RAPIDS, MI  
 PROJ. NO. 1294221

URS PROJECT NO. - 1294221

stamp

INFECTION CONTROL	DATE	ENGINEERING MANAGER	DATE
SAFETY OFFICER	DATE	CARELINE MANAGER	DATE
	DATE	CHIEF OF STAFF	DATE

Project Title	DATE
ATTIC FLOOR PLAN	
HVAC DEMOLITION	
MEDICAL CENTER DIRECTOR	DATE
ASSOCIATE MEDICAL CENTER DIRECTOR	DATE

Project Title	Location
REPLACE HVAC SYSTEM	V.A.M.C. BAYTLE CREEK, MICHIGAN
PROJ. NO. 515-10-109	Building Number
CONTRACT NO. VA251-P-0592	82
	Checked
	CB
	Project
	ME

Date	05/04/2012
Station No.	515
MD103	

