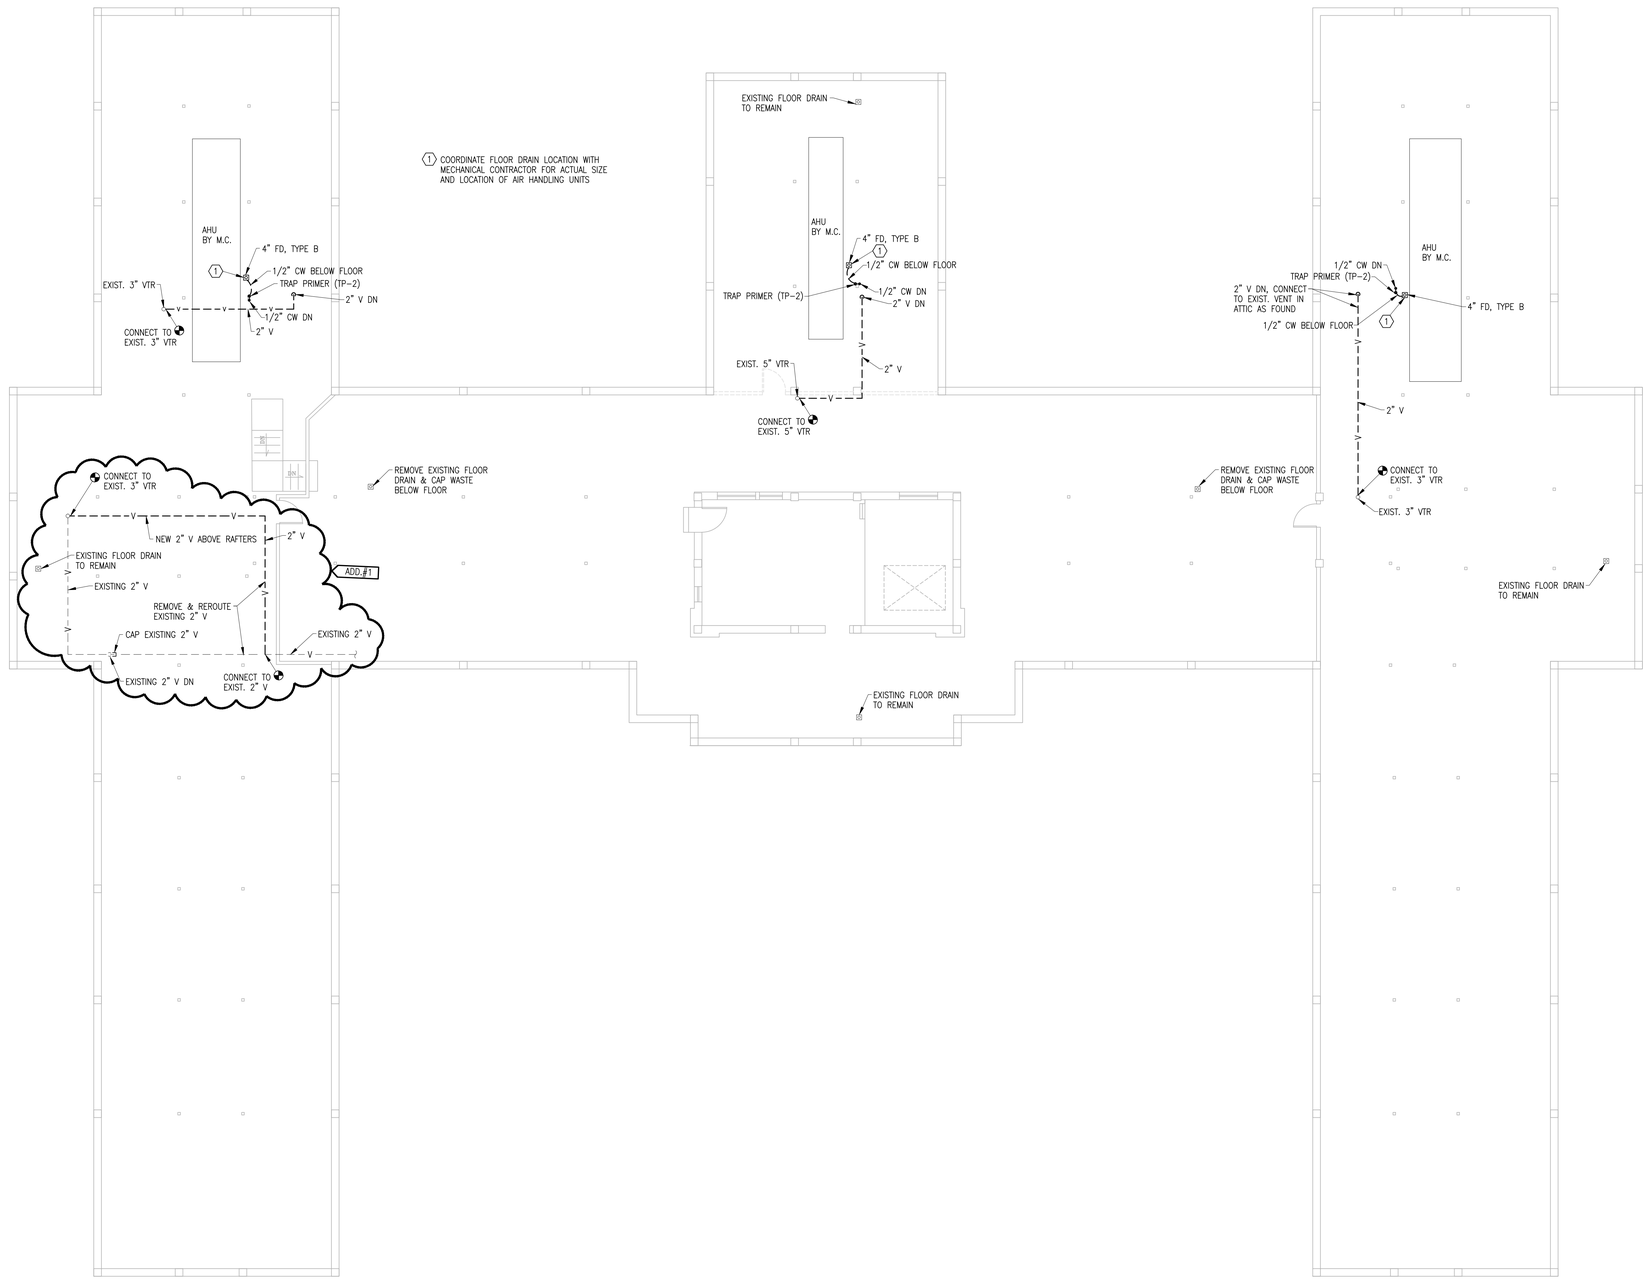

ATTIC FLOOR PLAN - PLUMBING

SCALE: 1/8" = 1'-0"

N

ADDENDUM NO. 1	06/28/2013
100% DOCUMENTS	11/30/2011
Revisions	Date

URS

3950 SPARKS DRIVE SE
GRAND RAPIDS, MI
616-574-8500
PROJ. NO. 12942721

Architect — URS PROJECT NO. – 12942721 — stamp

	DATE	ENGINEERING MANAGER	DATE
INFECTION CONTROL	DATE	CARELINE MANAGER	DATE
SAFETY OFFICER	DATE	CHIEF OF STAFF	DATE

MEDICAL CENTER DIRECTOR — DATE

ASSOCIATE MEDICAL CENTER DIRECTOR — DATE

Drawing Title: ATTIC FLOOR PLAN PLUMBING

Project Title: FCA – REPLACE HVAC SYSTEM
PROJ. NO. 515-10-109
CONTRACT NO. VA251-P-0592

Building Number: 82 | Checked | Drawn: RDS

Location: V.A.M.C. BATTLE CREEK, MICHIGAN

Date: 05/04/2012

Station No.: 515

P103

Office of Facilities

Department of Veterans Affairs