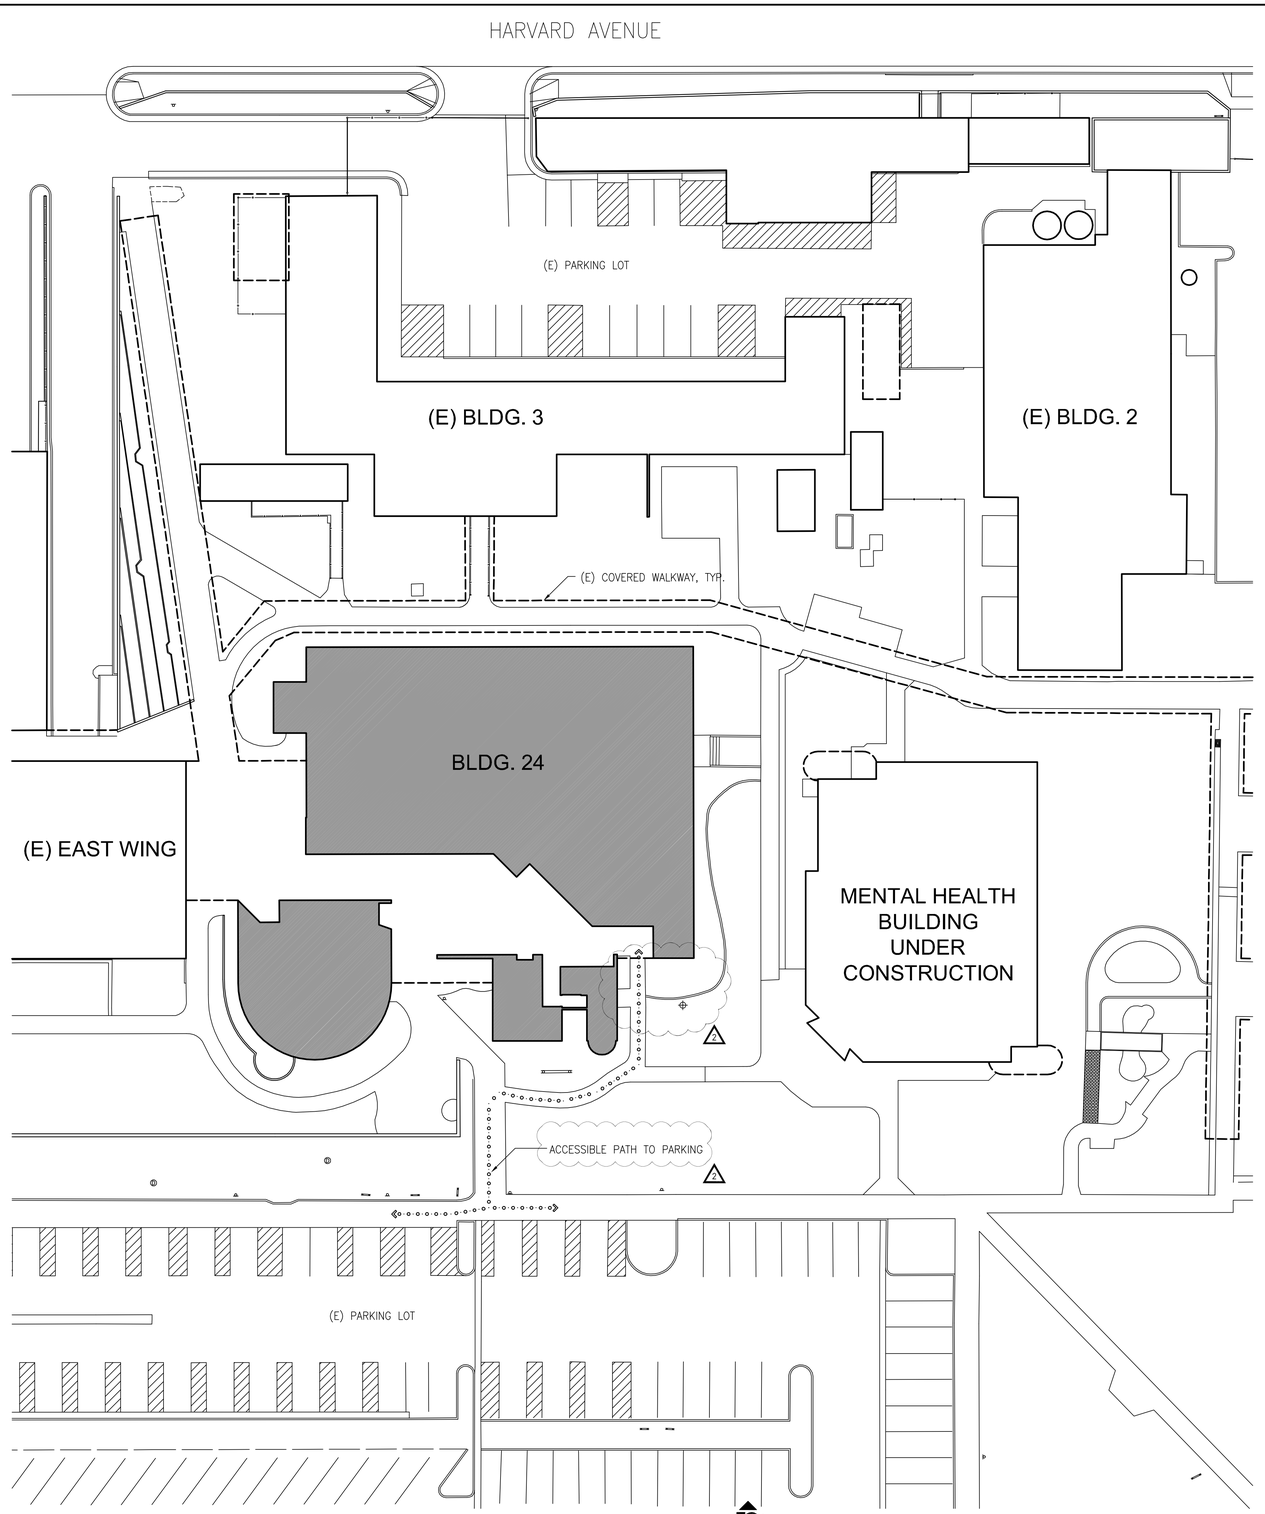


1 PARTIAL SITE PLAN
1" = 20'-0"

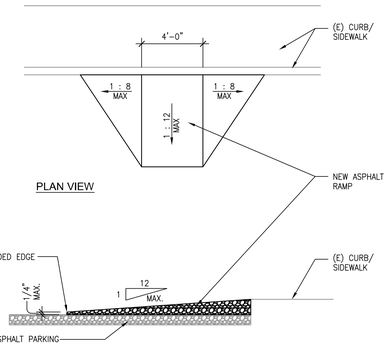


3 TEMPORARY ASPHALT RAMP
NO SCALE

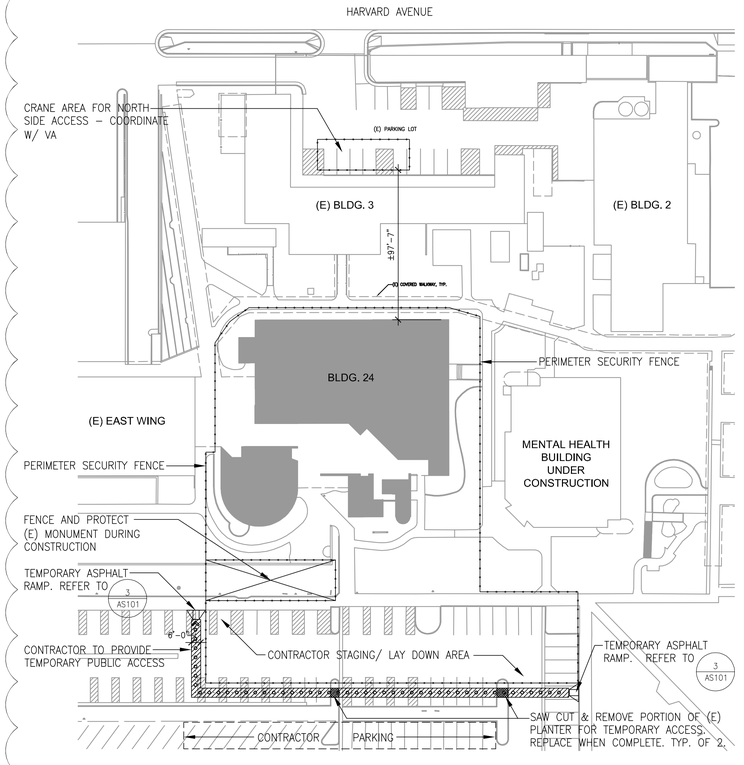


2 CONSTRUCTION STAGING SITE PLAN
1" = 40'-0"

| Revisions: | Date |
|---|---|
| 1 | 07/22/13 |
| 2 | 07/25/13 |

CONSULTANTS:

LICENSED ARCHITECT — BRIAN N. GRIM — No. C-24897 — REN. 07-31-13 — STATE OF CALIFORNIA

ARCHITECT/ENGINEERS:

HMC Architects
1827 E. Fir Avenue, Studio 103 / Fresno, CA 93720
T 559 322 2444 / www.hmcarchitects.com

Drawing Title: SITE PLAN

Approved Project Director:

Project Title: BUILDING 24 SEISMIC CORRECTION AND ADDITION

Location: VAMC FRESNO, CA

Date: March 12, 2013 | Checked: BB | Drawn: CLO

Project Number: 570-215

Building Number: 24

Drawing Number: AS101
Dwg. 34 of 176

Office of Construction and Facilities Management
Department of Veterans Affairs

VA FORM 08-6231