


three inches = one foot
 one and one half inches = one foot
 one inch = one foot
 three quarters inch = one foot
 one half inch = one foot
 three eighths inch = one foot
 one quarter inch = one foot
 one eighth inch = one foot

GENERAL NOTE:
 1. EXISTING DOOR HARDWARE TO BE REMOVED & DISPOSED OF ON DOORS TO REMAIN AND RECEIVE NEW HARDWARE AS SCHEDULED.

DEMOLITION FLOOR PLAN LEGEND
 [Hatched Pattern] EXTENT OF FLOOR FINISH DEMOLITION. SEE KEYNOTES FOR FLOORING TYPE.
 [Cross-hatched Pattern] EXTENT OF CONCRETE SLAB DEMOLITION.

- FIRST FLOOR PLAN - DEMOLITION KEYNOTES**
- 1 REMOVE DOOR. FRAME TO REMAIN.
 - 2 (E) SUNSCREEN TO REMAIN. REMOVE DEBRIS AND CLEAN VIA POWER WASH.
 - 3 REMOVE (E) WINDOW. TYPICAL ALL EXTERIOR WINDOWS THIS FLOOR. (WINDOWS TO REMAIN & PROVIDE SOLAR CONTROL FILM IN DEDUCTIVE ALTERNATE NO. 2)
 - 4 REMOVE (E) METAL TOILET PARTITION, TYPICAL.
 - 5 REMOVE (E) LOW CONCRETE WALL.
 - 6 REMOVE FINISH TO EXPOSE (E) COLUMN. REFER TO STRUCTURAL DRAWINGS FOR REQUIRED STRUCTURAL WORK.
 - 7 REMOVE DOOR AND FRAME.
 - 8 REMOVE WALL, SHOWN DASHED.
 - 9 REMOVE AUDITORIUM SEATS. TYPICAL.
 - 10 REMOVE (E) SLOPED CONCRETE FLOOR.
 - 11 NOT USED
 - 12 REMOVE (E) INTERIOR WALL FINISH FROM FLOOR TO BOTTOM OF DECK. FURRING AND INSULATION TO REMAIN, TYPICAL AT ALL EXTERIOR WALLS.
 - 13 REMOVE (E) TOILET FIXTURE, TYPICAL. REFER TO PLUMBING DRAWINGS.
 - 14 REMOVE (E) DRINKING FOUNTAIN. REFER TO PLUMBING DRAWINGS.
 - 15 REMOVE (E) CERAMIC FLOOR TILE AND WAINSCOT.
 - 16 REMOVE (E) TOILET ROOM ACCESSORIES.
 - 17 REMOVE AND PROTECT FROM DAMAGE (E) WALL MOUNTED EQUIPMENT, STAGE CURTAINS, ELECTRICAL DEVICES, SHELVES, ETC. TYPICAL. 9 ALL WALLS RECEIVING NEW FINISHES. REINSTALL IN SAME LOCATION AFTER NEW FINISH WORK IS COMPLETE.
 - 18 REMOVE (E) WALL COVERING. PREPARE WALL SURFACE TO RECEIVE NEW FINISH.
 - 19 REMOVE AND PROTECT FROM DAMAGE (E) BOOK CASE.
 - 20 REMOVE (E) CARPET TILES.
 - 21 REMOVE (E) CARPET.
 - 22 REMOVE (E) VCT TILES.
 - 23 REMOVE (E) CERAMIC TILE FLOOR.
 - 24 REMOVE (E) CONCRETE LANDING.
 - 25 AUTOMATIC DOOR AND SIDELIGHT TO REMAIN. (PROTECT)
 - 26 (E) CASEWORK TO FREE STANDING CASEWORK TO BE REMOVED BY OWNER.
 - 27 (E) LANDING TO REMAIN.
 - 28 (E) WORKSTATION. OWNER TO REMOVE.
 - 29 REMOVE (E) CONCRETE RAMP.
 - 30 REMOVE (E) GLAZING. (E) FRAME TO REMAIN.
 - 31 REMOVE (E) CONCRETE STAGE FLOOR.
 - 32 REMOVE (E) WALL FINISH TO EXPOSE (E) STUDS. TYPICAL ALL INTERIOR WALLS IN THIS ROOM.
 - 33 NOT USED
 - 34 REMOVE (E) GYPSUM BOARD BELOW WINDOW SILL TO EXPOSE (E) STUDS.
 - 35 REMOVE AND PROTECT FROM DAMAGE (E) DATA EQUIPMENT AND RACK. REINSTALL IN SAME LOCATION AFTER NEW FINISH WORK IS COMPLETE.
 - 36 REMOVE AND PROTECT FROM DAMAGE (E) WALL MOUNTED TV'S, SPEAKERS, ELECTRICAL DEVICES, STAGE CURTAINS AND CEILING MOUNTED PROJECTION SCREEN. (AT DEDUCTIVE ALTERNATE 4: REINSTALL ALL ITEMS LISTED ABOVE IN SAME LOCATION AFTER NEW FINISH WORK IS COMPLETE. PROVIDE STUD BACKING PER DETAIL 2/AS906)
 - 37 (E) TRANSOM WINDOW TO REMAIN.

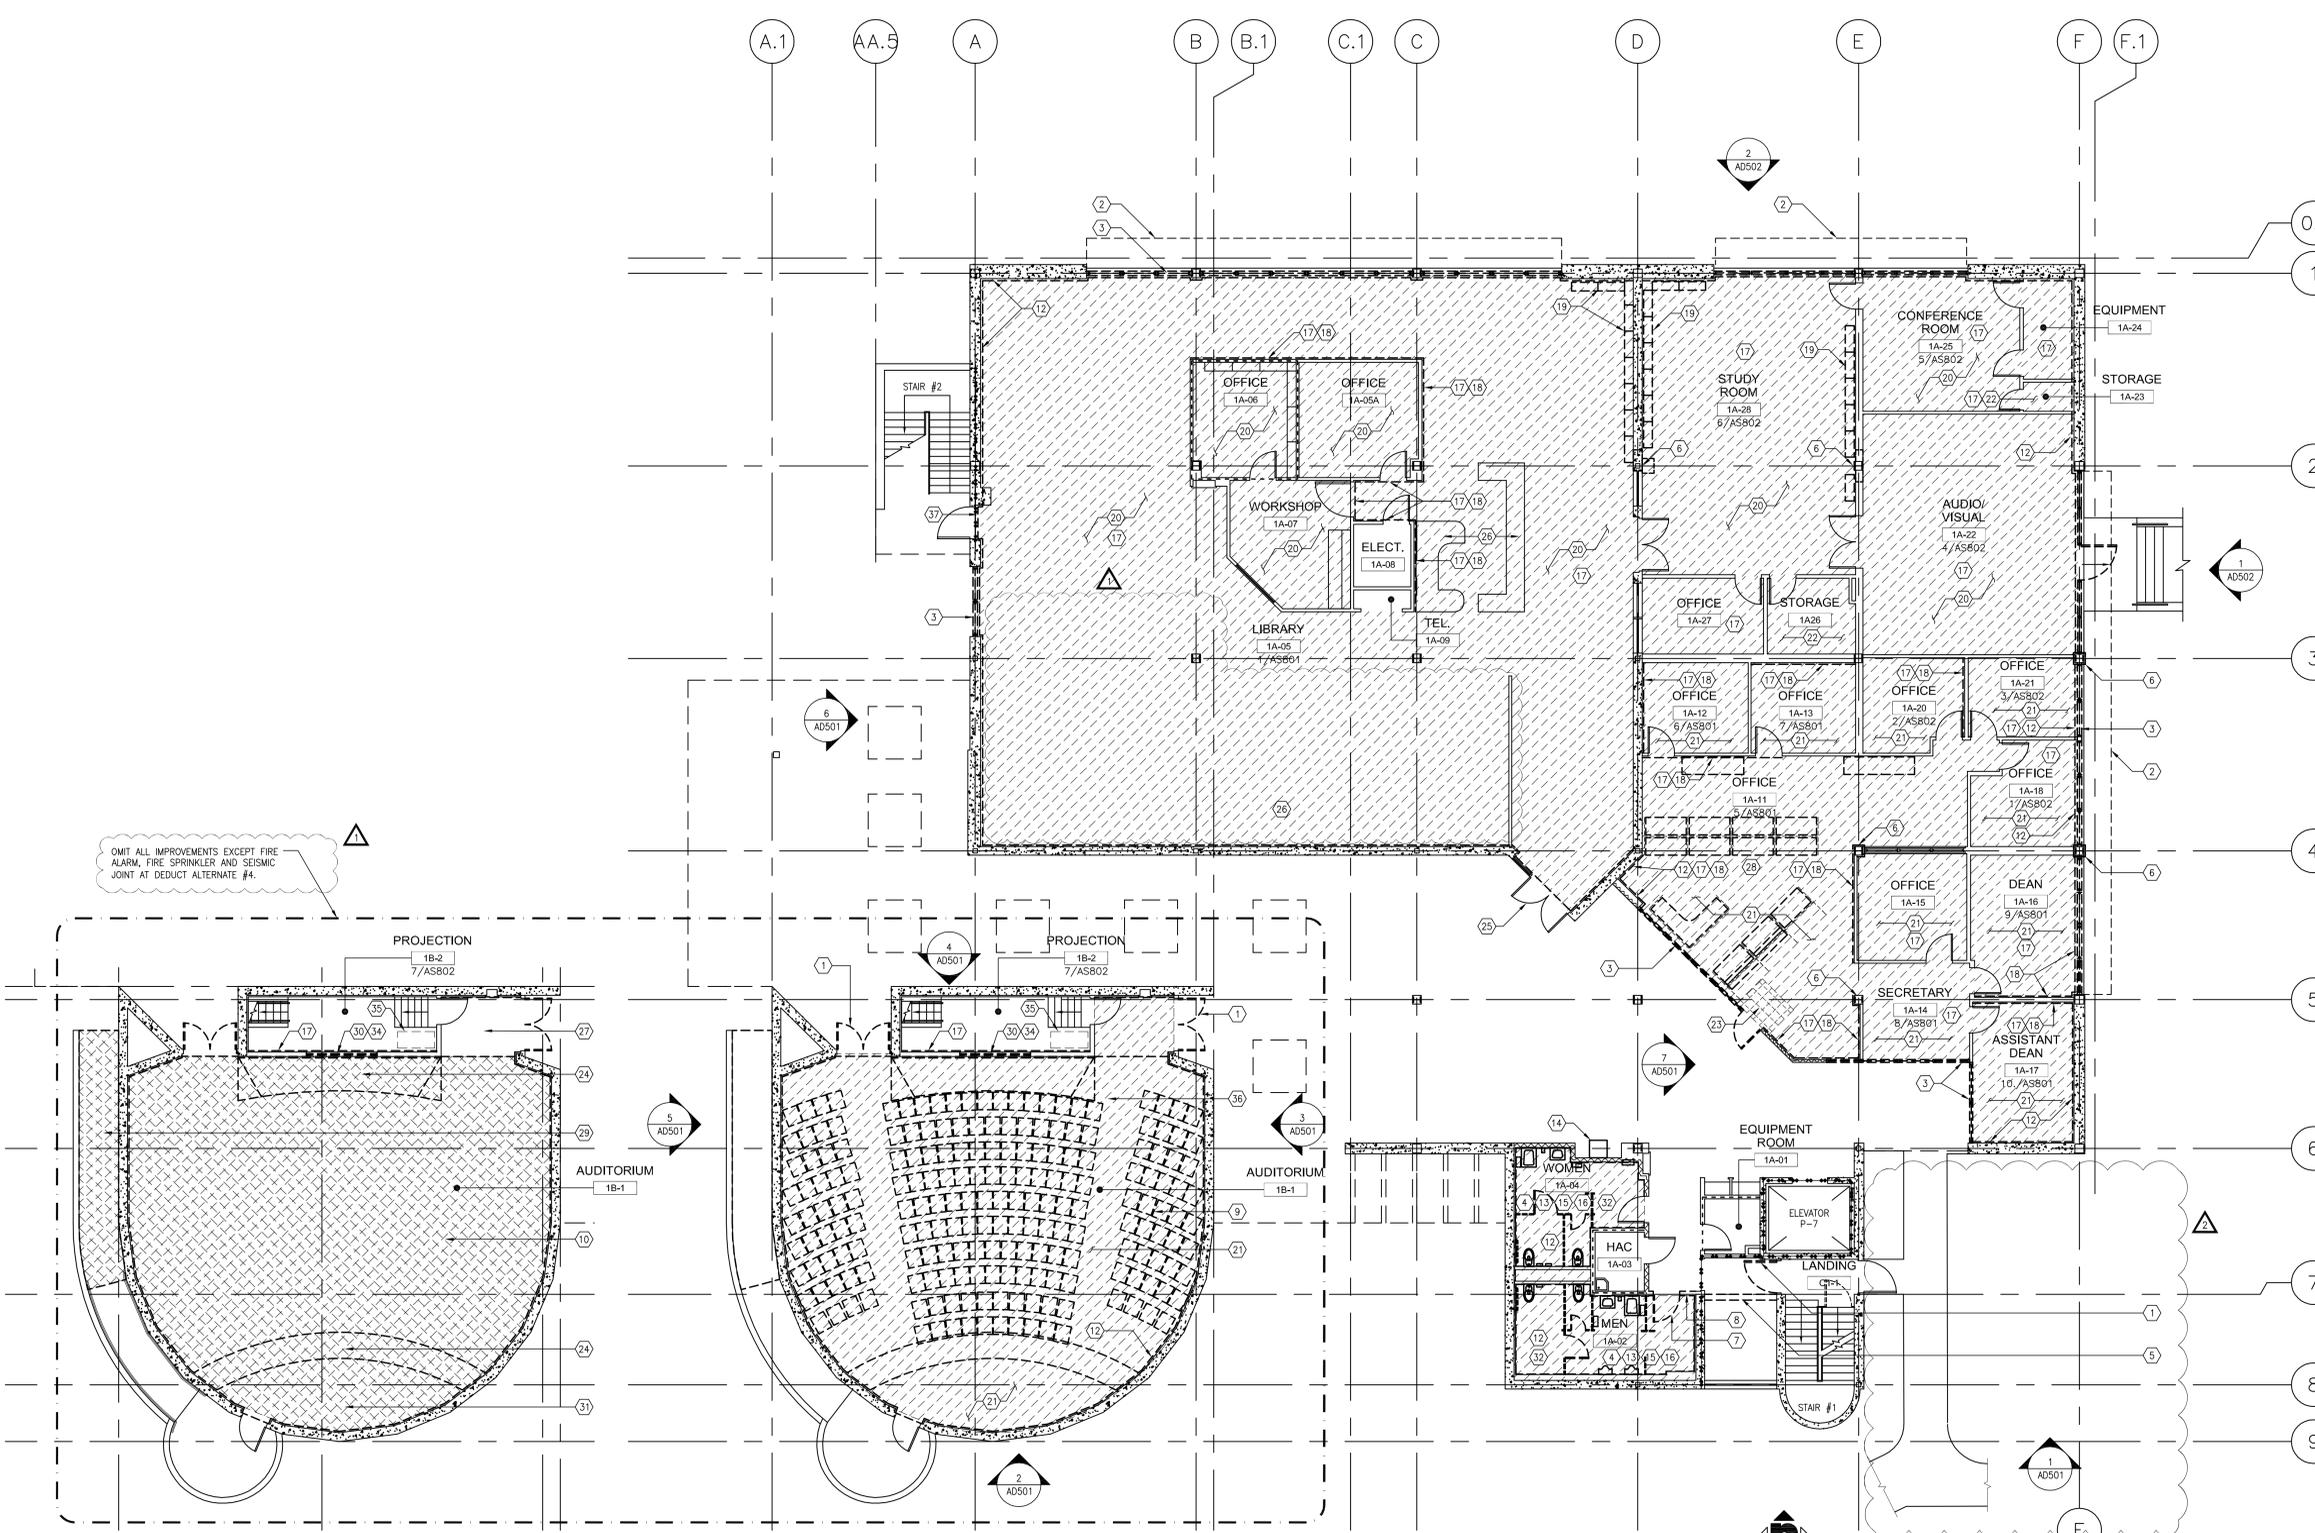

2 AUDITORIUM FLOOR SLAB DEMOLITION PLAN
 1/8" = 1'-0"

1 DEMOLITION FIRST FLOOR PLAN
 1/8" = 1'-0"

Revisions Date	07/22/13 07/25/13	CONSULTANTS:		ARCHITECT/ENGINEERS:	Drawing Title DEMOLITION FIRST FLOOR PLAN	Project Title BUILDING 24 SEISMIC CORRECTION AND ADDITION	Project Number 570-215 Building Number 24	Office of Construction and Facilities Management
	Date	Date		HMC Architects 1827 E. Fir Avenue, Studio 103 / Fresno, CA 93720 T. 559.322.2444 / www.hmcarchitects.com	Approved Project Director	Location VAMC FRESNO, CA	Drawing Number AD201 Dwg. 35 of 176	