


three inches = one foot
 one and one half inches = one foot
 one inch = one foot
 three quarters inch = one foot
 one half inch = one foot
 three eighths inch = one foot
 one quarter inch = one foot
 one eighth inch = one foot

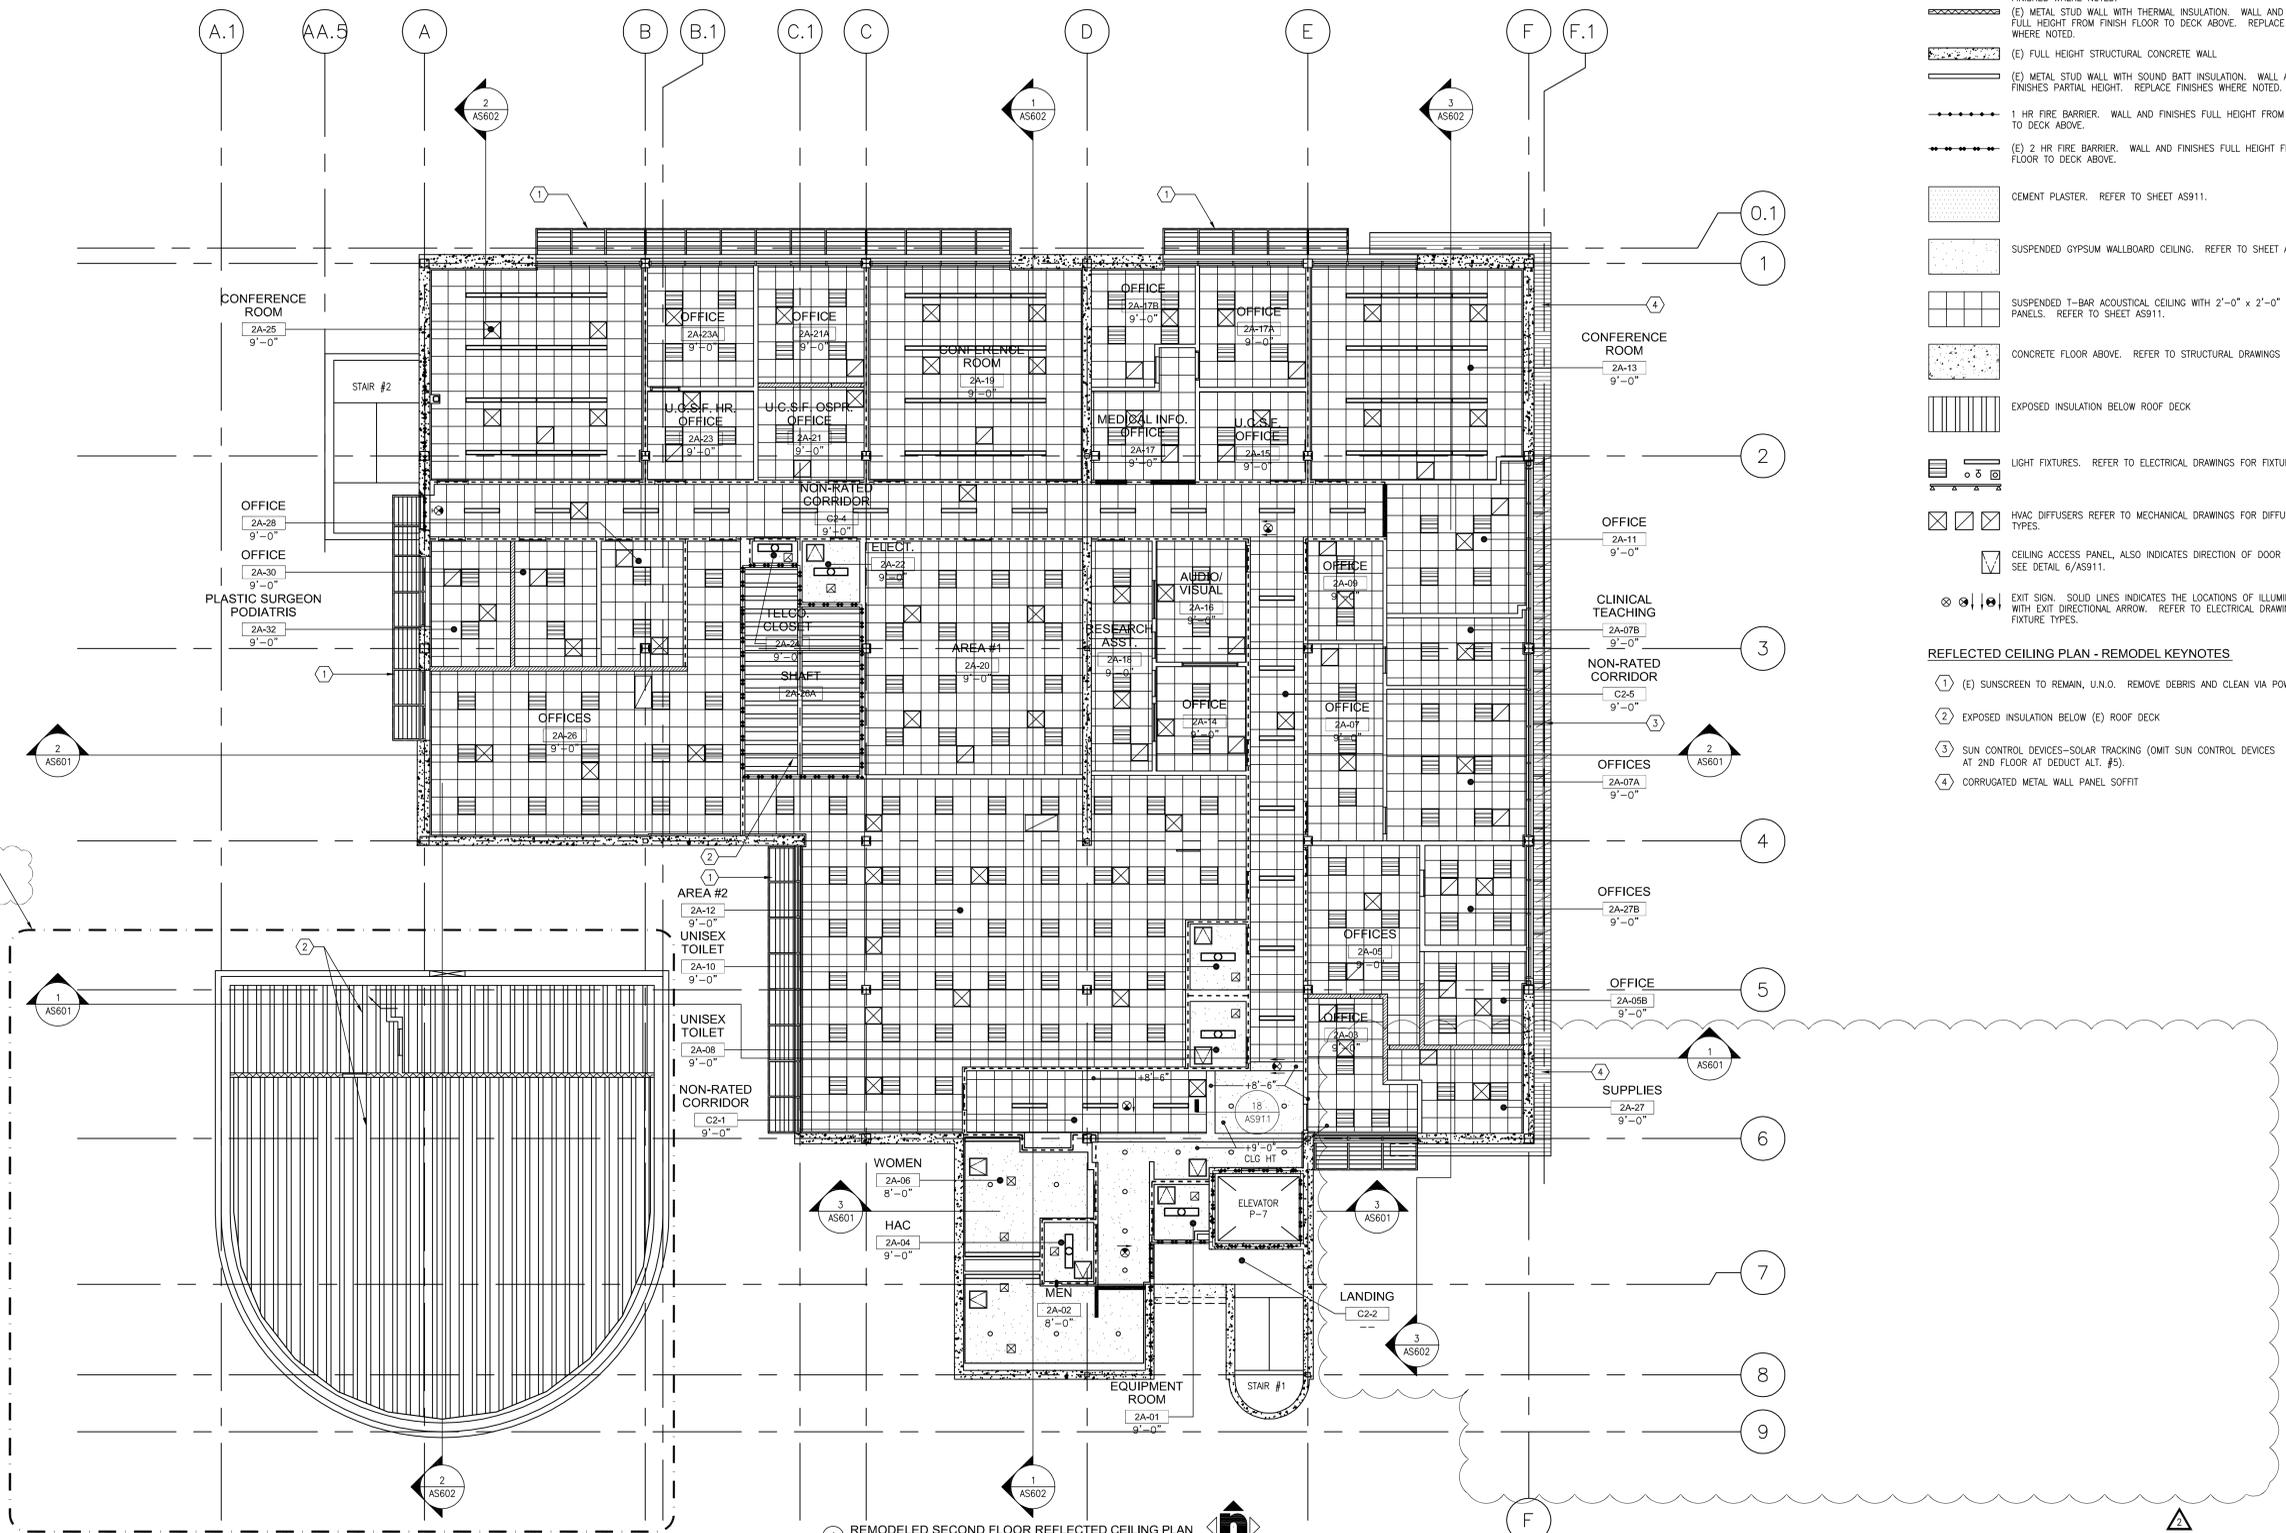

- REFLECTED CEILING PLAN LEGEND**
- FULL HEIGHT METAL STUD @ 16" O.C. U.N.O. WITH SOUND BATT. INSULATION AND FINISHES FULL HEIGHT FROM FINISH FLOOR TO DECK ABOVE. REFER TO DETAIL 6, 7 & 8/AS906.
 - PARTIAL HEIGHT METAL STUD @ 16" O.C. U.N.O. WITH SOUND BATT. INSULATION AND FINISHES FROM FINISH FLOOR TO 2" ABOVE FINISH CEILING. REFER TO DETAIL 5/AS906.
 - (E) METAL STUD WALL WITH SOUND BATT INSULATION. WALL AND FINISHES FULL HEIGHT FROM FINISH FLOOR TO DECK ABOVE. REPLACE FINISHES WHERE NOTED.
 - (E) METAL STUD WALL WITH THERMAL INSULATION. WALL AND FINISHES FULL HEIGHT FROM FINISH FLOOR TO DECK ABOVE. REPLACE FINISHES WHERE NOTED.
 - (E) FULL HEIGHT STRUCTURAL CONCRETE WALL.
 - (E) METAL STUD WALL WITH SOUND BATT INSULATION. WALL AND FINISHES PARTIAL HEIGHT. REPLACE FINISHES WHERE NOTED.
 - 1 HR FIRE BARRIER. WALL AND FINISHES FULL HEIGHT FROM FLOOR TO DECK ABOVE.
 - (E) 2 HR FIRE BARRIER. WALL AND FINISHES FULL HEIGHT FROM FLOOR TO DECK ABOVE.
 - CEMENT PLASTER. REFER TO SHEET AS911.
 - SUSPENDED GYPSUM WALLBOARD CEILING. REFER TO SHEET AS911.
 - SUSPENDED T-BAR ACOUSTIC CEILING WITH 2'-0" x 2'-0" INFILL PANELS. REFER TO SHEET AS911.
 - CONCRETE FLOOR ABOVE. REFER TO STRUCTURAL DRAWINGS.
 - EXPOSED INSULATION BELOW ROOF DECK.
 - LIGHT FIXTURES. REFER TO ELECTRICAL DRAWINGS FOR FIXTURE TYPES.
 - HVAC DIFFUSERS REFER TO MECHANICAL DRAWINGS FOR DIFFUSER TYPES.
 - CEILING ACCESS PANEL, ALSO INDICATES DIRECTION OF DOOR SWING. SEE DETAIL 6/AS911.
 - EXIT SIGN - SOLID LINES INDICATES THE LOCATIONS OF ILLUMINATION WITH EXIT DIRECTIONAL ARROW. REFER TO ELECTRICAL DRAWINGS FOR FIXTURE TYPES.

- REFLECTED CEILING PLAN - REMODEL KEYNOTES**
- ① (E) SUNSCREEN TO REMAIN, U.N.O. REMOVE DEBRIS AND CLEAN VIA POWERWASH.
 - ② EXPOSED INSULATION BELOW (E) ROOF DECK.
 - ③ SUN CONTROL DEVICES-SOLAR TRACKING (OMIT SUN CONTROL DEVICES AT 2ND FLOOR AT DEDUCT ALT. #5).
 - ④ CORRUGATED METAL WALL PANEL SOFFIT

1 REMODELED SECOND FLOOR REFLECTED CEILING PLAN
 1/8" = 1'-0"

Revisions	Date
△	07/22/13
△	07/25/13

CONSULTANTS:



ARCHITECT/ENGINEERS:

HMC Architects

1827 E. Fir Avenue, Studio 103 / Fresno, CA 93720
 T. 559.322.2444 / www.hmcarchitects.com

Drawing Title
 SECOND FLOOR REFLECTED CEILING PLAN

Approved Project Director

Project Title
 BUILDING 24
 SEISMIC CORRECTION
 AND ADDITION

Location
 VAMC FRESNO, CA

Date
 March 12, 2013

Checked
 BB

Drawn
 CLO

Project Number
 570-215

Building Number
 24

Drawing Number
 AS302
 Dwg. 50 of 176

Office of Construction and Facilities Management

Department of Veterans Affairs