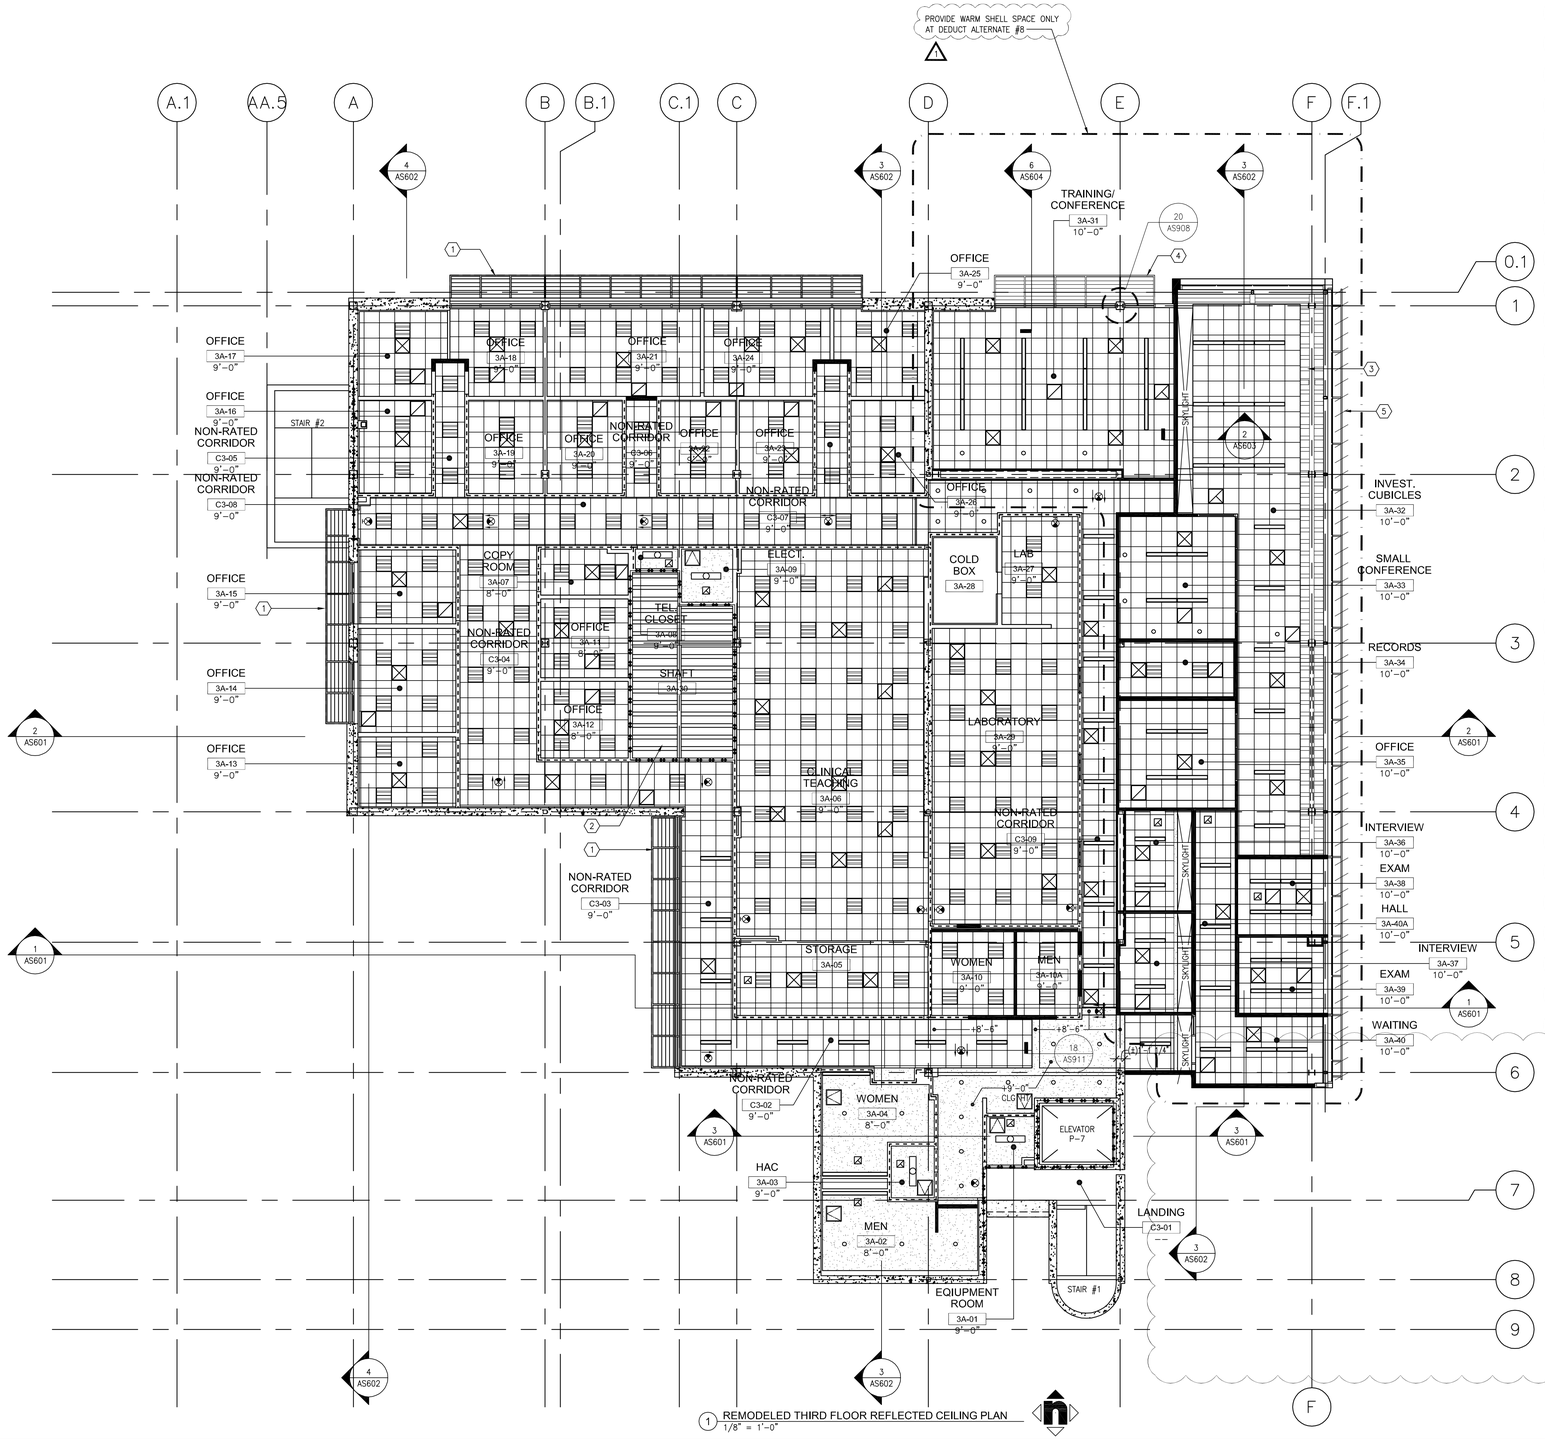

1 REMODELED THIRD FLOOR REFLECTED CEILING PLAN
1/8" = 1'-0"

REMODELED PARTIAL THIRD FLOOR REFLECTED CEILING PLAN DEDUCTIVE ALTERNATE 8
1/8" = 1'-0"

REFLECTED CEILING PLAN LEGEND

- FULL HEIGHT METAL STUD @ 16" O.C. U.N.O. WITH SOUND BATT. INSULATION AND FINISHES FULL HEIGHT FROM FINISH FLOOR TO DECK ABOVE. REFER TO DETAIL 6, 7 & 8/AS906.
- PARTIAL HEIGHT METAL STUD @ 16" O.C. U.N.O. WITH SOUND BATT, INSULATION AND FINISHES FROM FINISH FLOOR TO 2" ABOVE FINISH CEILING. REFER TO DETAIL 5/AS906.
- (E) METAL STUD WALL WITH SOUND BATT INSULATION. WALL AND FINISHES FULL HEIGHT FROM FINISH FLOOR TO DECK ABOVE. REPLACE FINISHES WHERE NOTED.
- (E) METAL STUD WALL WITH THERMAL INSULATION. WALL AND FINISHES FULL HEIGHT FROM FINISH FLOOR TO DECK ABOVE. REPLACE FINISHES WHERE NOTED.
- (E) CONCRETE WALL
- (E) METAL STUD WALL WITH SOUND BATT INSULATION. WALL AND FINISHES PARTIAL HEIGHT FROM FINISH FLOOR TO 6" ABOVE FINISH CEILING. REPLACE FINISHES WHERE NOTED.
- 1 HR FIRE BARRIER. WALL AND FINISHES FULL HEIGHT FROM FLOOR TO DECK ABOVE.
- (E) 2 HR FIRE BARRIER. WALL AND FINISHES FULL HEIGHT FROM FLOOR TO DECK ABOVE.
- CEMENT PLASTER. REFER TO SHEET AS911.
- SUSPENDED GYPSUM WALLBOARD CEILING. REFER TO SHEET AS911.
- SUSPENDED T-BAR ACOUSTICAL CEILING WITH 2'-0" x 2'-0" INFILL PANELS. REFER TO SHEET AS911.
- EXPOSED INSULATION BELOW ROOF DECK
- LIGHT FIXTURES. REFER TO ELECTRICAL DRAWINGS FOR FIXTURE TYPES.
- HVAC DIFFUSERS REFER TO MECHANICAL DRAWINGS FOR DIFFUSER TYPES.
- CEILING ACCESS PANEL, ALSO INDICATES DIRECTION OF DOOR SWING. SEE DETAIL 6/AS911.
- EXIT SIGN. SOLID LINES INDICATES THE LOCATIONS OF ILLUMINATION WITH EXIT DIRECTIONAL ARROW. REFER TO ELECTRICAL DRAWINGS FOR FIXTURE TYPES.

REFLECTED CEILING PLAN - REMODEL KEYNOTES

1. (E) SUNSCREEN TO REMAIN, U.N.O. REMOVE DEBRIS AND CLEAN VIA POWERWASH.
2. EXPOSED INSULATION BELOW (E) ROOF DECK.
3. EXPOSED STRUCTURE PAINT
4. SUNSCREEN. SEE DETAIL 19/AS908.
5. SUN CONTROL DEVICES-SOLAR TRACKING (OMIT AT DEDUCT ALTERNATE # 7)

Revisions	Date
1	07/22/13
2	07/25/13

CONSULTANTS:

LICENSED ARCHITECT — NO. C-24897 — REN. 07-31-13 — STATE OF CALIFORNIA

ARCHITECT/ENGINEERS:

HMC Architects
1827 E. Fir Avenue, Studio 103 / Fresno, CA 93720
T 559 322 2444 / www.hmcarchitects.com

Drawing Title: THIRD FLOOR REFLECTED CEILING PLAN
Approved: Project Director

Project Title: BUILDING 24 SEISMIC CORRECTION AND ADDITION
Location: VAMC FRESNO, CA
Date: March 12, 2013 | Checked: BB | Drawn: CLO

Project Number: 570-215
Building Number: 24
Drawing Number: AS303
Dwg. 51 of 176

Office of Construction and Facilities Management
Department of Veterans Affairs

VA FORM 08-6231