


A three inches = one foot
 B one and one half inches = one foot
 C one inch = one foot
 D three quarters inch = one foot
 E one half inch = one foot
 F three eighths inch = one foot
 G one quarter inch = one foot
 H one eighth inch = one foot

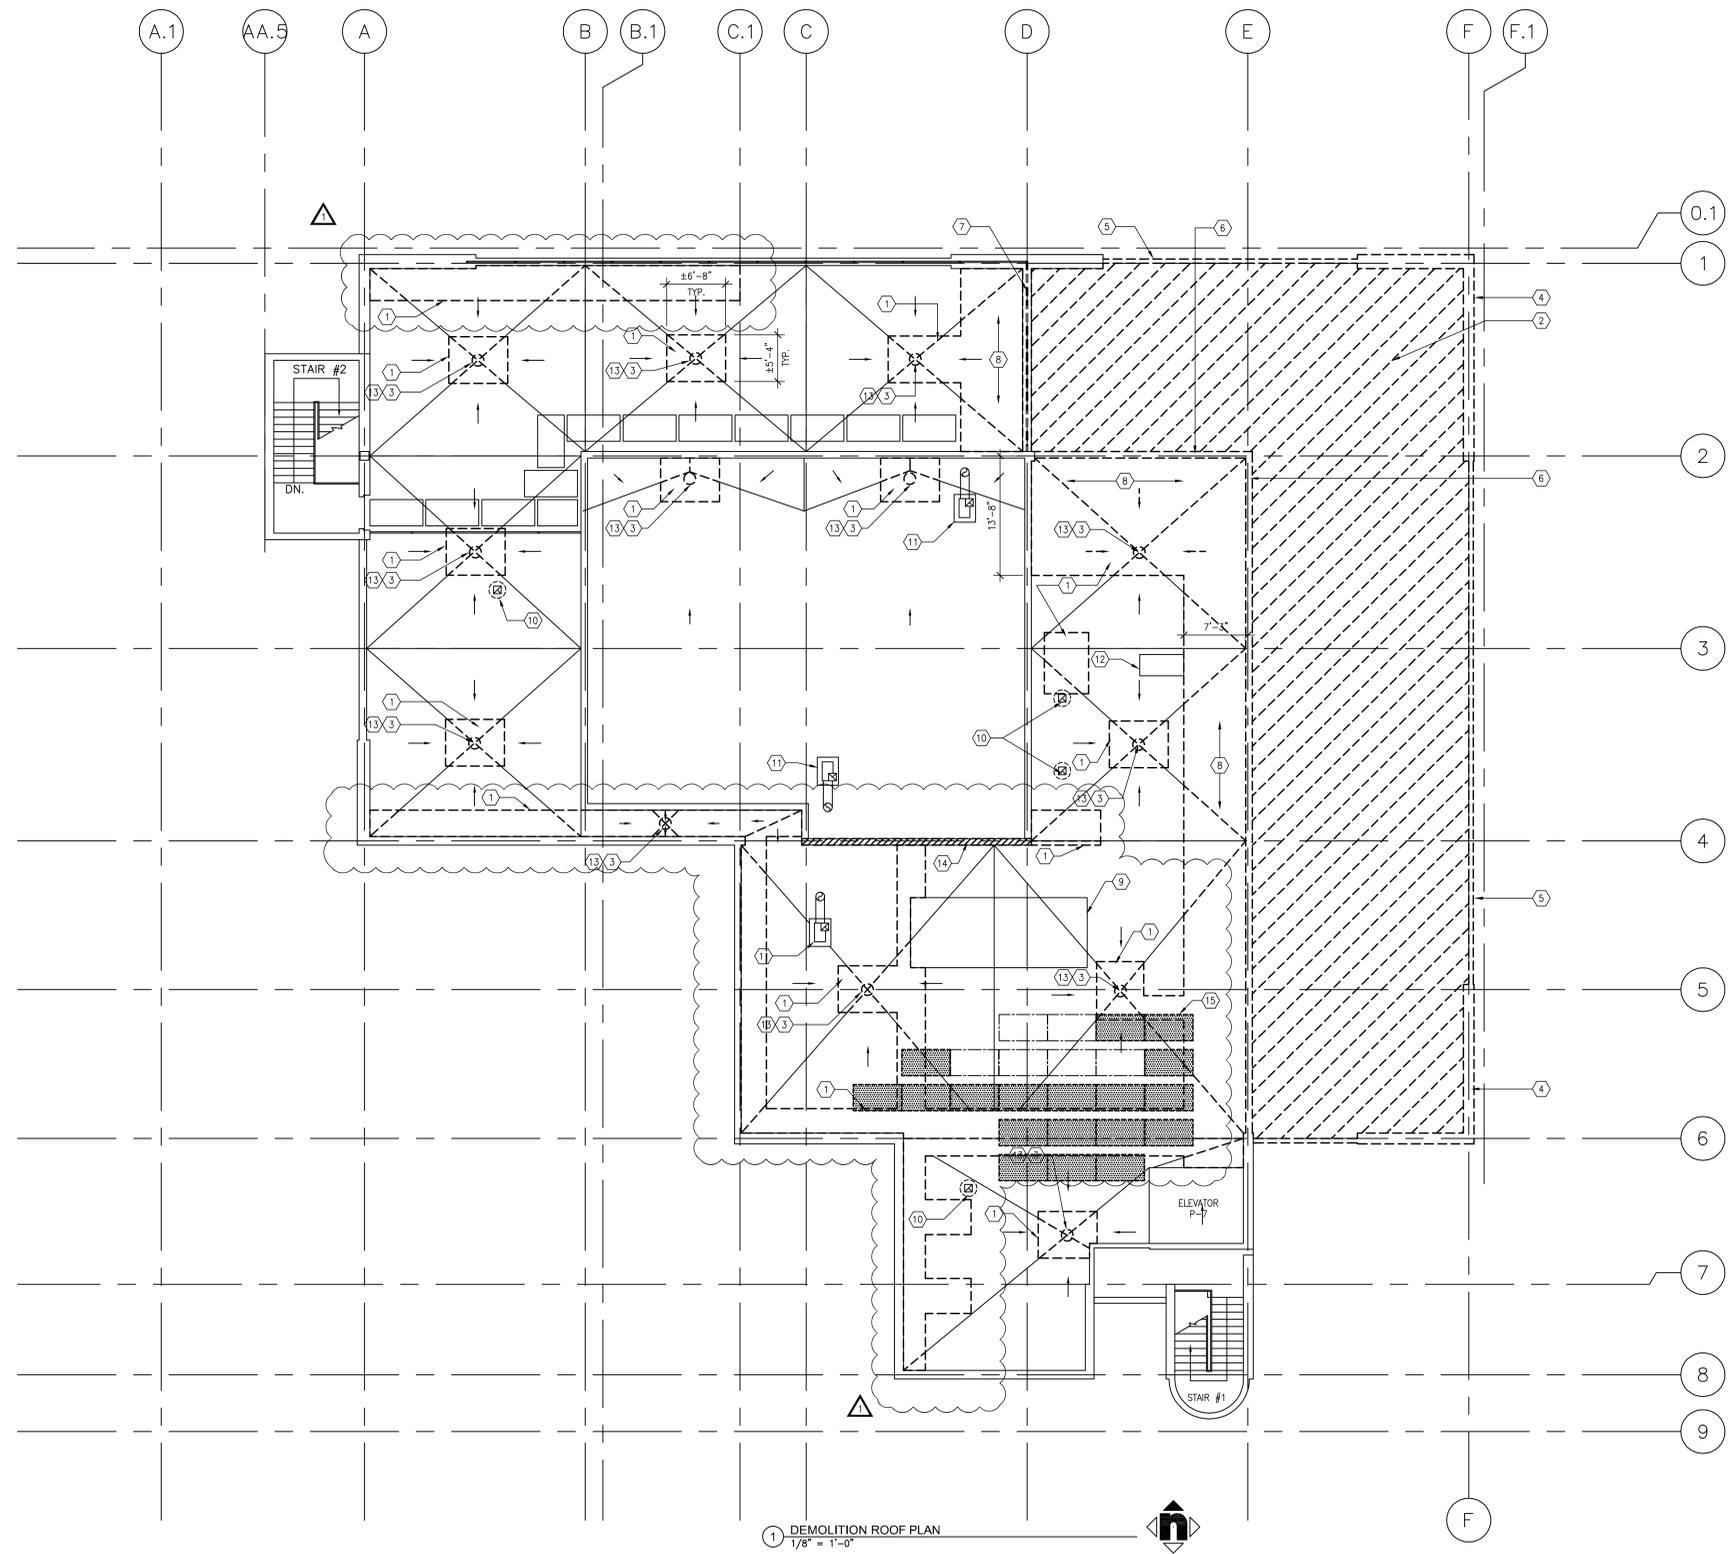

ROOF PLAN - DEMOLITION KEYNOTES

- ① REMOVE (E) ROOFING AND INSULATION, TYPICAL.
- ② ROOF BELOW. REFER TO THIRD FLOOR DEMOLITION PLAN FOR DEMOLITION WORK IN THIS AREA.
- ③ REMOVE (E) ROOF DRAIN, TYPICAL. REFER TO PLUMBING DRAWINGS.
- ④ REMOVE (E) CONCRETE PARAPET. REFER TO STRUCTURAL DRAWINGS.
- ⑤ REMOVE (E) METAL STUD PARAPET.
- ⑥ REMOVE (E) METAL STUD PARAPET.
- ⑦ REMOVE (E) GUARD RAIL.
- ⑧ REFER TO STRUCTURAL DRAWINGS FOR ADDITIONAL DEMOLITION WORK.
- ⑨ (E) AIR HANDLER TO REMAIN
- ⑩ EXHAUST FAN TO REMAIN
- ⑪ (E) FUME HOOD EXHAUST FAN, SEE MECHANICAL DRAWINGS
- ⑫ (E) TRANSFORMER TO REMAIN
- ⑬ CORE DRILL THRU (E) CONCRETE ROOF DECK FOR NEW OVER FLOW DRAIN. USE (E) ROOF OPENING FOR NEW ROOF DRAIN.
- ⑭ DEMO BOTTOM PORTION OF PENTHOUSE WALL FOR INSTALLATION OF COLLECTOR TOP PLATE SHOWN ON STRUCTURAL DRAWINGS
- ⑮ REMOVE AND PROTECT FROM DAMAGE (E) PV PANEL TO PROVIDE CLEARANCE FOR NEW RE-ROOFING WORK. (TYP. OF 18 PANELS)

1 DEMOLITION ROOF PLAN
1/8" = 1'-0"

Revisions	Date

CONSULTANTS:



ARCHITECT/ENGINEERS:

HMC Architects

1827 E. Fir Avenue, Studio 103 / Fresno, CA 93720
T. 559.322.2444 / www.hmcarchitects.com

Drawing Title
DEMOLITION ROOF PLAN

Approved Project Director

Project Title
BUILDING 24
SEISMIC CORRECTION
AND ADDITION

Location
VAMC FRESNO, CA

Date
March 12, 2013

Checked
BB

Drawn
CLO

Project Number
570-215
Building Number
24

Drawing Number
AD401
Dwg. 52 of 176

Office of Construction and Facilities Management

Department of Veterans Affairs