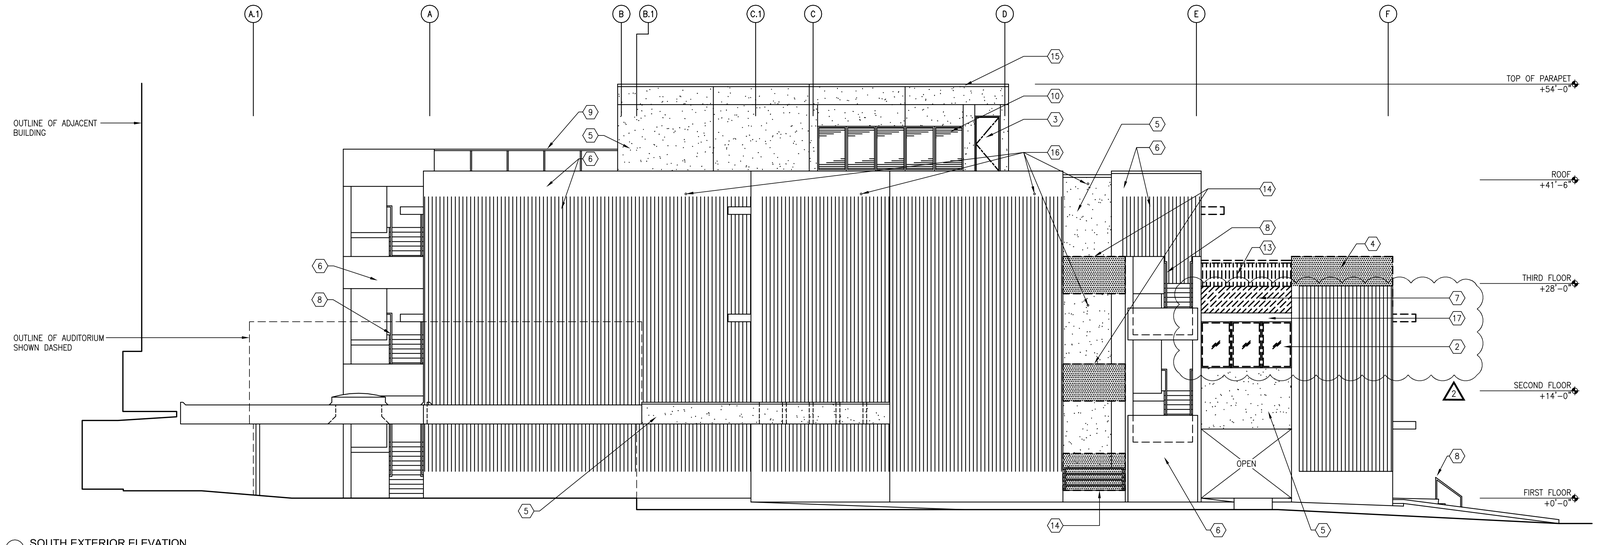

1 SOUTH EXTERIOR ELEVATION
1/8" = 1'-0"

EXTERIOR ELEVATION - DEMOLITION KEYNOTES

1. NOT USED
2. REMOVE ALL (E) EXTERIOR WINDOWS, TYPICAL (EXISTING WINDOWS TO REMAIN & PROVIDE SOLAR CONTROL FILM AT DEDUCTIVE ALTERNATE 2)
3. PREPARE (E) EXTERIOR DOOR AND FRAME FOR NEW PAINT. (OMIT PREP AT DEDUCTIVE ALTERNATE 3)
4. REMOVE (E) CONCRETE PARAPET WALL. SEE STRUCTURAL DRAWINGS.
5. PREP ALL (E) CEMENT PLASTER FOR NEW PAINT, TYPICAL. (OMIT PREP AT DEDUCTIVE ALTERNATE 3)
6. PREP ALL (E) EXTERIOR CONCRETE WALLS FOR NEW PAINT, TYPICAL. (OMIT PREP AT DEDUCTIVE ALTERNATE 3)
7. REMOVE (E) EXTERIOR CEMENT PLASTER.
8. PREP ALL (E) STAIR HAND RAILS FOR NEW PAINT. (OMIT PREP AT DEDUCTIVE ALTERNATE 3)
9. PREP ALL (E) GUARD RAILS FOR NEW PAINT. (OMIT PREP AT DEDUCTIVE ALTERNATE 3)
10. PREP (E) LOUVERS FOR PAINT. (OMIT PREP AT DEDUCTIVE ALTERNATE 3)
11. REMOVE AND DISPOSE OF (E) RAILING.
12. NOT USED
13. REMOVE (E) METAL STUD PARAPET WALL.
14. REMOVE (E) LOW CONCRETE WALL.
15. PREP ALL PARAPET CAPS & METAL FASCIAS FOR NEW PAINT, TYP. (OMIT PREP AT DEDUCTIVE ALTERNATE 3)
16. CORE HOLE IN (E) WALL FOR NEW OVER FLOW DRAIN. COORDINATE LOCATION WITH PLUMBING DRAWINGS.
17. (E) EXTERIOR SUN SCREENS TO REMAIN. REMOVE DEBRIS AND CLEAN VIA POWERWASH.
18. NOT USED
19. NOT USED
20. AUTOMATIC DOORS AND SIDELIGHT FRAME TO REMAIN. REMOVE (E) GLAZING. (EXISTING GLAZING TO REMAIN AT DEDUCTIVE ALTERNATE NO. 2)
21. PROTECT (E) SIGNAGE & PLAQUES

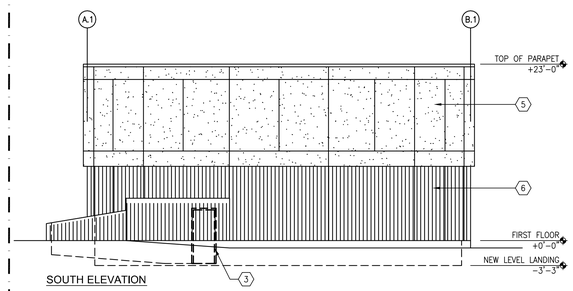

SOUTH ELEVATION

2 AUDITORIUM EXTERIOR ELEVATION
1/8" = 1'-0"

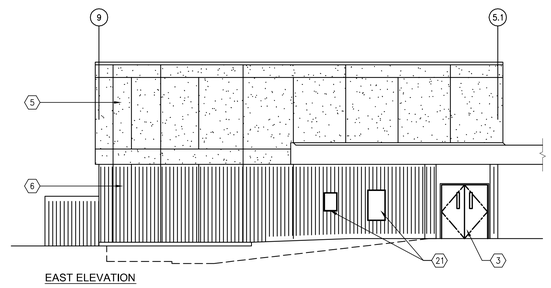

EAST ELEVATION

3 AUDITORIUM EXTERIOR ELEVATION
1/8" = 1'-0"

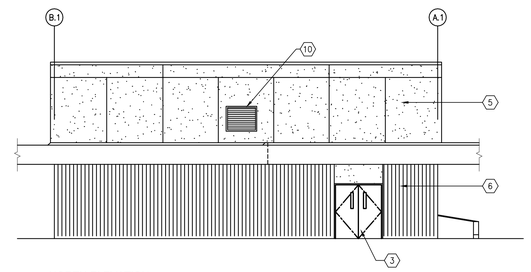

NORTH ELEVATION

4 AUDITORIUM EXTERIOR ELEVATION
1/8" = 1'-0"

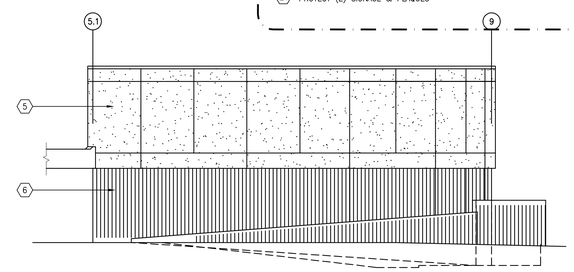

WEST ELEVATION

5 AUDITORIUM EXTERIOR ELEVATION
1/8" = 1'-0"

OMIT ALL IMPROVEMENTS EXCEPT FIRE ALARM, FIRE SPRINKLER AND SEISMIC JOINT AT DEDUCT ALT #4

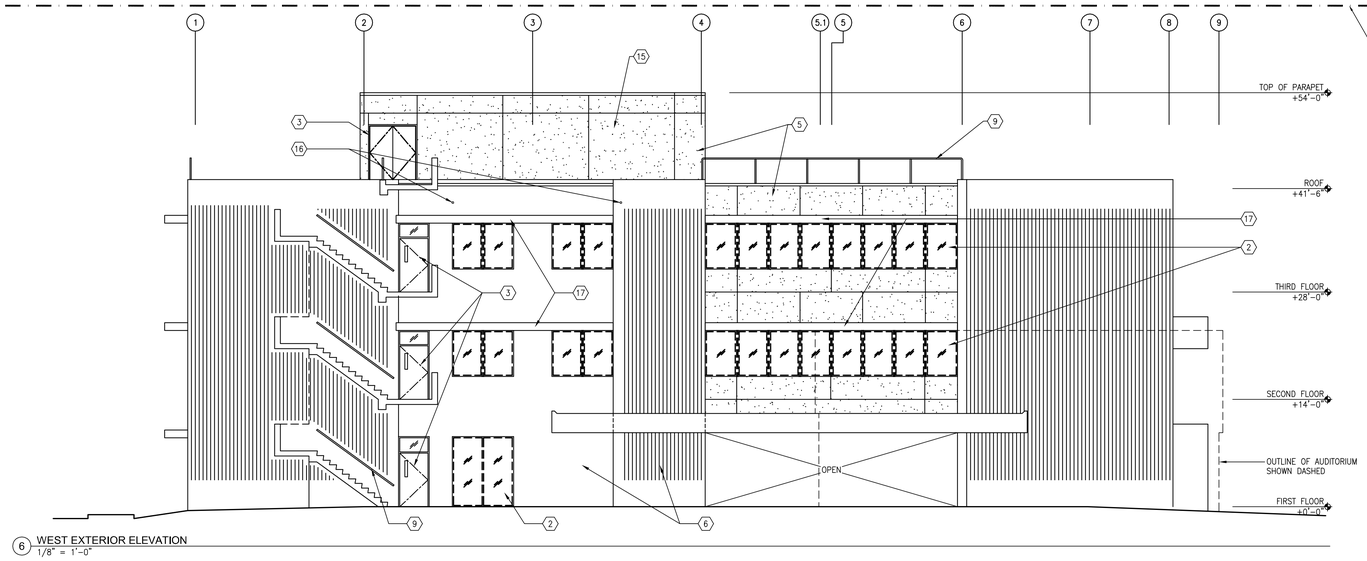

6 WEST EXTERIOR ELEVATION
1/8" = 1'-0"

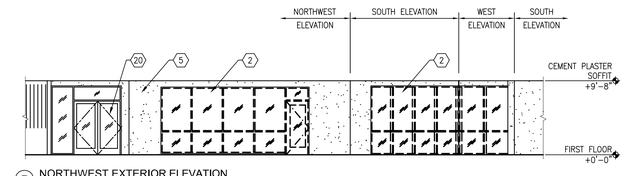

7 NORTHWEST EXTERIOR ELEVATION
1/8" = 1'-0"

Revisions	Date
1	07/25/13

CONSULTANTS:

LICENSED ARCHITECT — STEVEN C. GRIFFIN — No. C-24897 — REN. 07-31-13 — STATE OF CALIFORNIA

ARCHITECT/ENGINEERS:

HMC Architects
1827 E. Fir Avenue, Studio 103 / Fresno, CA 93720
T 559 322 2444 / www.hmcarchitects.com

Drawing Title: DEMOLITION AND PREP EXTERIOR ELEVATIONS

Approved: Project Director

Project Title: BUILDING 24 SEISMIC CORRECTION AND ADDITION

Location: VAMC FRESNO, CA

Date	Checked	Drawn
March 12, 2013	BB	CLO

Project Number: 570-215

Building Number: 24

Drawing Number: AD501

Dwg. 54 of 176

Office of Construction and Facilities Management

Department of Veterans Affairs

VA FORM 08-6231