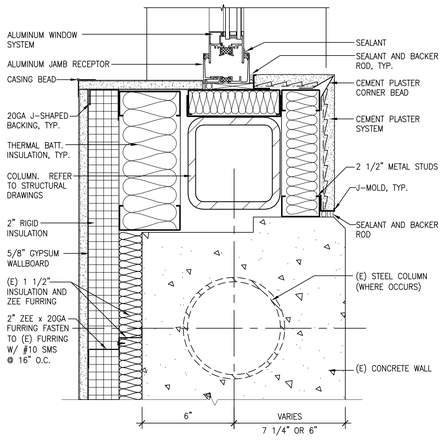

12 **JAMB AT ALUMINUM WINDOWS**
3" = 1'-0"

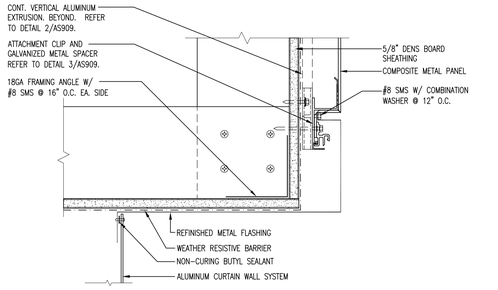

13 **ALUMINUM CURTAIN WALL HEAD FLASHING**
3" = 1'-0"

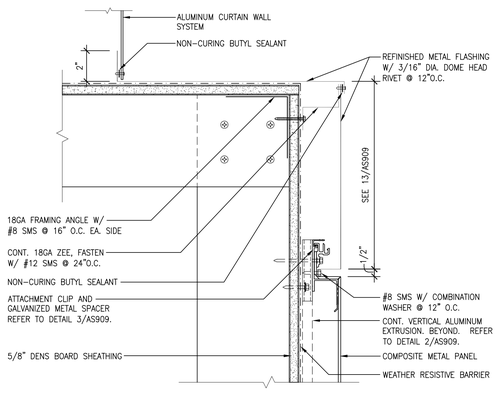

11 **ALUMINUM CURTAIN WALL SILL FLASHING**
3" = 1'-0"

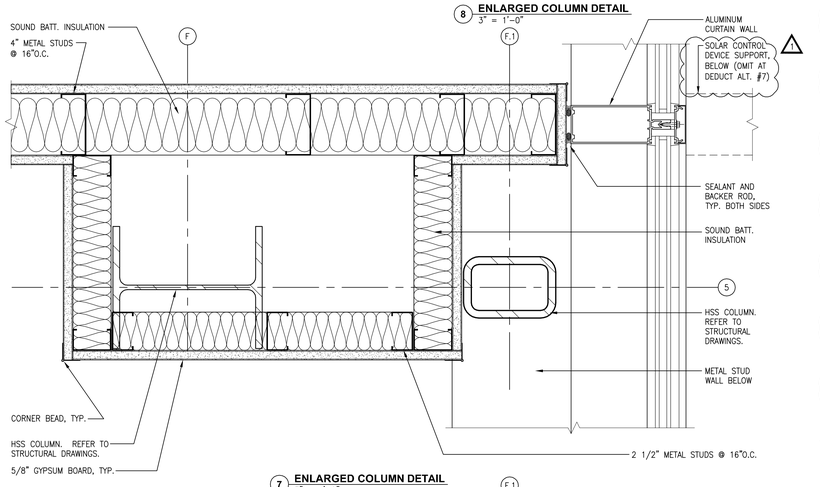

8 **ENLARGED COLUMN DETAIL**
3" = 1'-0"

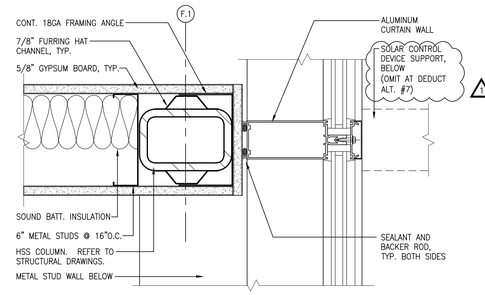

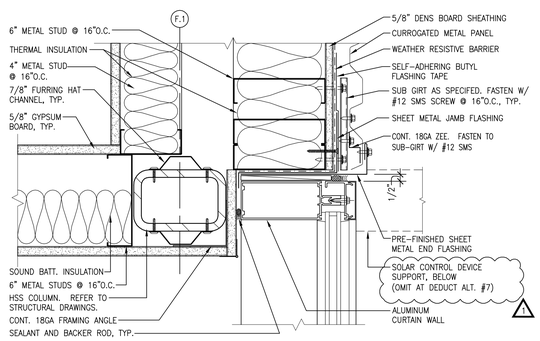

10 **ENLARGED COLUMN DETAIL**
3" = 1'-0"

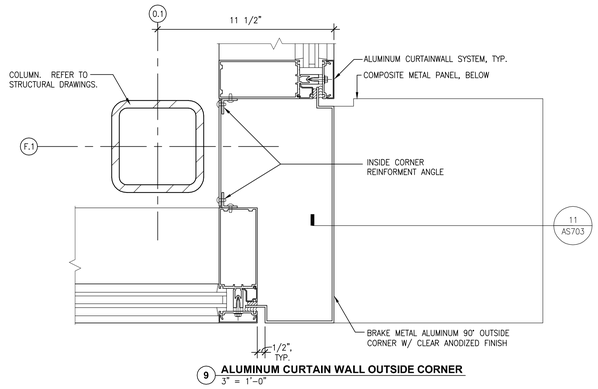

9 **ALUMINUM CURTAIN WALL OUTSIDE CORNER**
3" = 1'-0"

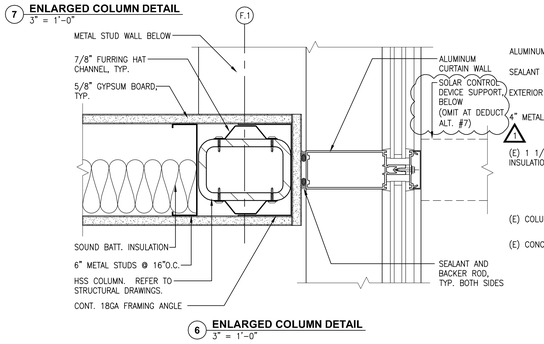

7 **ENLARGED COLUMN DETAIL**
3" = 1'-0"

6 **ENLARGED COLUMN DETAIL**
3" = 1'-0"

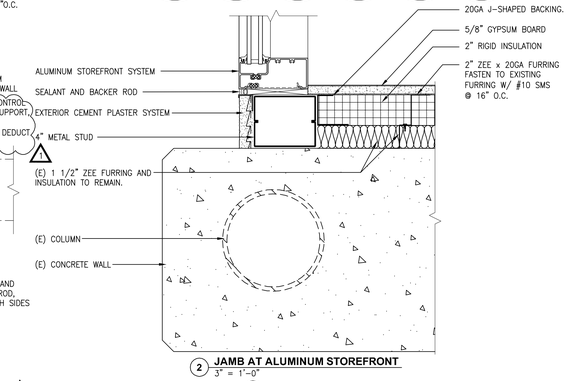

2 **JAMB AT ALUMINUM STOREFRONT**
3" = 1'-0"

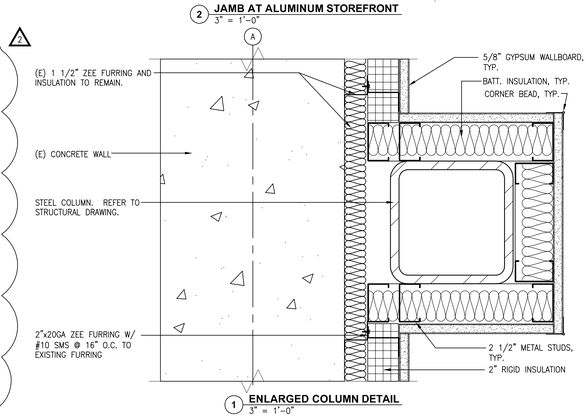

1 **ENLARGED COLUMN DETAIL**
3" = 1'-0"

Revisions:	Date
2	07/22/13
1	07/25/13

CONSULTANTS:

LICENSED ARCHITECT — NO. C-31897 — REN. 07-31-2015 — STATE OF CALIFORNIA

ARCHITECT/ENGINEERS:

HMC Architects
1827 E. Fir Avenue, Studio 103 / Fresno, CA 93720
T 559 322 2444 / www.hmcarchitects.com

Drawing Title: ENLARGED PLAN DETAILS

Approved: Project Director

Project Title: BUILDING 24 SEISMIC CORRECTION AND ADDITION

Location: VAMC FRESNO, CA

Date: March 12, 2013 | Checked: BB | Drawn: CLO

Project Number: 570-215

Building Number: 24

Drawing Number: AS703
Dwg. 65 of 176

Office of Construction and Facilities Management
Department of Veterans Affairs

VA FORM 08-6231