


LEGEND

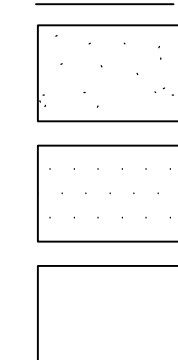

P1

P1 INDICATES FINISH COLOR. REFER TO SCHEDULE FOR FINISHES (09 06 00) FINISH TYPE AND COLOR.


INTERIOR ELEVATION - REMODEL KEYNOTES

- ① NEW RUBBER BASE, TYP. REFER TO FINISH SCHEDULE. (MATCH EXISTING WHERE OCCURS), U.N.O.
- ② NEW SUSPENDED ACT CEILING, TYP. REFER TO CEILING PLAN FOR TYPE.
- ③ NEW ALUMINUM CURTAIN WALL SYSTEM AND GLAZING
- ④ NEW DOOR AND FRAME. SEE FLOOR PLAN AND DOOR SCHEDULE FOR TYPE, TYP.
- ⑤ NEW ALUMINUM WINDOW AND GLAZING. SEE FLOOR PLAN FOR WINDOW TYPE.
- ⑥ STEEL COLUMN, AESS, PAINT. REFER TO STRUCTURAL DRAWINGS.
- ⑦ BRACE FRAME, AESS, PAINT. REFER TO STRUCTURAL DRAWINGS.
- ⑧ NEW ALUMINUM STOREFRONT SYSTEM. SEE FLOOR PLAN FOR WINDOW TYPE.
- ⑨ STEEL BEAM, AESS, PAINT, REFER TO STRUCT. DRAWINGS

{ PROVIDE WARM SHELL SPACE ONLY AT
{ DEDUCT ALTERNATE #8. SEE 2/AS203 }

[illegible]

CONSULTANTS:

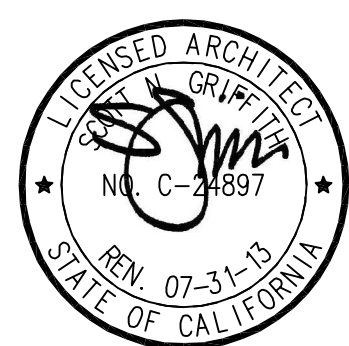

ARCHITECT/ENGINEERS:

HMC Architects

1827 E. Fir Avenue, Studio 103 / Fresno, CA 93720
T 559.322.2444 / www.hmcarchitects.com

Drawing Title
THIRD FLOOR INTERIOR ELEVATIONS

Approved: Project Director

Project Title	BUILDING 24 SEISMIC CORRECTION AND ADDITION
---------------	---------------------------------------------------

VAMC FRESNO, CA

Date
March 12, 2013

Checked
RR

Drawn	CLQ
-------	-----

Project Number	570-215
Building Number	24

Drawing Number
AS806
Dwg 73 of 176

Office of
Construction
and Facilities
Management

