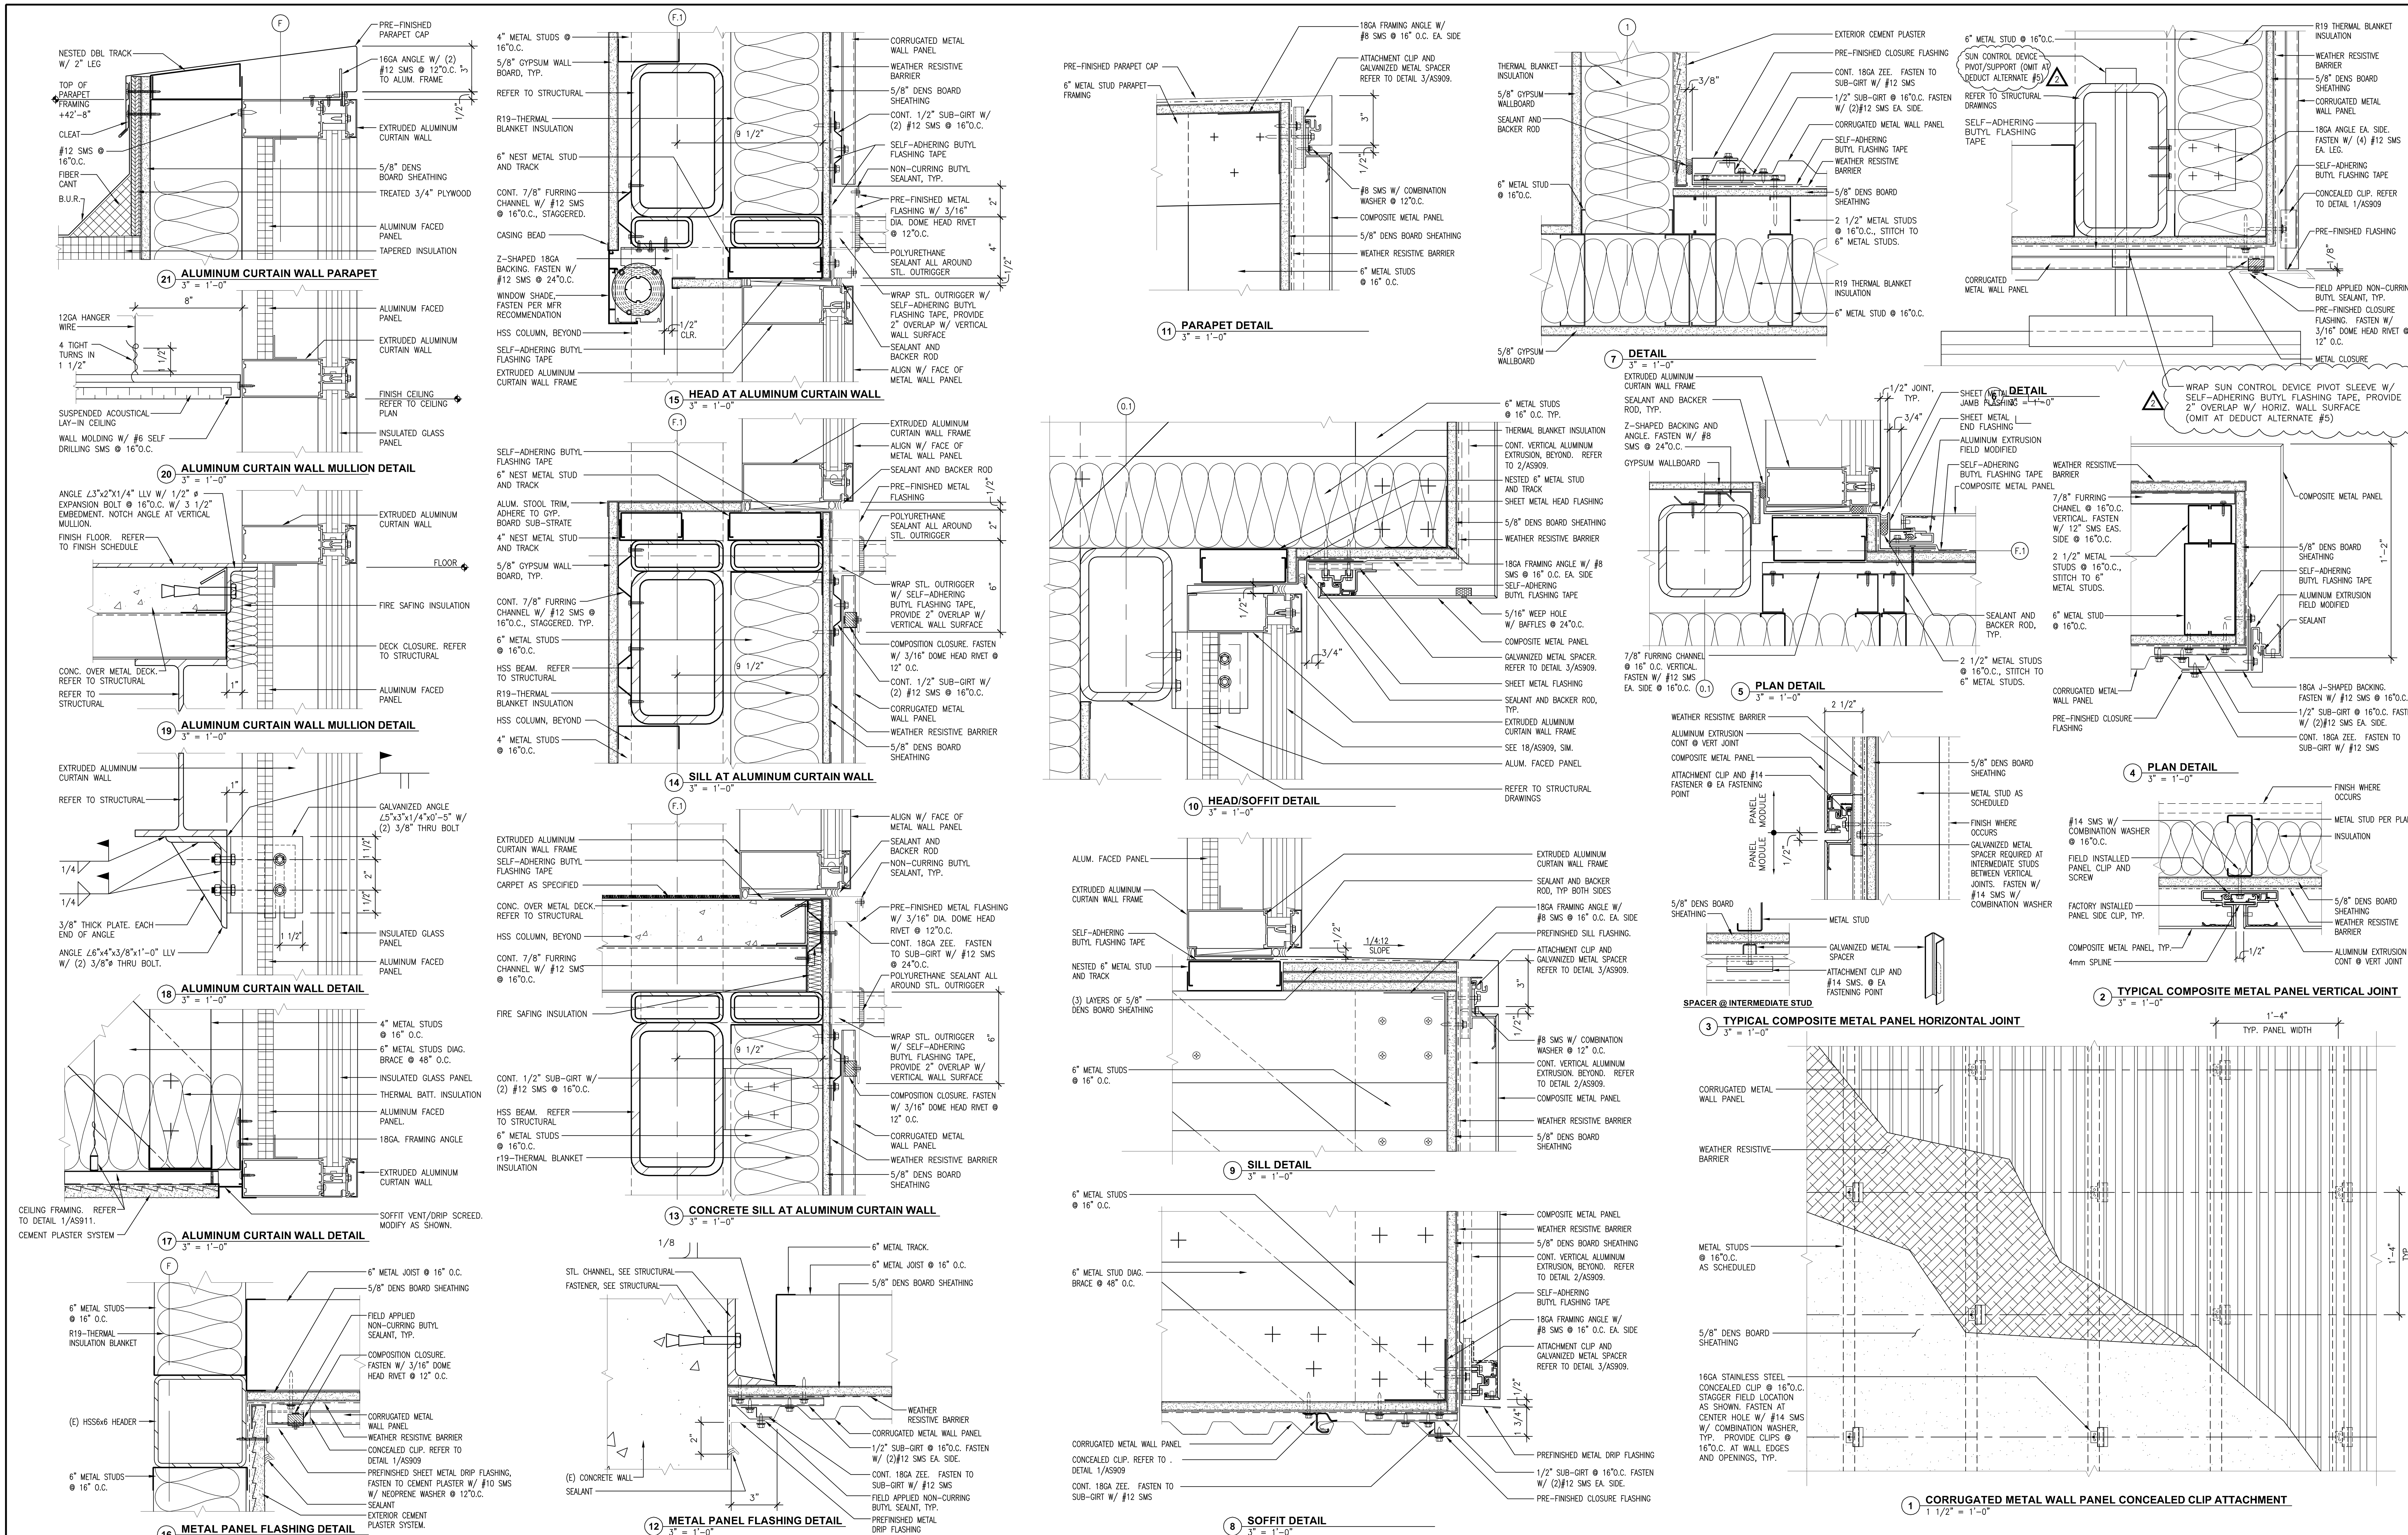

Revisions	Date
△2	07/25/13

CONSULTANTS:

LICENSED ARCHITECT SCOTT A. GRIFFITH NO. C-24897 REN. 07-31-13 STATE OF CALIFORNIA

ARCHITECT/ENGINEERS:

HMC Architects
1827 E. Fir Avenue, Studio 103 / Fresno, CA 93720
T 559 322 2444 / www.hmcarchitects.com

Drawing Title: EXTERIOR DETAILS

Approved: Project Director

Project Title: BUILDING 24 SEISMIC CORRECTION AND ADDITION

Location: VAMC FRESNO, CA

Date: March 12, 2013 | Checked: BB | Drawn: CLO

Project Number: 570-215

Building Number: 24

Drawing Number: AS909

Dwg. 85 of 176

Office of Construction and Facilities Management

Department of Veterans Affairs

VA FORM 08-6231