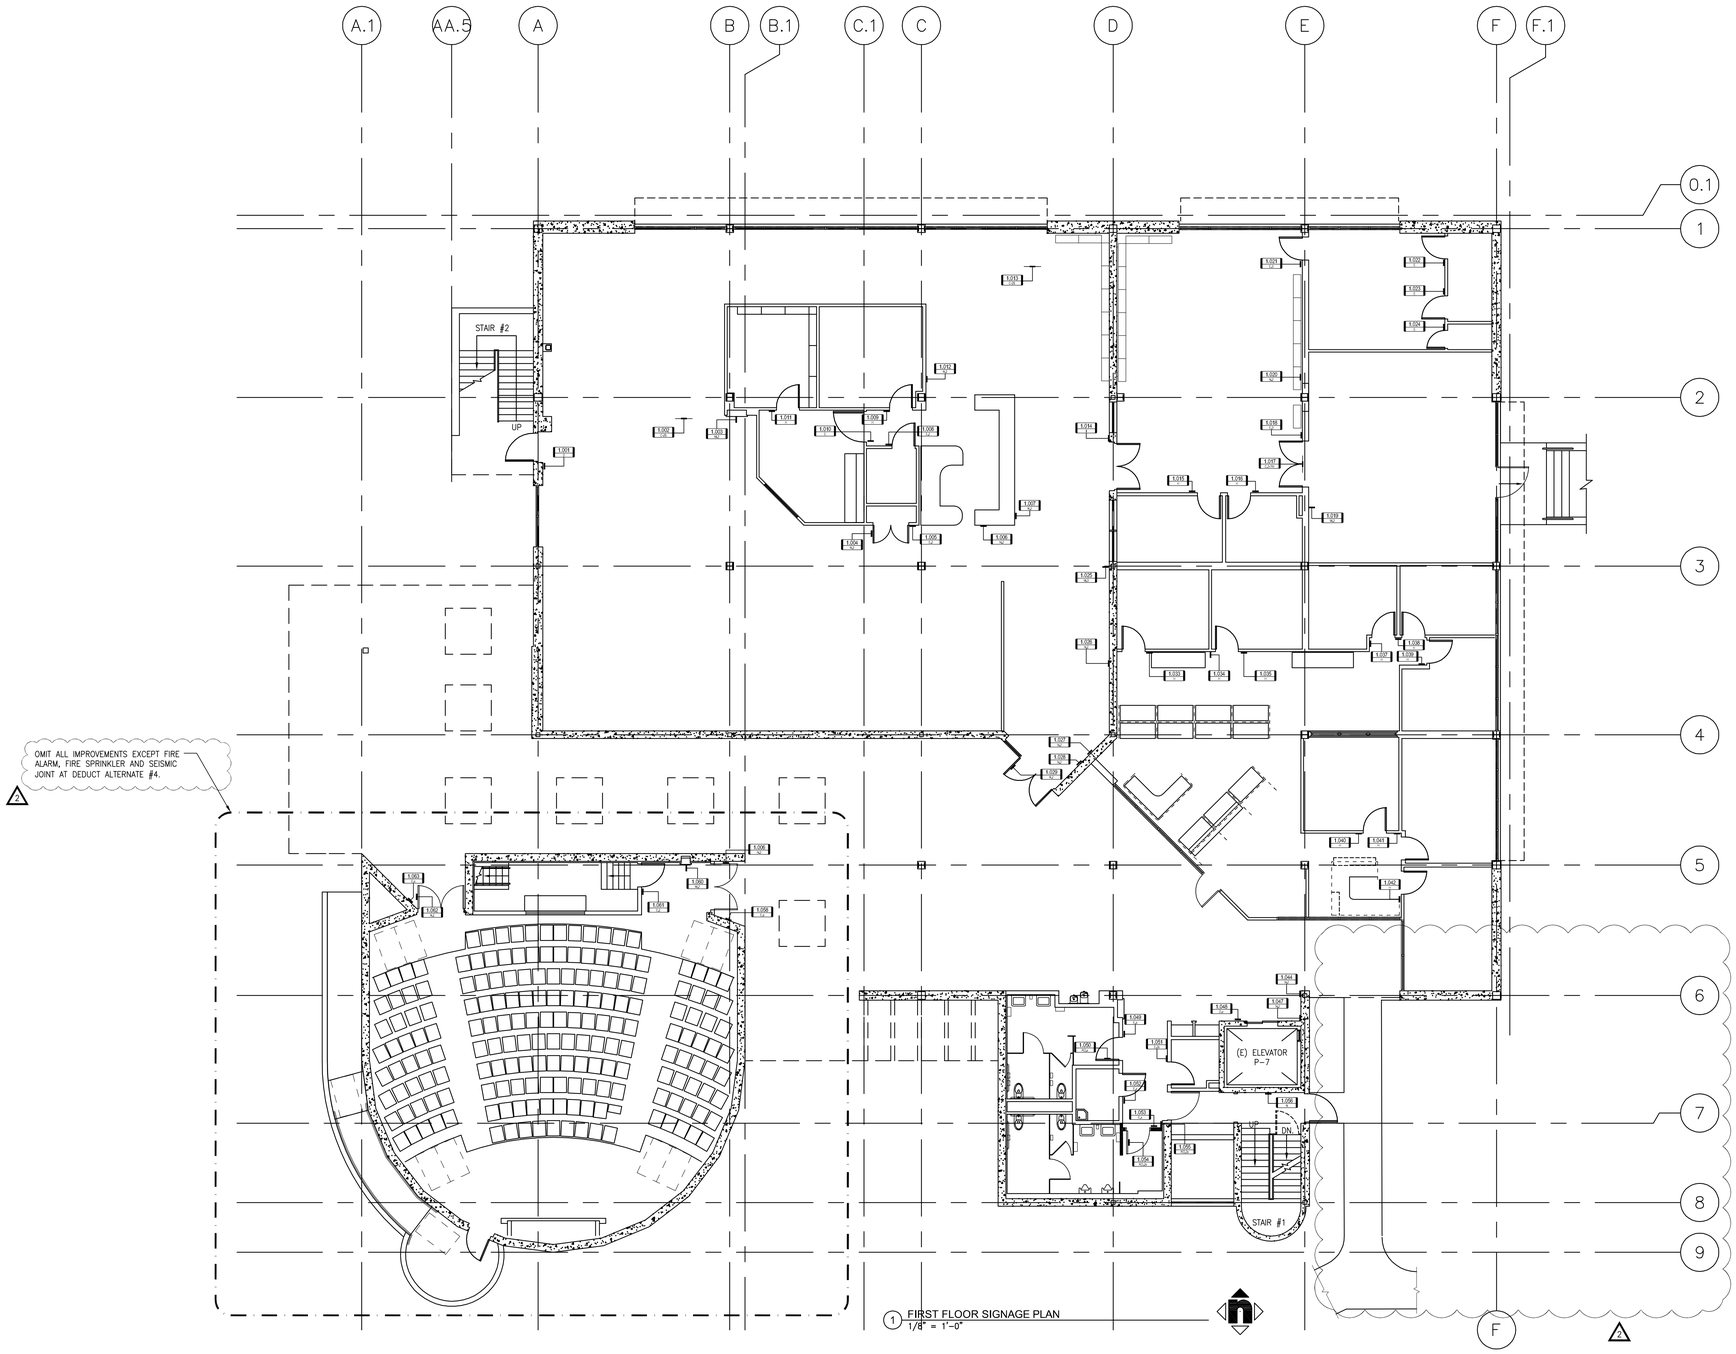

1 FIRST FLOOR SIGNAGE PLAN
1/8" = 1'-0"

SIGNAGE LEGEND
SIGN #
1.001
SIGN TYPE

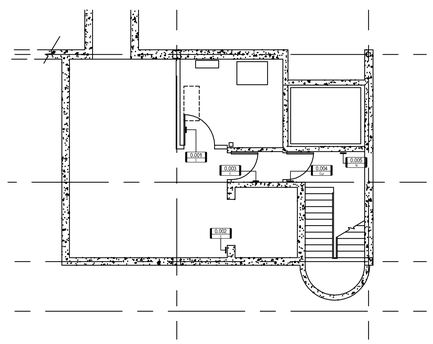

2 BASEMENT FLOOR SIGNAGE PLAN
1/8" = 1'-0"

Revisions:	Date
2	07/25/13

CONSULTANTS:

LICENSED ARCHITECT
SCOTT N. GRIFFITH
NO. C-24897
REN. 07-31-13
STATE OF CALIFORNIA

ARCHITECT/ENGINEERS:

HMC Architects
1827 E. Fir Avenue, Studio 103 / Fresno, CA 93720
T 559 322 2444 / www.hmcarchitects.com

Drawing Title: FIRST FLOOR SIGNAGE PLAN

Approved: Project Director

Project Title: BUILDING 24 SEISMIC CORRECTION AND ADDITION

Location: VAMC FRESNO, CA

Date	Checked	Drawn
March 12, 2013	BB	CLO

Project Number: 570-215

Building Number: 24

Drawing Number: AS913

Dwg. 89 of 176

Office of Construction and Facilities Management

Department of Veterans Affairs

VA FORM 08-6231